




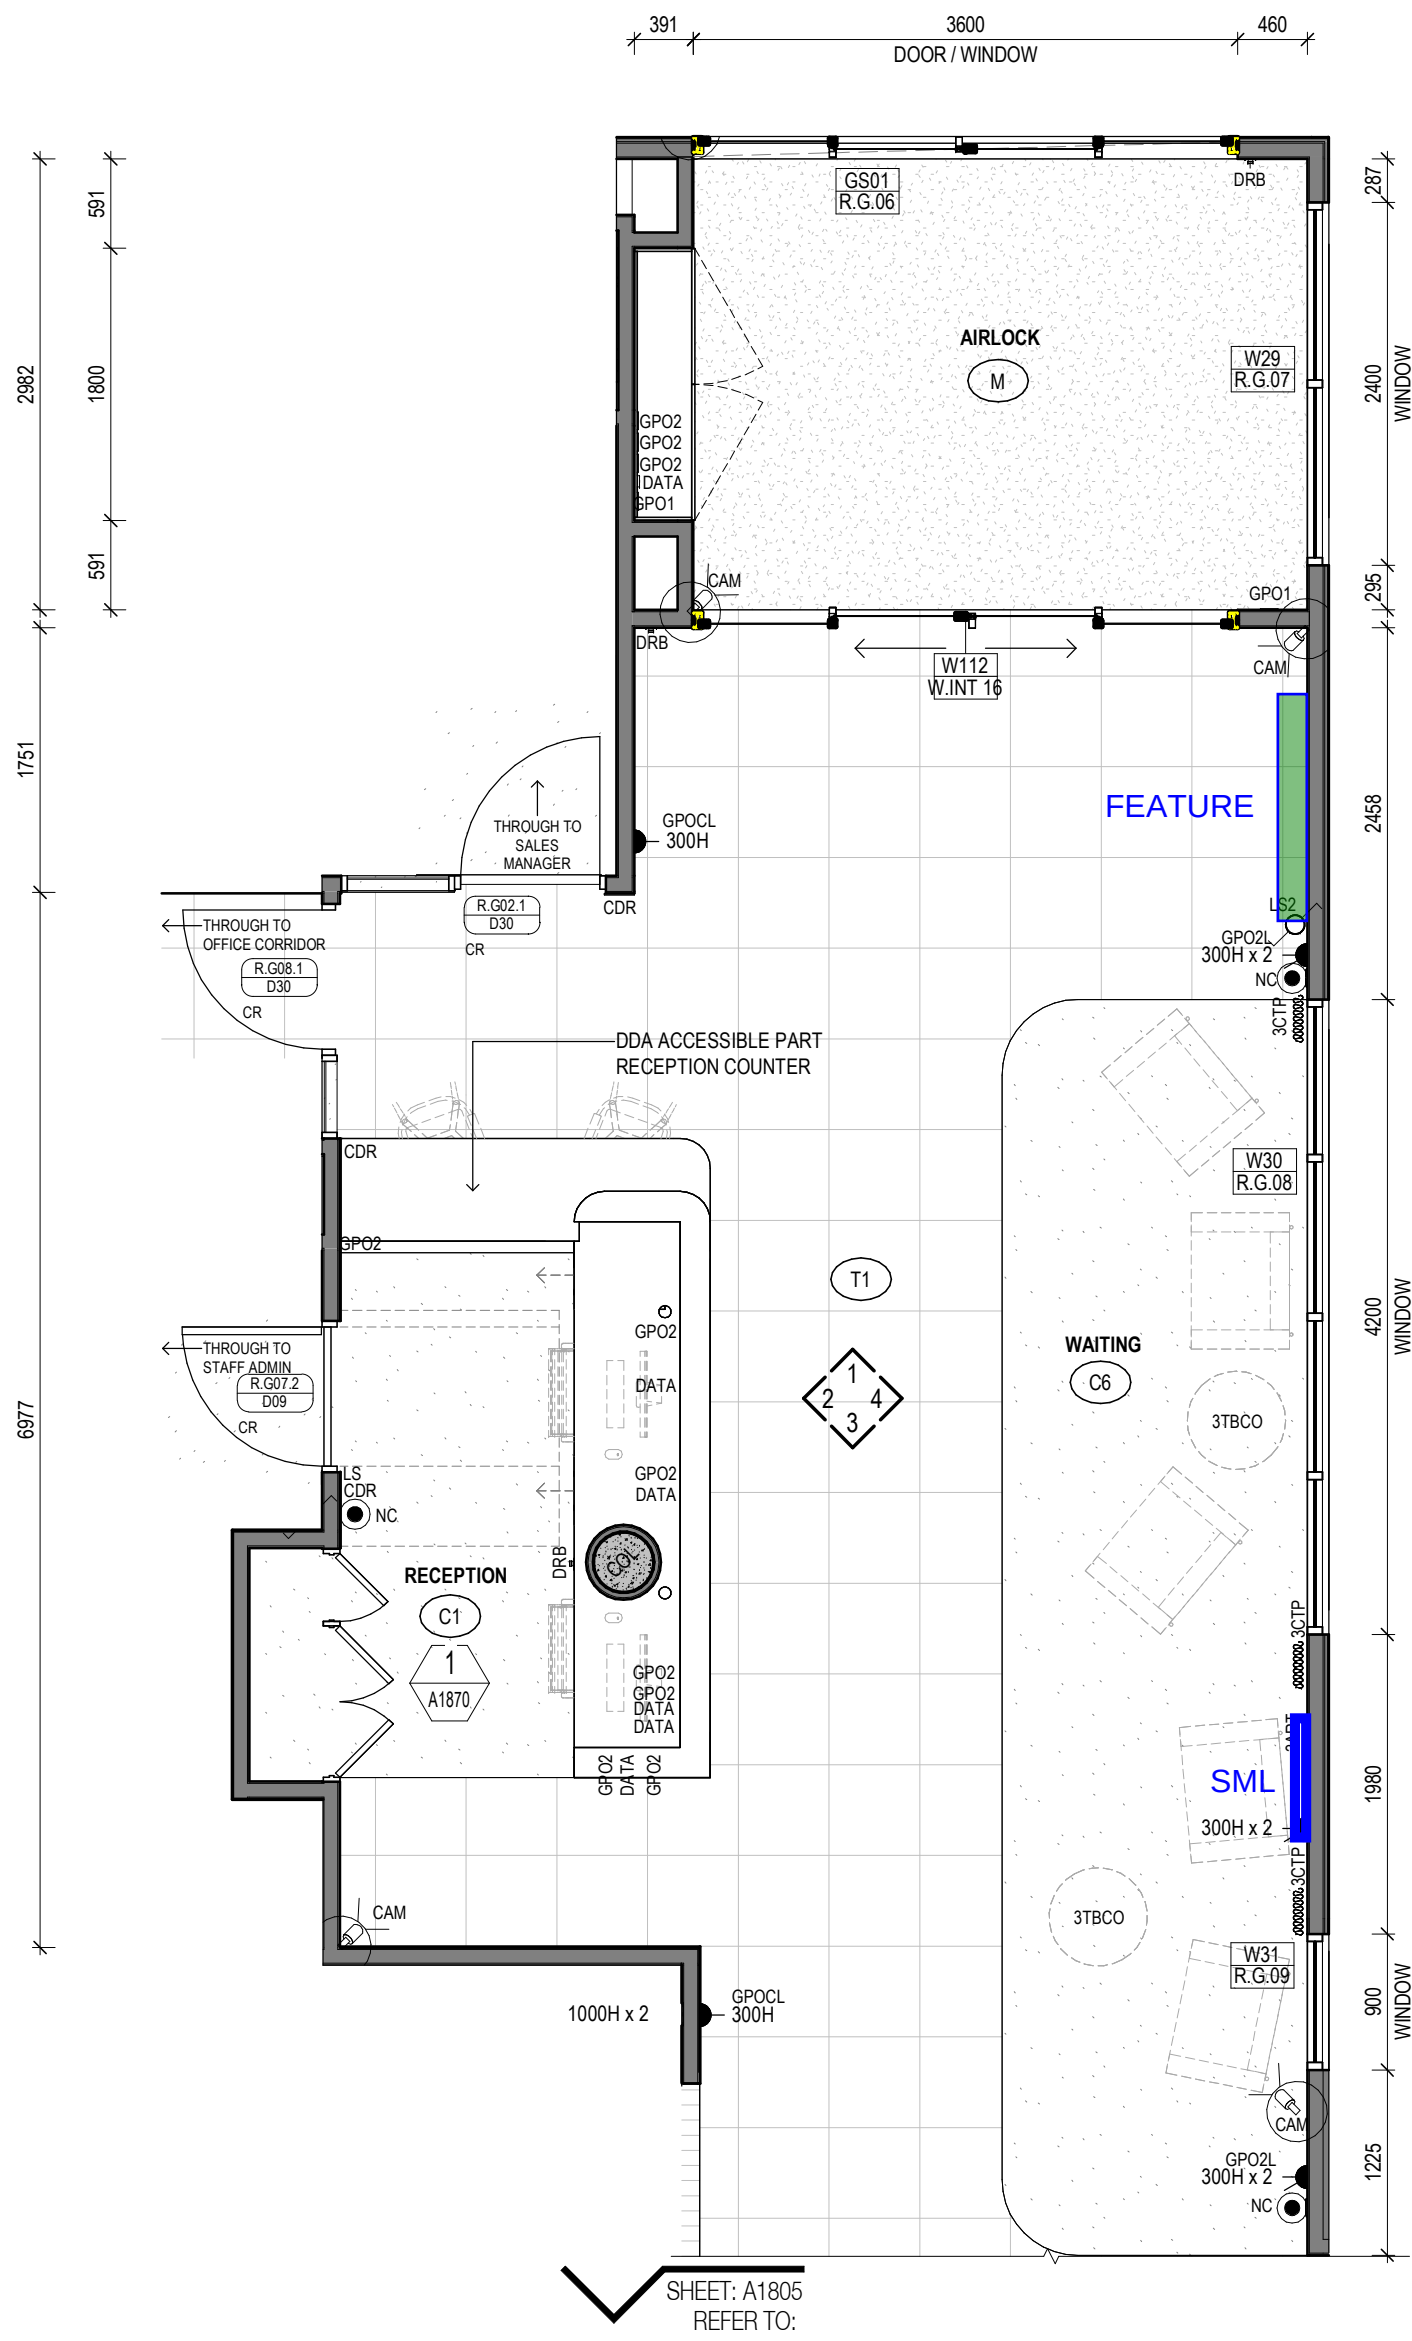


1 VILLAGE ARRIVALS - AIRLOCK, RECEPTION, LOBBY & WAITING
Scale 1 : 50

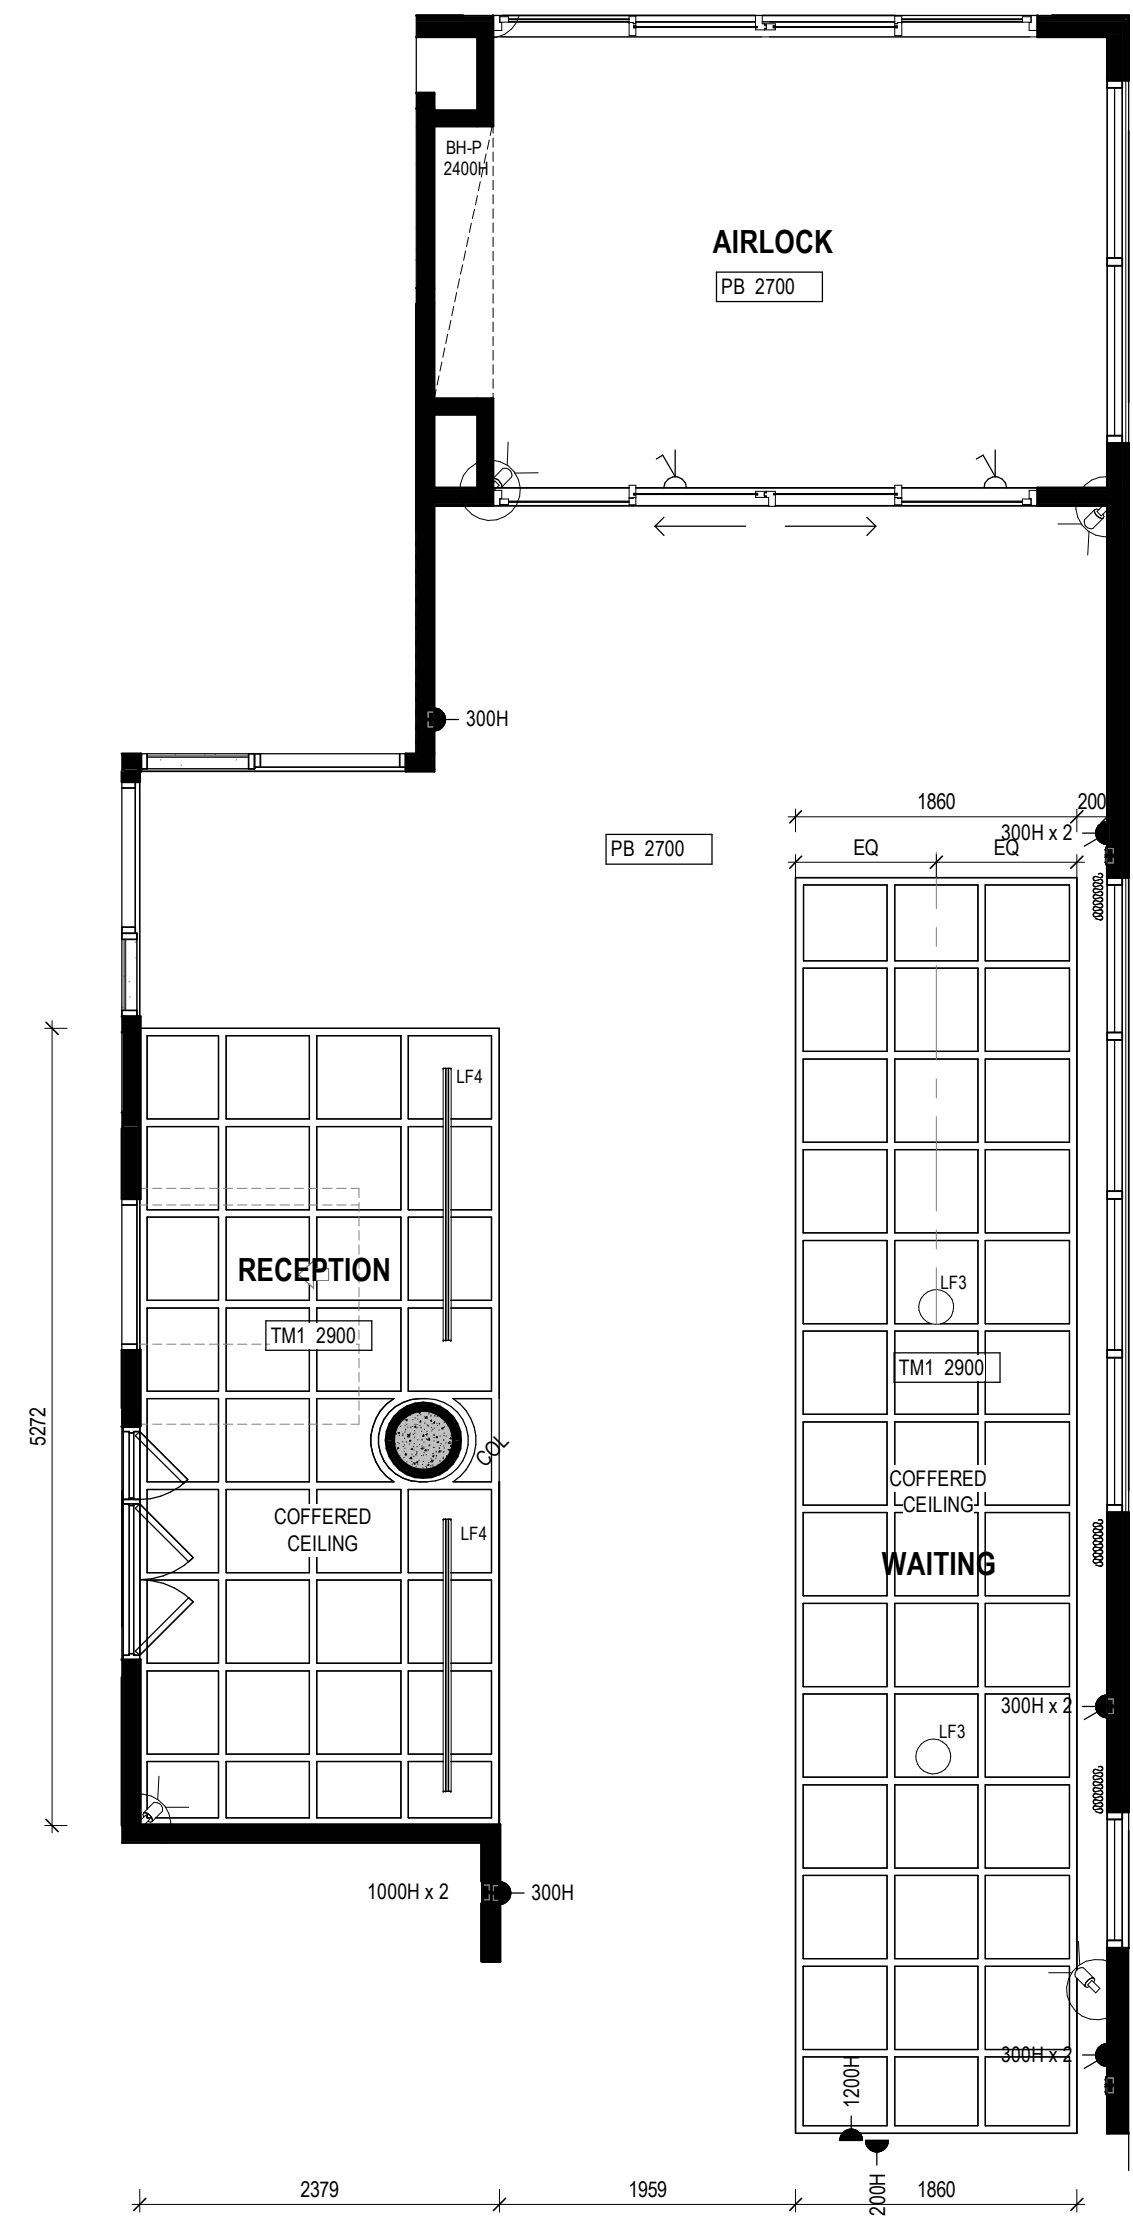


2 RCP - VILLAGE ARRIVALS - AIRLOCK, RECEPTION, LOBBY & WAITING
Scale 1 : 50

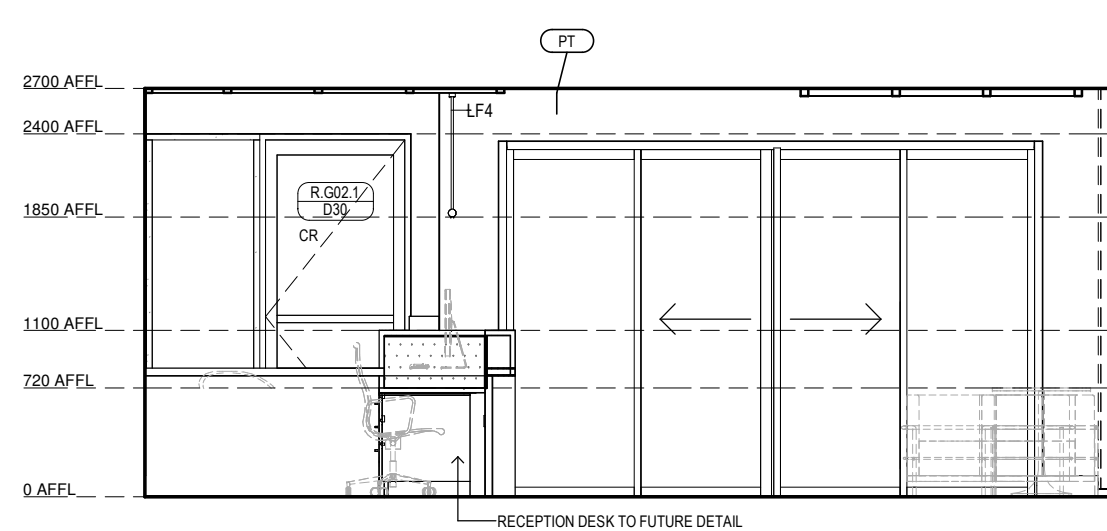


AIRLOCK, RECEPTION, LOBBY & WAITING ELEVATION 1
Scale 1 : 50

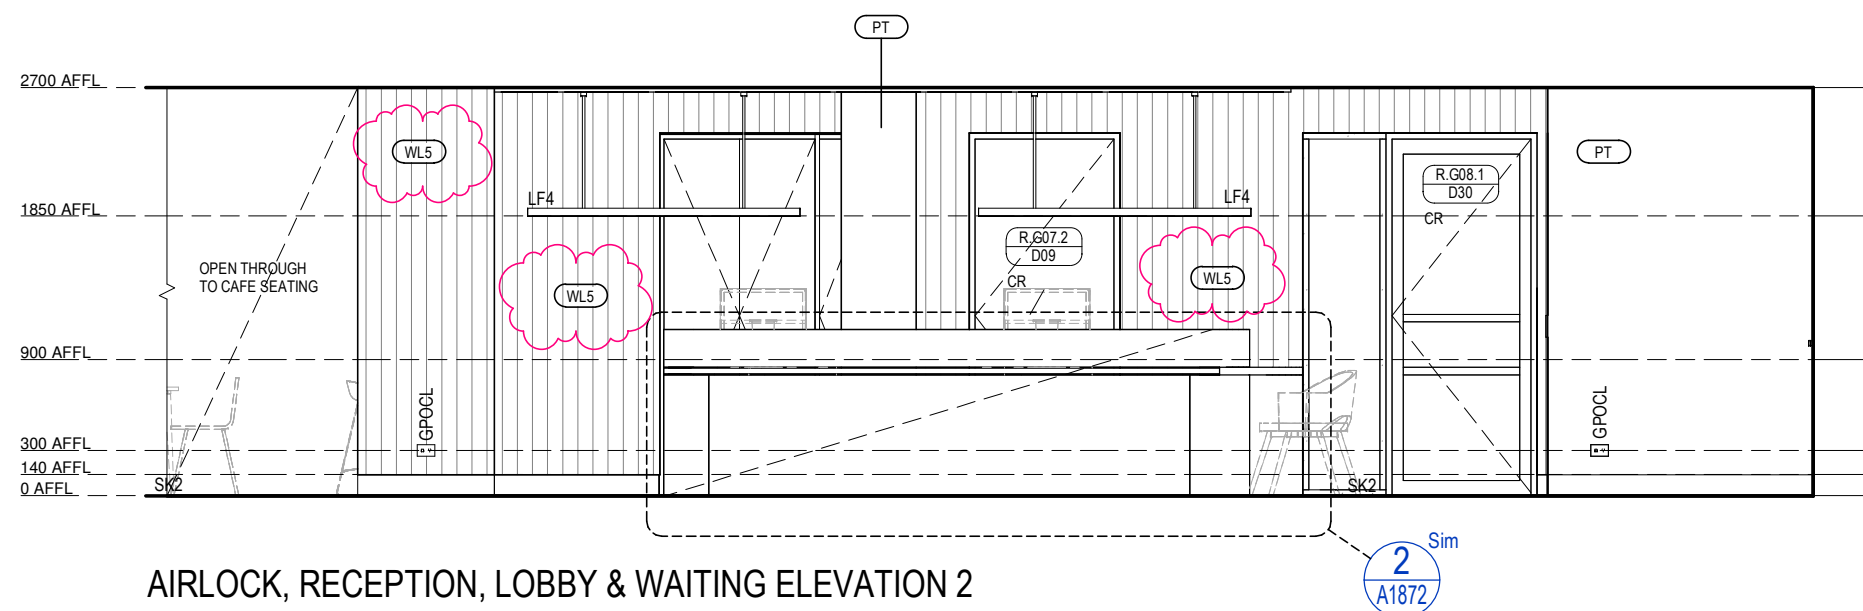

AIRLOCK, RECEPTION, LOBBY & WAITING ELEVATION 2
Scale 1 : 50

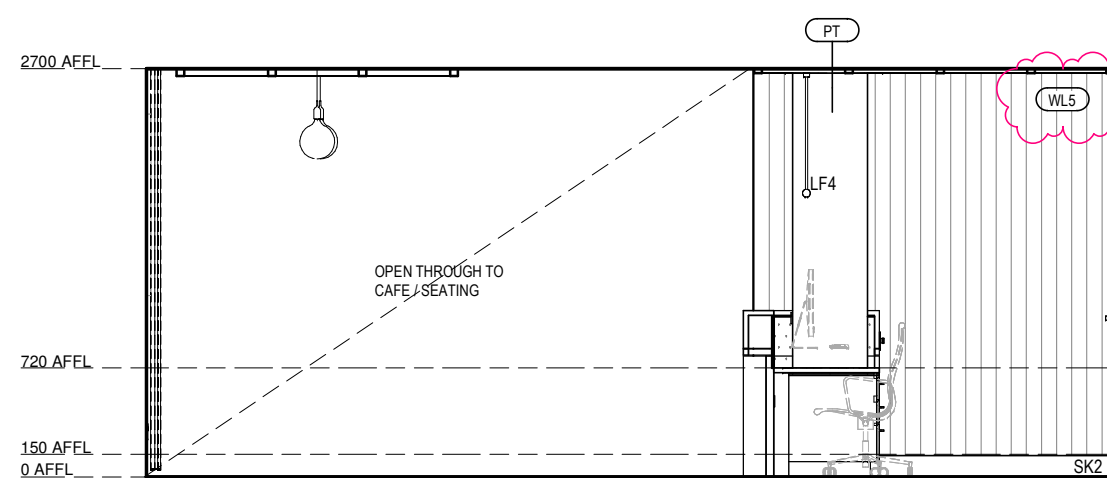

AIRLOCK, RECEPTION, LOBBY & WAITING ELEVATION 3
Scale 1 : 50

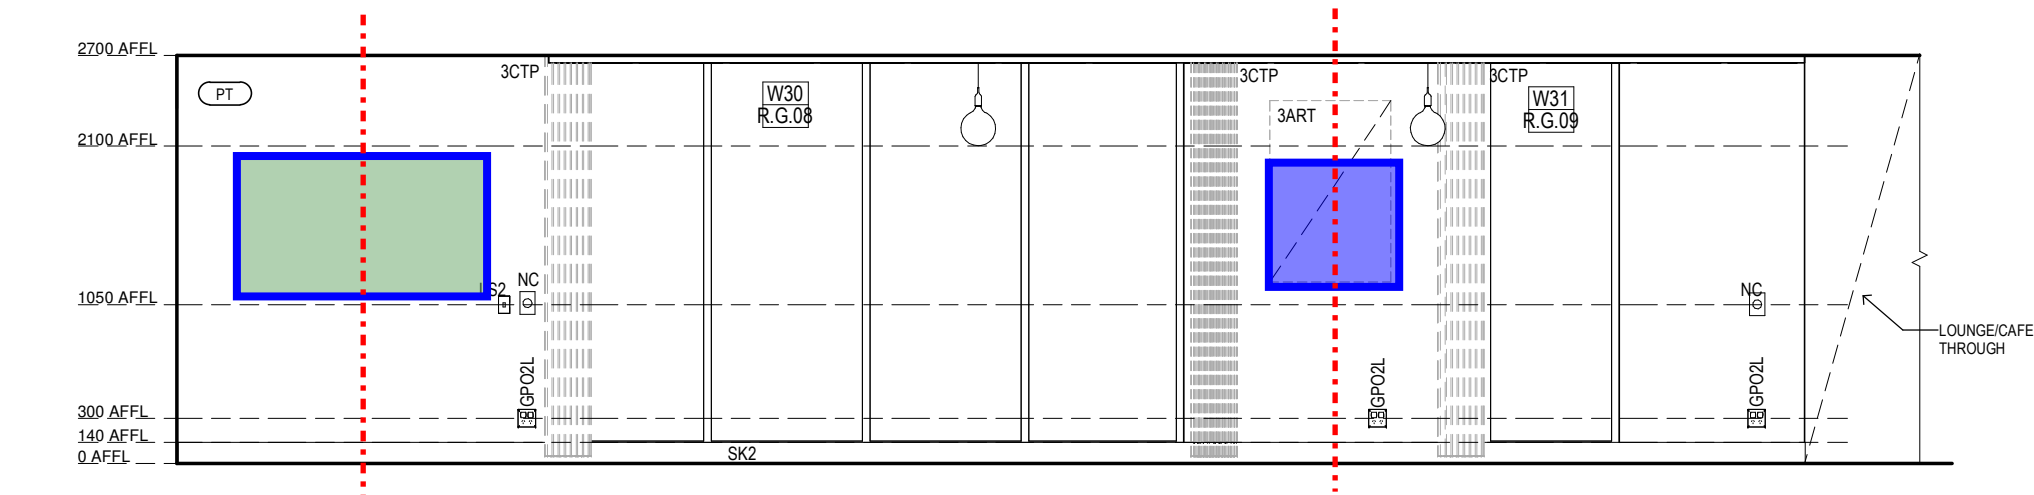

AIRLOCK, RECEPTION, LOBBY & WAITING ELEVATION 4
Scale 1 : 50

SMG ARTWORK ALLOWANCE
MARKUP
03/10/25

ALL ARTWORKS TO BE
INSTALLED 1500mm FFL UNLESS
OTHERWISE STATED

Legend - Internal Elevations

DRAWINGS TO BE READ IN CONJUNCTION WITH ARCHITECTURAL SPECIFICATION & MATERIALS, PRODUCTS & FINISHES SCHEDULE.

PT# PAINT FINISH TO ALL WALLS WITHIN NEW & AFFECTED ROOMS/ AREAS UNLESS OTHERWISE SHOWN

CSE	CONCRETE SEALER
DPR	DOOR PROTECTION
GD	GRAPHIC FILM
LM	LAMINATE
MI	MIRROR
PBD	PINBOARD
PT	PAINT FINISH
REN	RENDER FINISH
SB	SPLASHBACK
STN	STONE
WB	WHITEBOARD
WP	WALL PROTECTION
WT	WALL TILE
WV	WALL VINYL

NOTES:
1. LAMINATE CARCASS FOR ALL VISIBLE OPEN SHELVING, UNLESS OTHERWISE NOTED
2. MELAMINETO ALL INTERNAL CARCASS OF JOINERY, UNLESS OTHERWISE NOTED.

Legend - Floor Finishes

C	CARPET
CO	CONCRETE
D	DECKING
E	EPOXY FINISH
L	LINOLEUM
M	MATTING
PF	PARTICLEBOARD FLOORING
PU	PAVING UNIT - TBC WITH LANDSCAPE
PW	PLYWOOD
R	RUBBER FLOORING
T	TILING
TF	TIMBER FLOORING
V	VINYL

Keynote Legend

3ART	ARTWORK - GROUP 3
3CTP	CURTAINS - GROUP 3
3TBCO	COFFEE TABLE - GROUP 3
BH-P	BULKHEAD - PLASTERBOARD TYPE
CAM	CCTV CAMERA
CDR	CARD READER
COL	COLUMN
DATA	DATA OUTLET
DRB	DOOR RELEASE BUTTON
GPO1	POWER OUTLET - SINGLE
GPO2	POWER OUTLET - DOUBLE
GPO2L	POWER OUTLET - DOUBLE - LARGE PLATE
GPOCL	POWER OUTLET - CLEANERS
LF3	LIGHT FITTING - TYPE 3
LF4	LIGHT FITTING - TYPE 4
LS	LIGHT SWITCH
LS2	LIGHT SWITCH - TWO WAY
NC	NURSE CALL
SK2	SKIRTING - TYPE 2

Feature Artwork

Standard Artwork

X-SML	X-Small - 600 x 600
SML	Small - 900 x 900
MED	Medium - 1200 x 800
LRG	Large - 1500x 800
XLG	X-Large - 1800 x 800

PRELIMINARY

Revision/Issue	Date
a Issued for Coordination - 100% DD	2024.04.12
P1 Consolidated Set-to-date / SMG Comments	2025.08.15
P2 Tender Pack Issue	2025.09.05

Clarke
Hopkins
Clarke

ClarkeHopkinsClarke
Melbourne
L9, Melbourne Connect
700 Swanston Street
Carlton Victoria 3053
Telephone (03) 9419 4340
Email studio@chc.com.au
www.chc.com.au

Sydney
3/78 Campbell Street
Sunny Hills NSW 2010
Telephone (02) 9221 9200
Email studio@chc.com.au
www.chc.com.au

Scale	As indicated @ A1
Date	01/03/2024
Drawn	ELRM
Architect	EL


Project
Summerset Oakleigh
52 Golf Road, Oakleigh South, VIC

Drawing
Internal Elevations - Village Arrivals -
Airlock, Lobby & Reception

Drawing No.


230185/A1801

P2

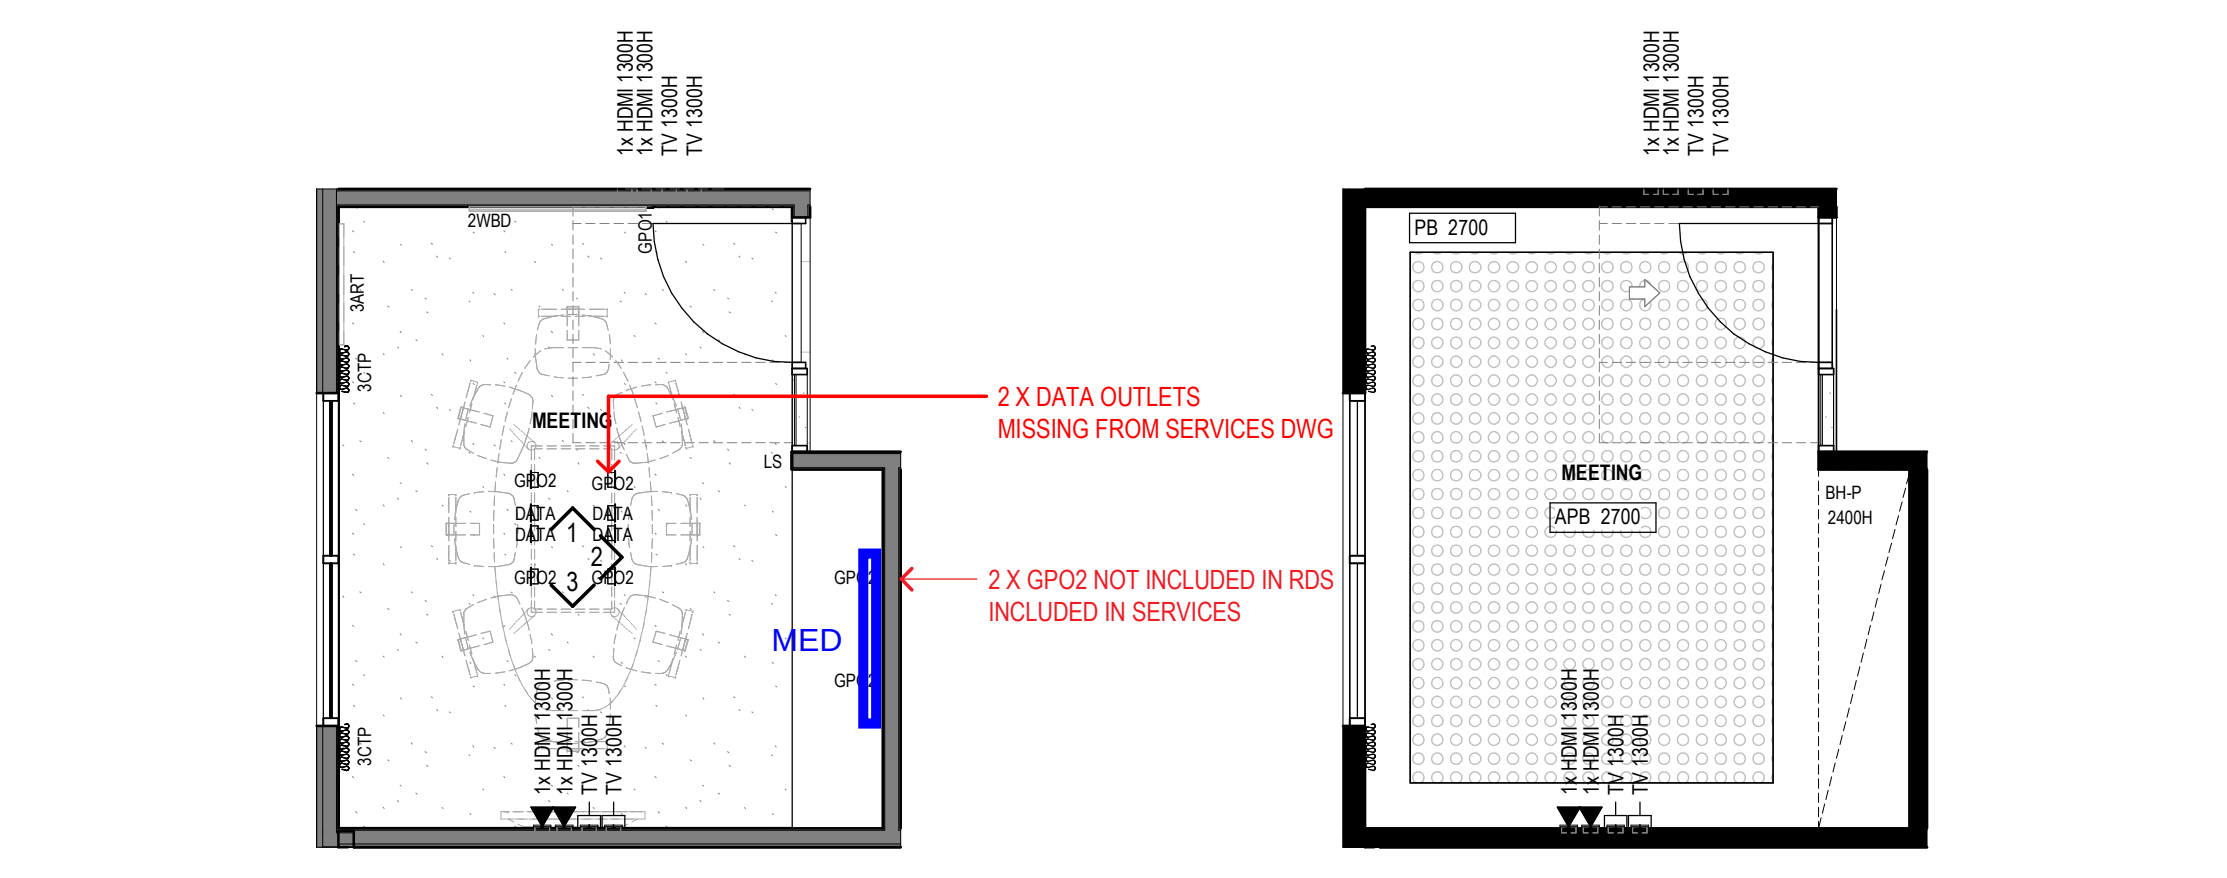


1 VILLAGE ADMIN - MEETING
Scale 1 : 50

2 RCP - VILLAGE ADMIN - MEETING
Scale 1 : 50

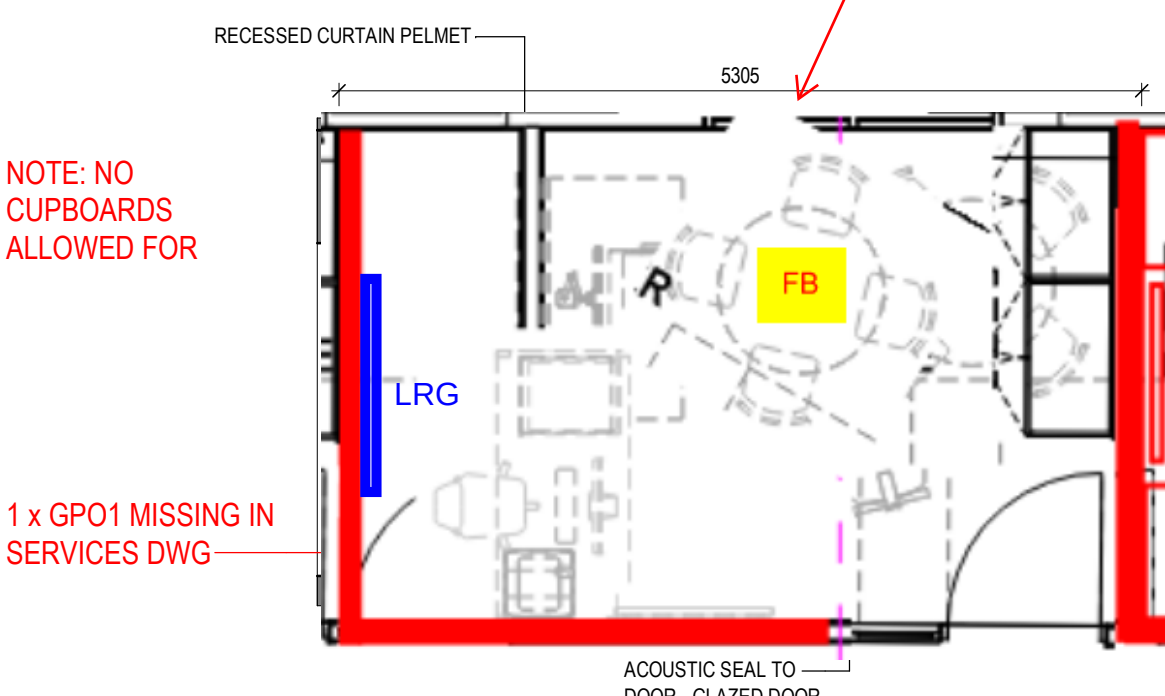


3 VILLAGE ADMIN - VILLAGE MANAGER
Scale 1 : 50

4 RCP - VILLAGE ADMIN - VILLAGE MANAGER
Scale 1 : 50

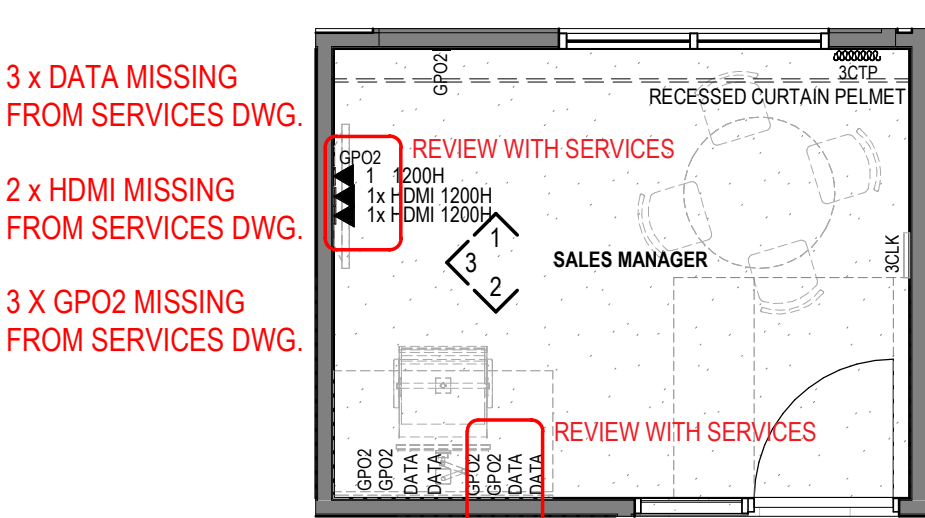


5 VILLAGE ADMIN - SALES MANAGER
Scale 1 : 50

6 RCP - VILLAGE ADMIN - SALES MANAGER
Scale 1 : 50

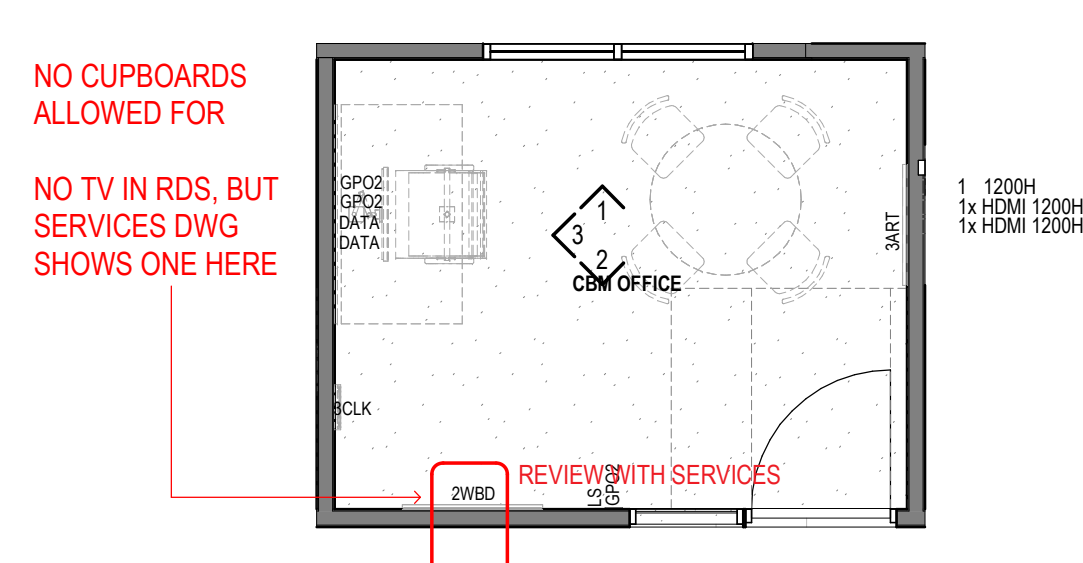


7 VILLAGE ADMIN - CBM OFFICE
Scale 1 : 50


8 RCP - VILLAGE ADMIN - CBM OFFICE
Scale 1 : 50

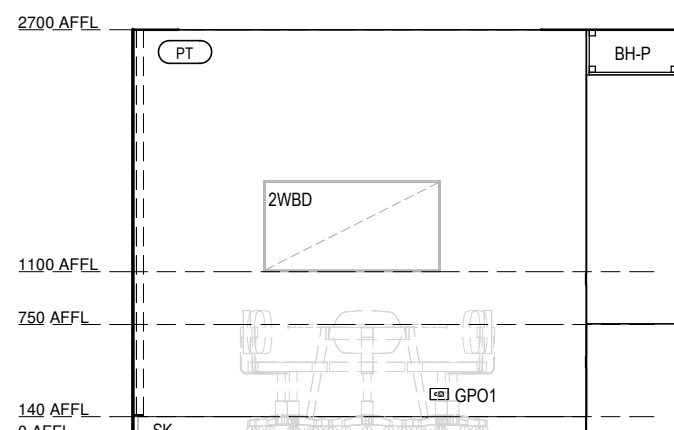


VILLAGE ADMIN - MEETING - ELEVATION 1
Scale 1 : 50

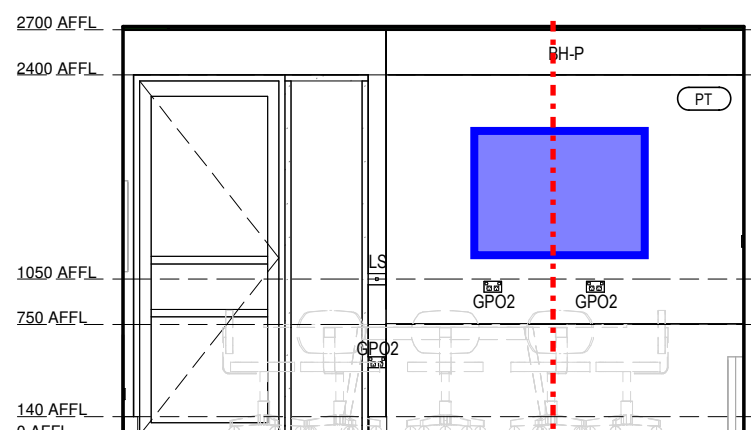


VILLAGE ADMIN - MEETING - ELEVATION 2
Scale 1 : 50

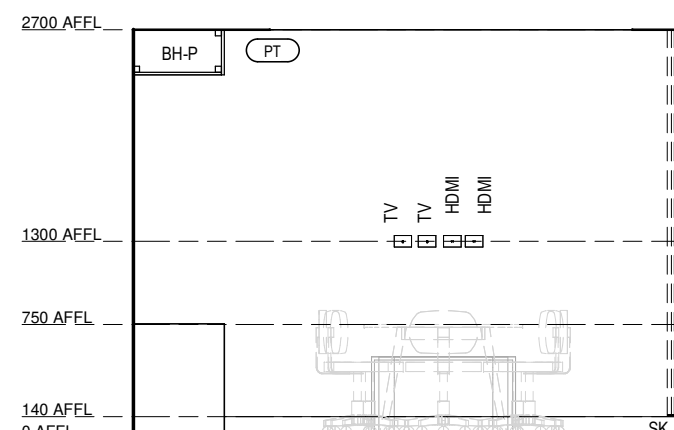


VILLAGE ADMIN - MEETING - ELEVATION 3
Scale 1 : 50

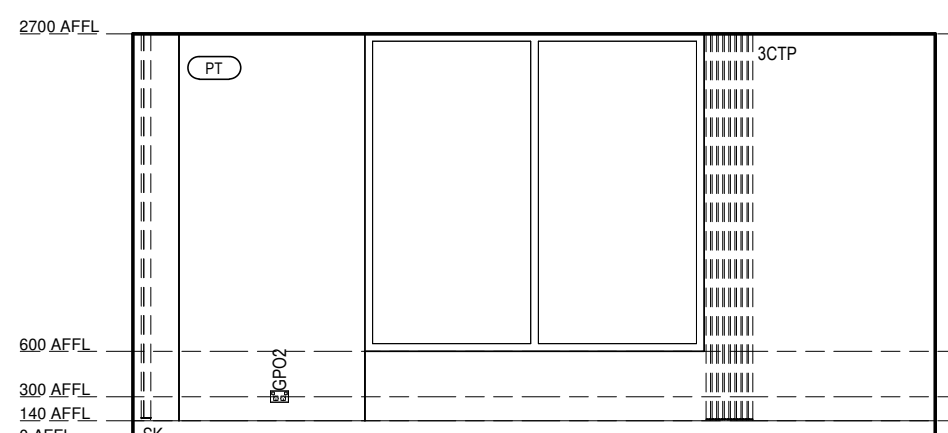


VILLAGE ADMIN - VILLAGE MANAGER ELEVATION 1
Scale 1 : 50

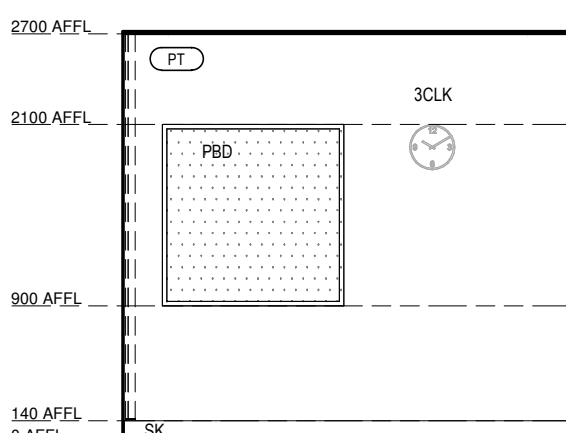


VILLAGE ADMIN - VILLAGE MANAGER ELEVATION 2
Scale 1 : 50

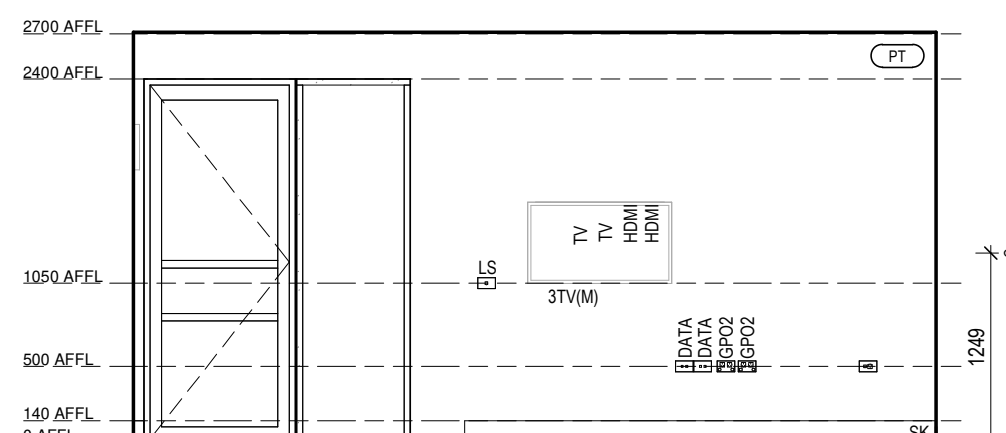


VILLAGE ADMIN - VILLAGE MANAGER ELEVATION 3
Scale 1 : 50

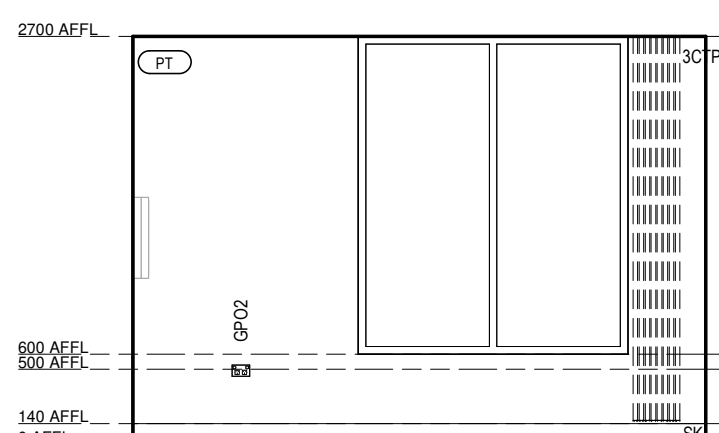


VILLAGE ADMIN - SALES MANAGER ELEVATION 1
Scale 1 : 50

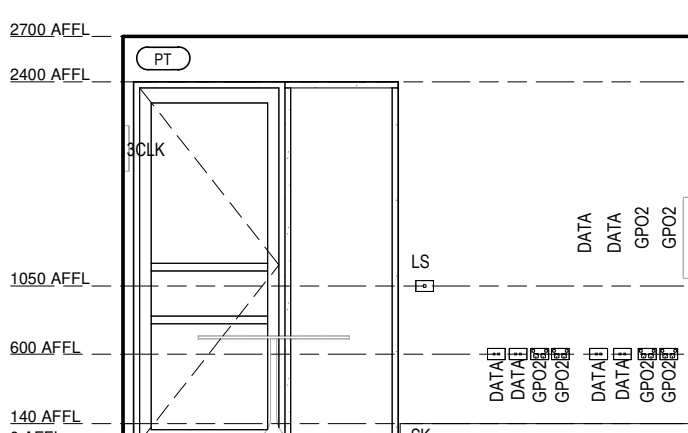


VILLAGE ADMIN - SALES MANAGER ELEVATION 3
Scale 1 : 50

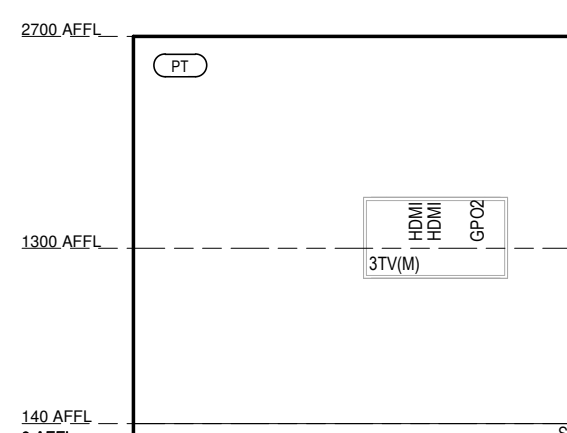


VILLAGE ADMIN - SALES MANAGER ELEVATION 4
Scale 1 : 50

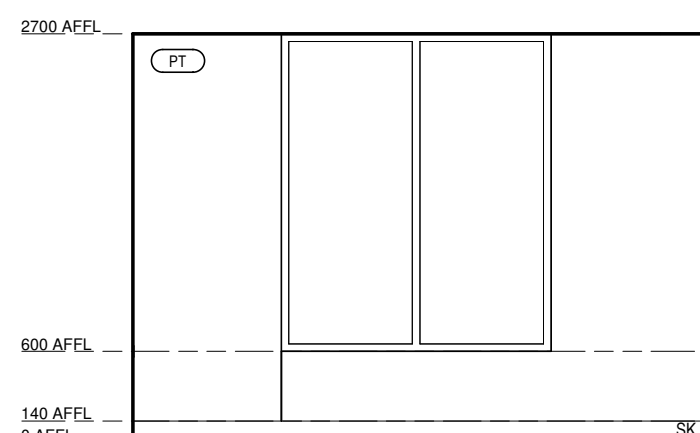

VILLAGE ADMIN - CBM OFFICE ELEVATION 1
Scale 1 : 50

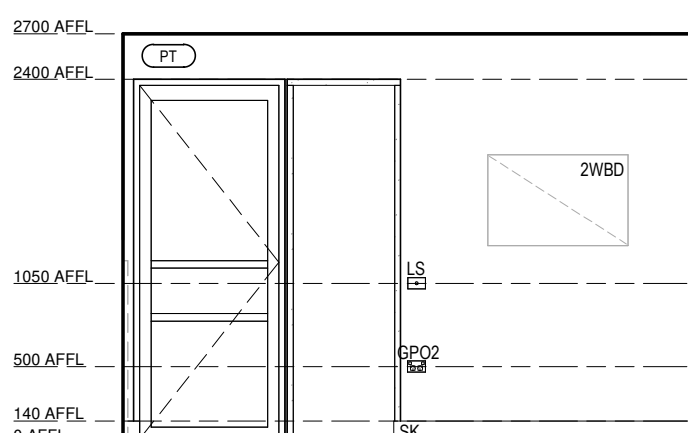

VILLAGE ADMIN - CBM OFFICE ELEVATION 3
Scale 1 : 50

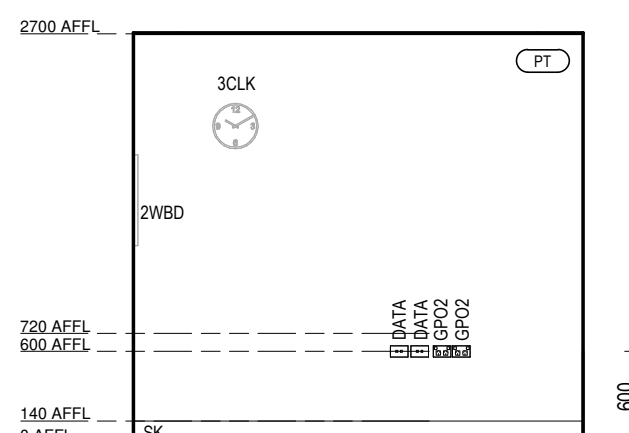

VILLAGE ADMIN - CBM OFFICE ELEVATION 4
Scale 1 : 50

Legend - Internal Elevations

DRAWINGS TO BE READ IN CONJUNCTION WITH ARCHITECTURAL SPECIFICATION & MATERIALS, PRODUCTS & FINISHES SCHEDULE.

PT# PAINT FINISH TO ALL WALLS WITHIN NEW & AFFECTED ROOMS/ AREAS UNLESS OTHERWISE SHOWN

CSE	CONCRETE SEALER
DPR	DOOR PROTECTION
GD	GRAPHIC FILM
LM	LAMINATE
MI	MIRROR
PBD	PINBOARD
PT	PAINT FINISH
REN	RENDER FINISH
SB	SPLASHBACK
STN	STONE
WB	WHITEBOARD
WP	WALL PROTECTION
WT	WALL TILE
WV	WALL VINYL

NOTES:
1. LAMINATE CARCASS FOR ALL VISIBLE OPEN SHELVING, UNLESS OTHERWISE NOTED
2. MELAMINETO ALL INTERNAL CARCASS OF JOINERY, UNLESS OTHERWISE NOTED.

Legend - Floor Finishes

C	CARPET
CO	CONCRETE
D	DECKING
E	EPOXY FINISH
L	LINOLEUM
M	MATTING
PF	PARTICLEBOARD FLOORING
PU	PAVING UNIT - TBC WITH LANDSCAPE
PW	PLYWOOD
R	RUBBER FLOORING
T	TILING
TF	TIMBER FLOORING
V	VINYL

Keynote Legend

2WB	WHITEBOARD - GROUP 2
3ART	ARTWORK - GROUP 3
3BN	WASTE BIN - GROUP 3
3CLK	CLOCK - GROUP 3
3CTP	CURTAINS - GROUP 3
3TV(M)	TELEVISION SCREEN 55 INCH - GROUP 3
BHP	BULKHEAD - PLASTERBOARD TYPE
DATA	DATA OUTLET
GPO1	POWER OUTLET - SINGLE
GPO2	POWER OUTLET - DOUBLE
HDMI	HDMI OUTLET
LS	LIGHT SWITCH
PBD	PINBOARD - FRAMED
SK	SKIRTING
TV	TELEVISION COAXIAL OUTLET

Feature Artwork

Standard Artwork

X-SML	X-Small - 600 x 600
SML	Small - 900 x 900
MED	Medium - 1200 x 800
LRG	Large - 1500x 800
XLG	X-Large - 1800 x 800

PRELIMINARY

Revision/Issue	Date
a	Issued for Coordination - 100% DD 2024.04.12
P1	Preliminary Internal Elevations - RACF 2025.08.08
P2	Consolidated Set-to-date / SMG Comments 2025.08.15

Clarke
Hopkins
Clarke

ClarkeHopkinsClarke

Melbourne
L9, Melbourne Connect
700 Swanston Street
Carlton Victoria 3053
Telephone (03) 9419 4340
Email studio@chc.com.au
www.chc.com.au

Sydney
3/78 Campbell Street
Sunny Hills NSW 2010
Telephone (02) 9221 9200
Email studio@chc.com.au
www.chc.com.au

Scale	As indicated @ A1
Date	01/03/2024
Drawn	RM
Architect	EL




Project
Summerset Oakleigh
52 Golf Road, Oakleigh South, VIC

Drawing
Internal Elevations- Village Admin -
Meeting, Village Manager, Sales Manager
and CBM Office

Drawing No.



230185/A1802

P2

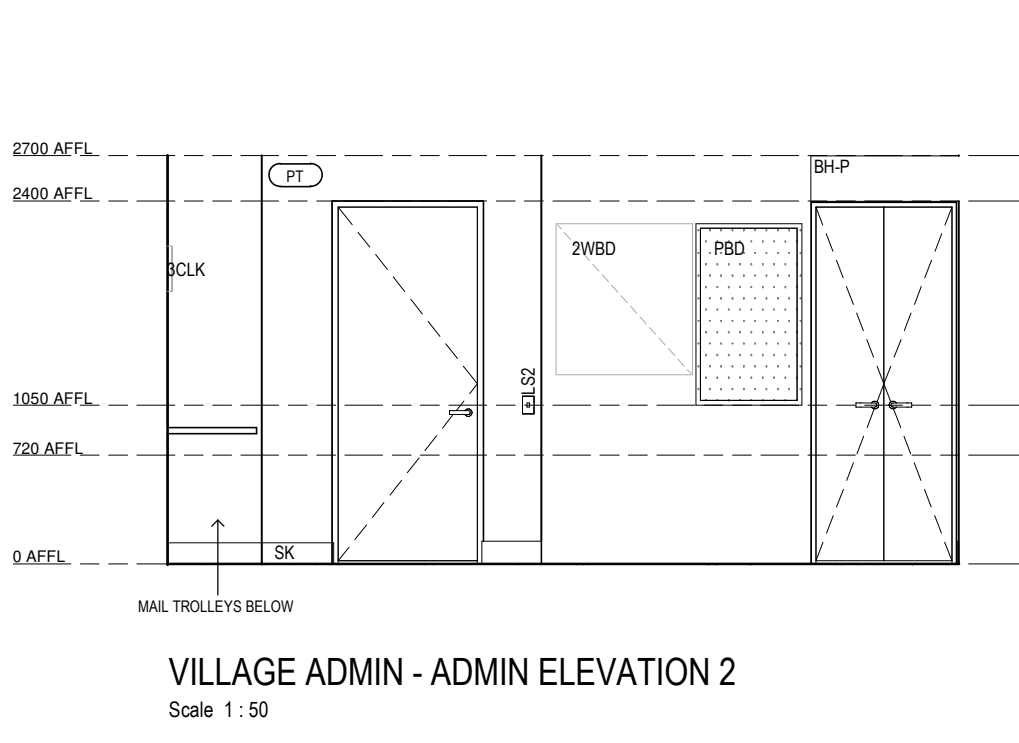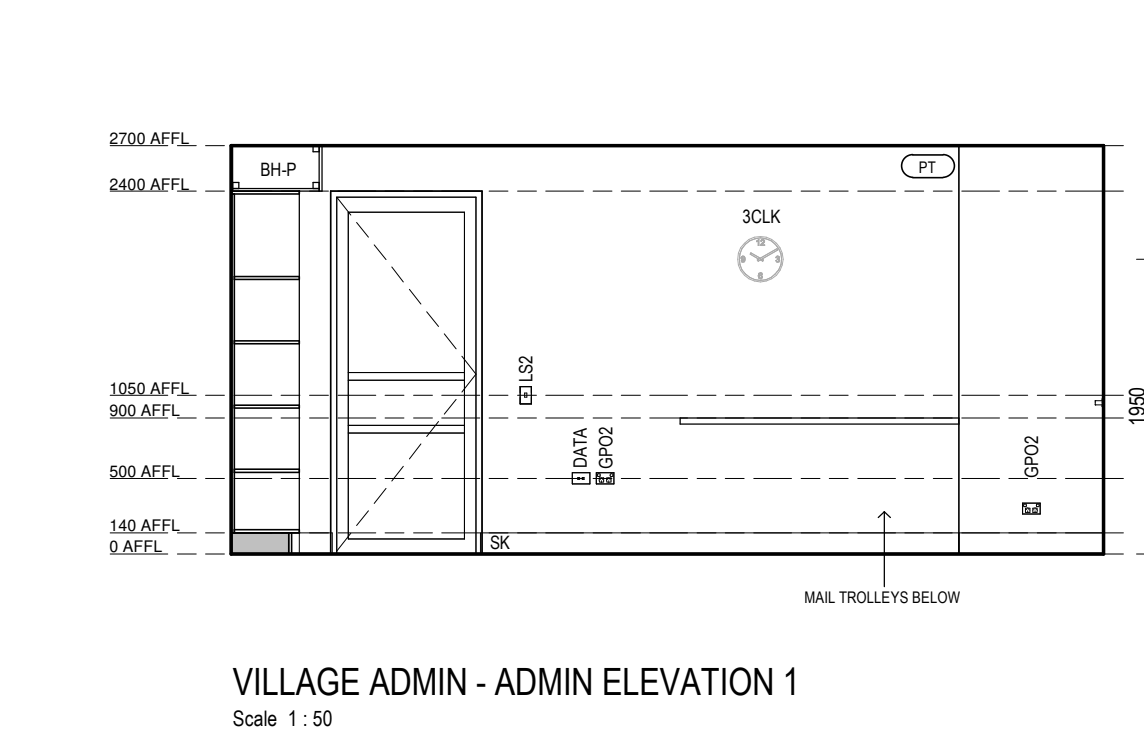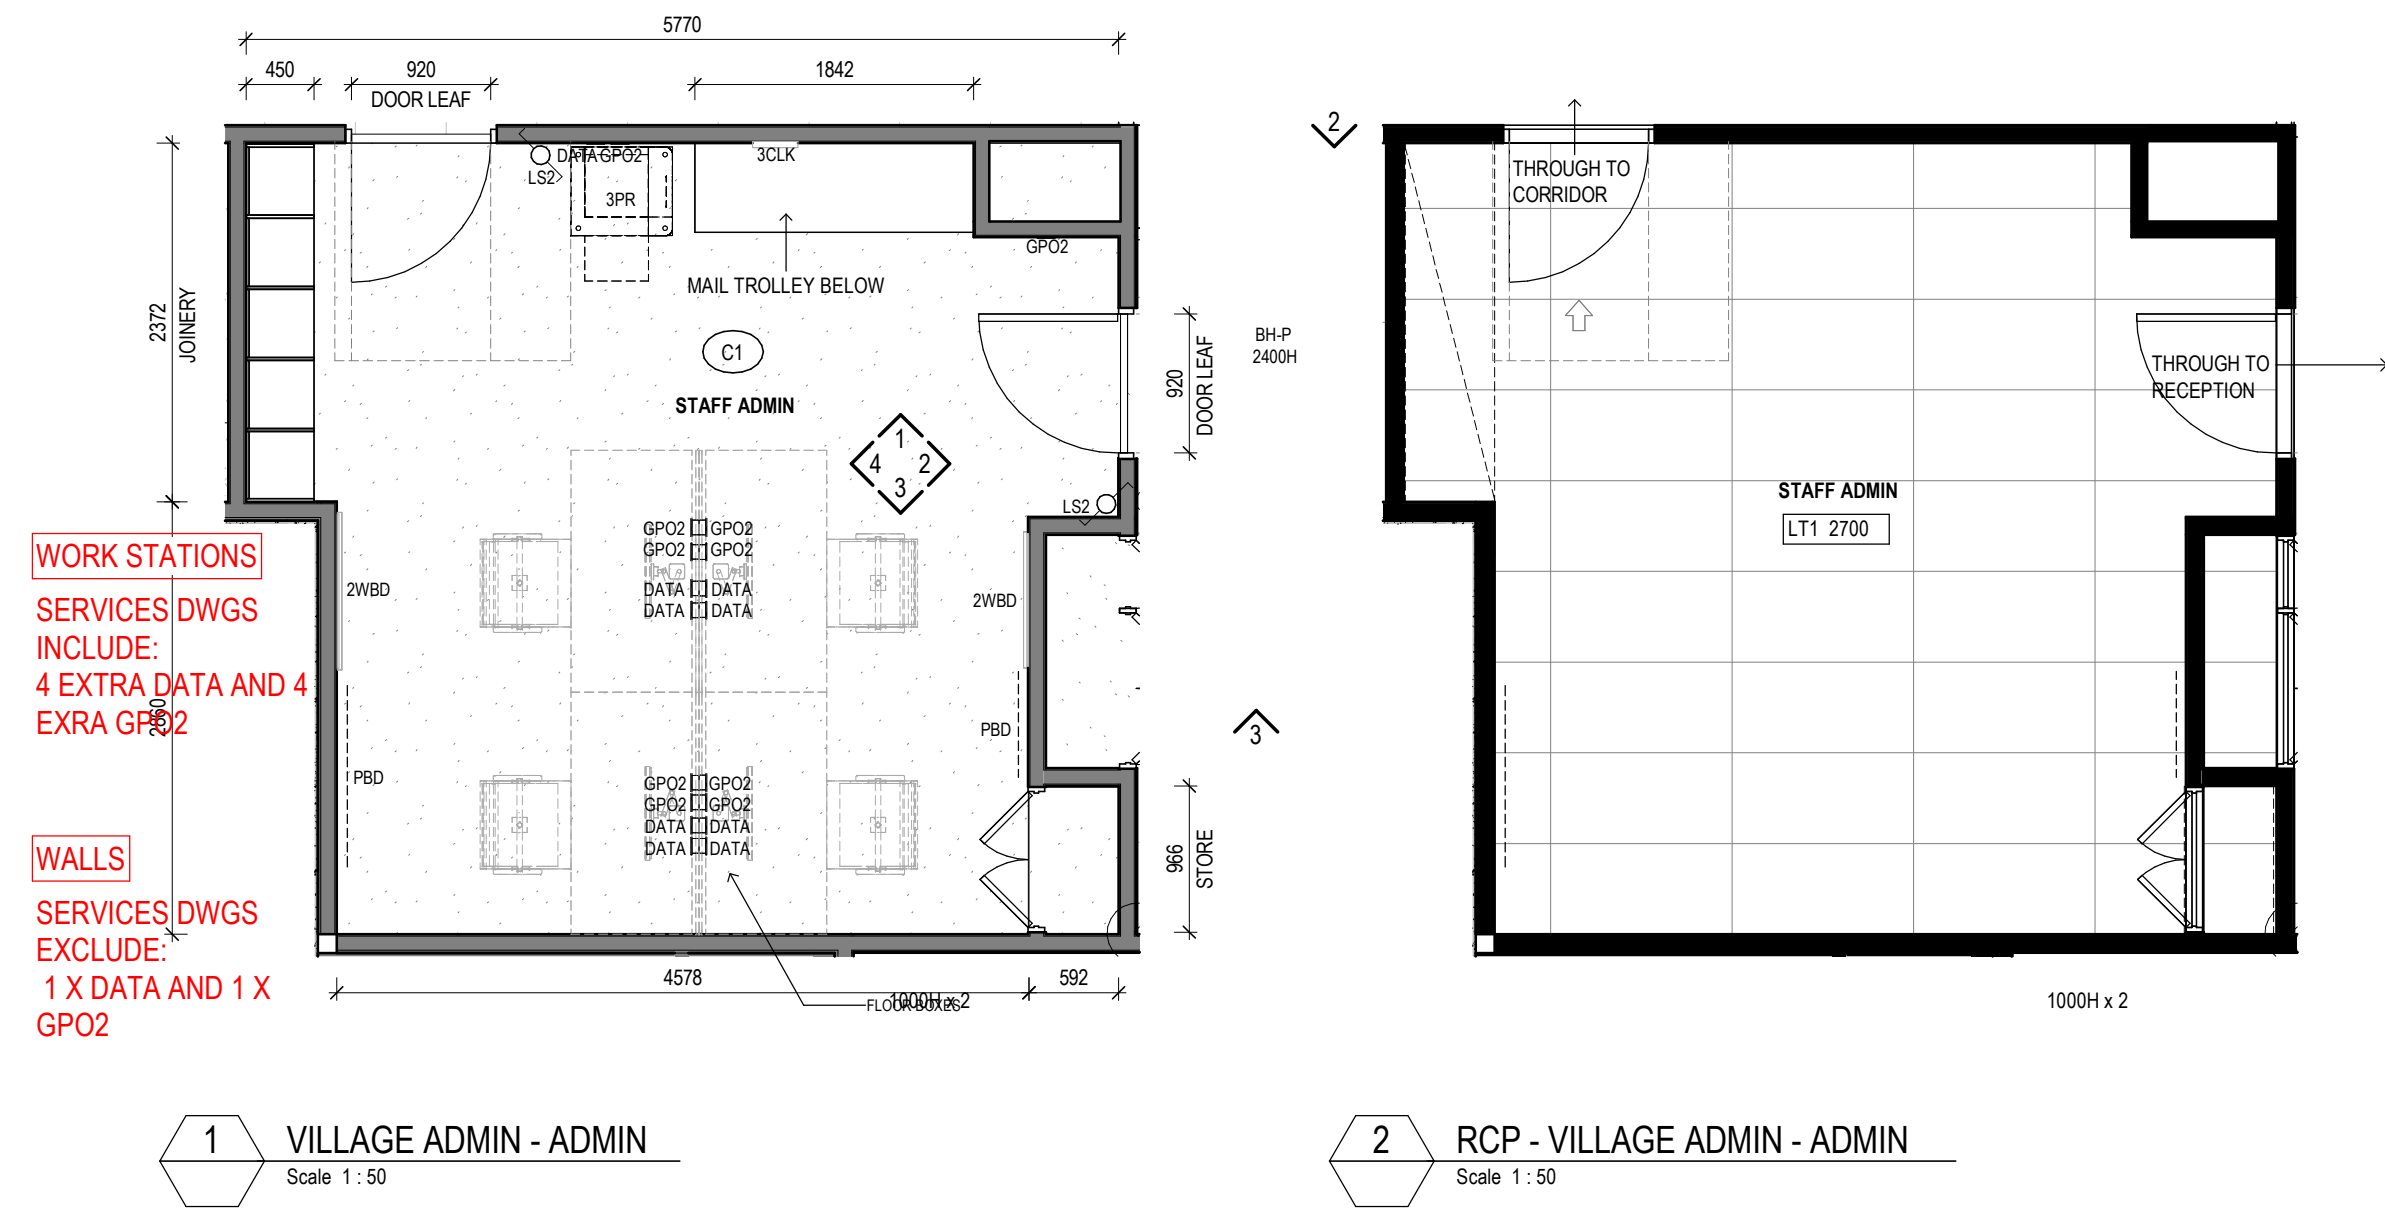

Legend - Internal Elevations

- DRAWINGS TO BE READ IN CONJUNCTION WITH ARCHITECTURAL SPECIFICATION & MATERIALS, PRODUCTS & FINISHES SCHEDULE.
- PT# PAINT FINISH TO ALL WALLS WITHIN NEW & AFFECTED ROOMS/ AREAS UNLESS OTHERWISE SHOWN
- CSE CONCRETE SEALER
 - DPR DOOR PROTECTION
 - GD GRAPHIC FILM
 - LM LAMINATE
 - MI MIRROR
 - PBD PINBOARD
 - PT PAINT FINISH
 - REN RENDER FINISH
 - SB SPLASHBACK
 - STN STONE
 - WB WHITEBOARD
 - WP WALL PROTECTION
 - WT WALL TILE
 - VV WALL VINYL
- NOTES:
1. LAMINATE CARCASS FOR ALL VISIBLE OPEN SHELVING, UNLESS OTHERWISE NOTED
2. MELAMINETO ALL INTERNAL CARCASS OF JOINERY, UNLESS OTHERWISE NOTED.



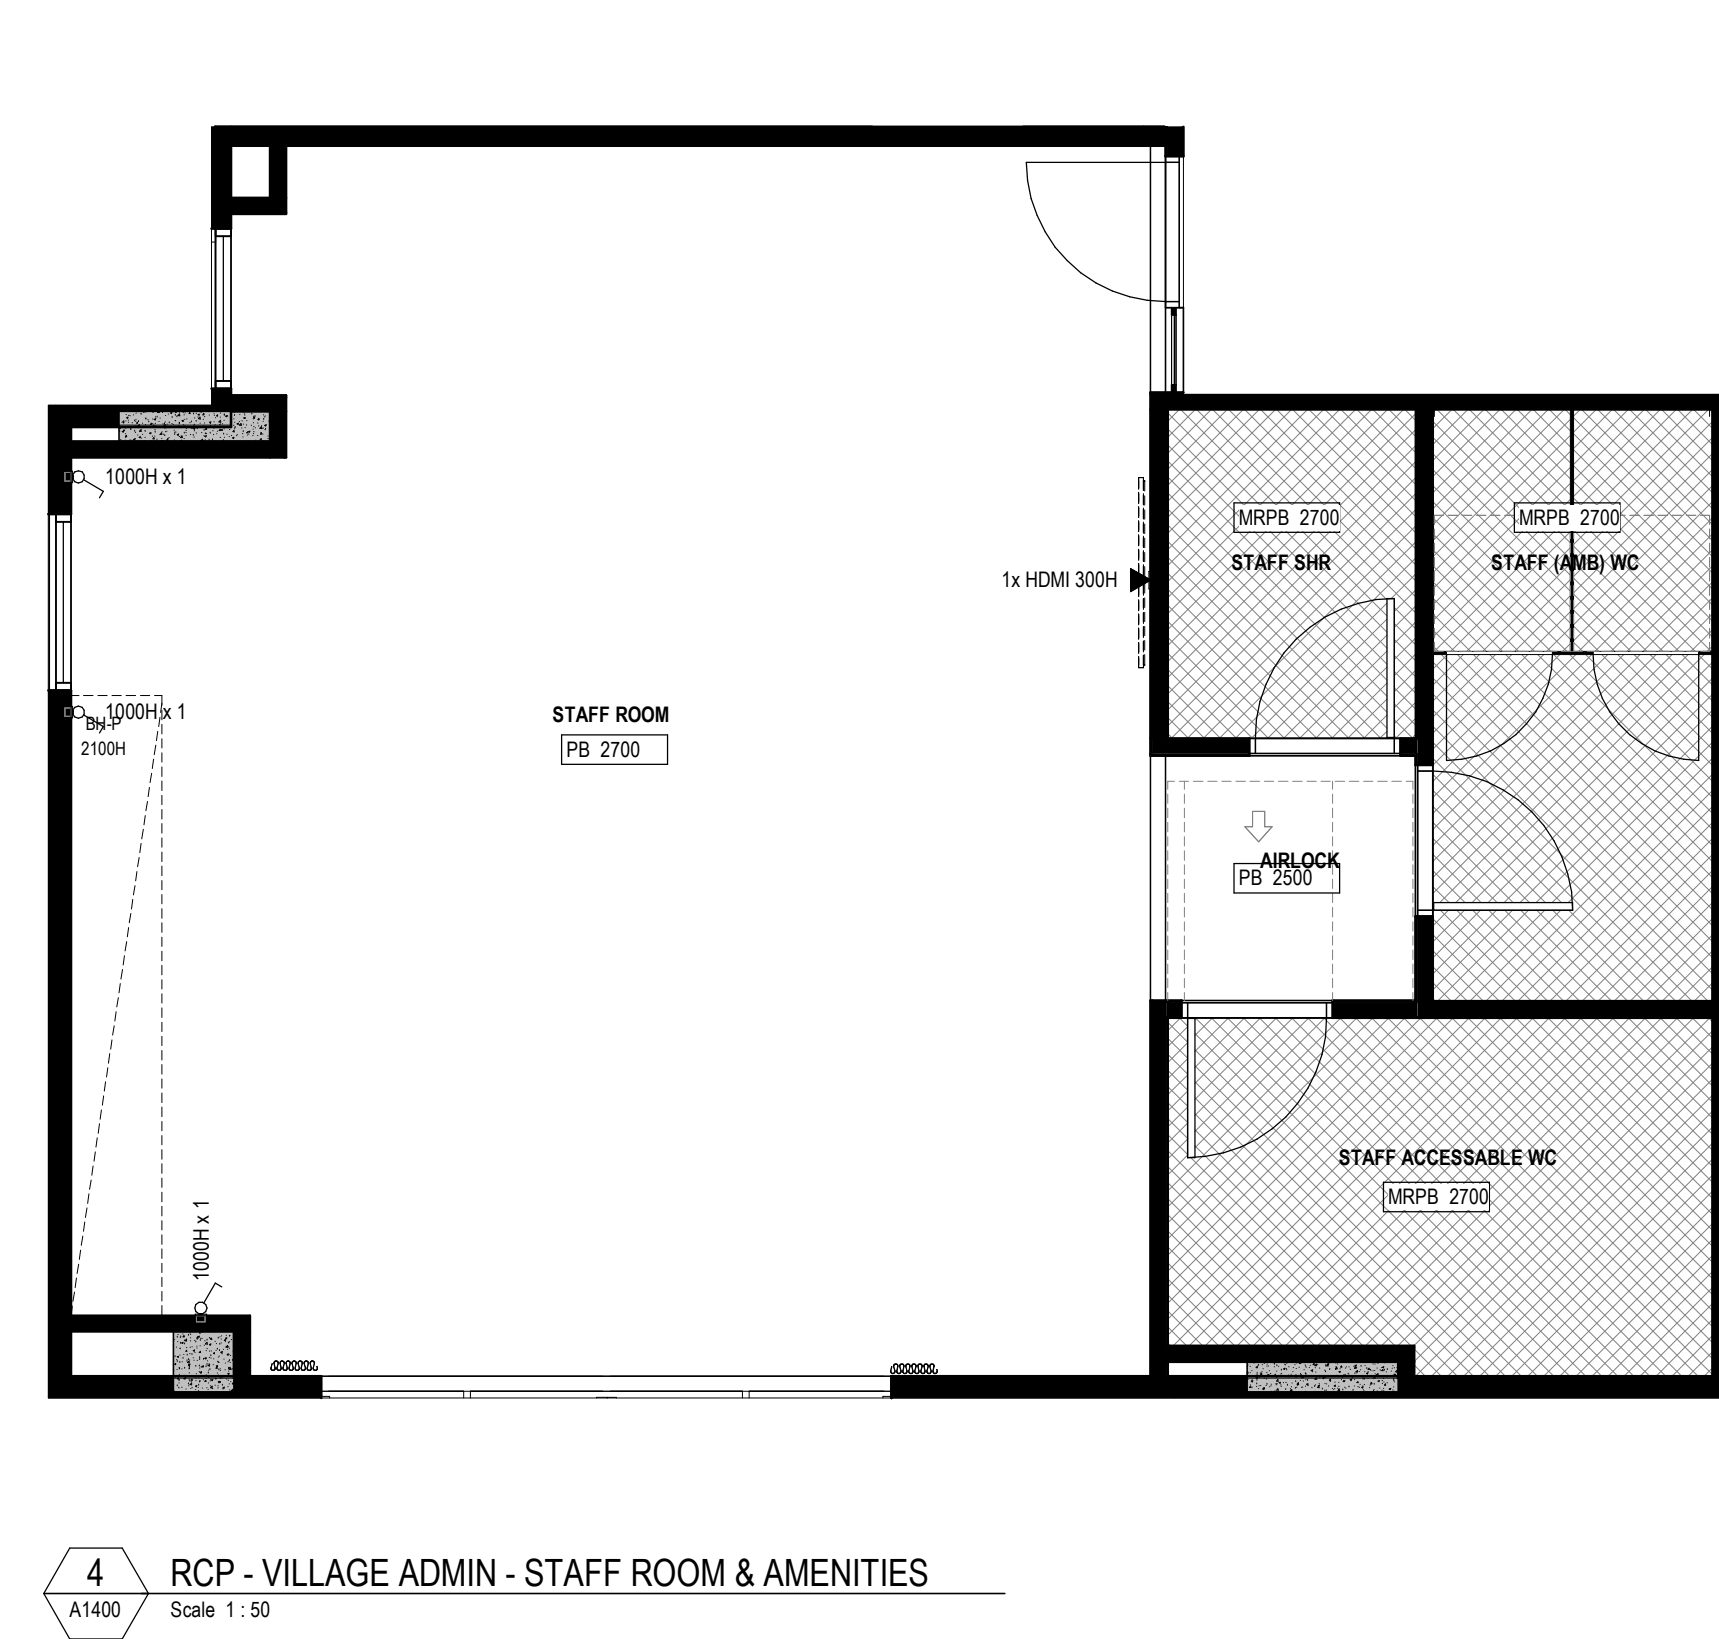
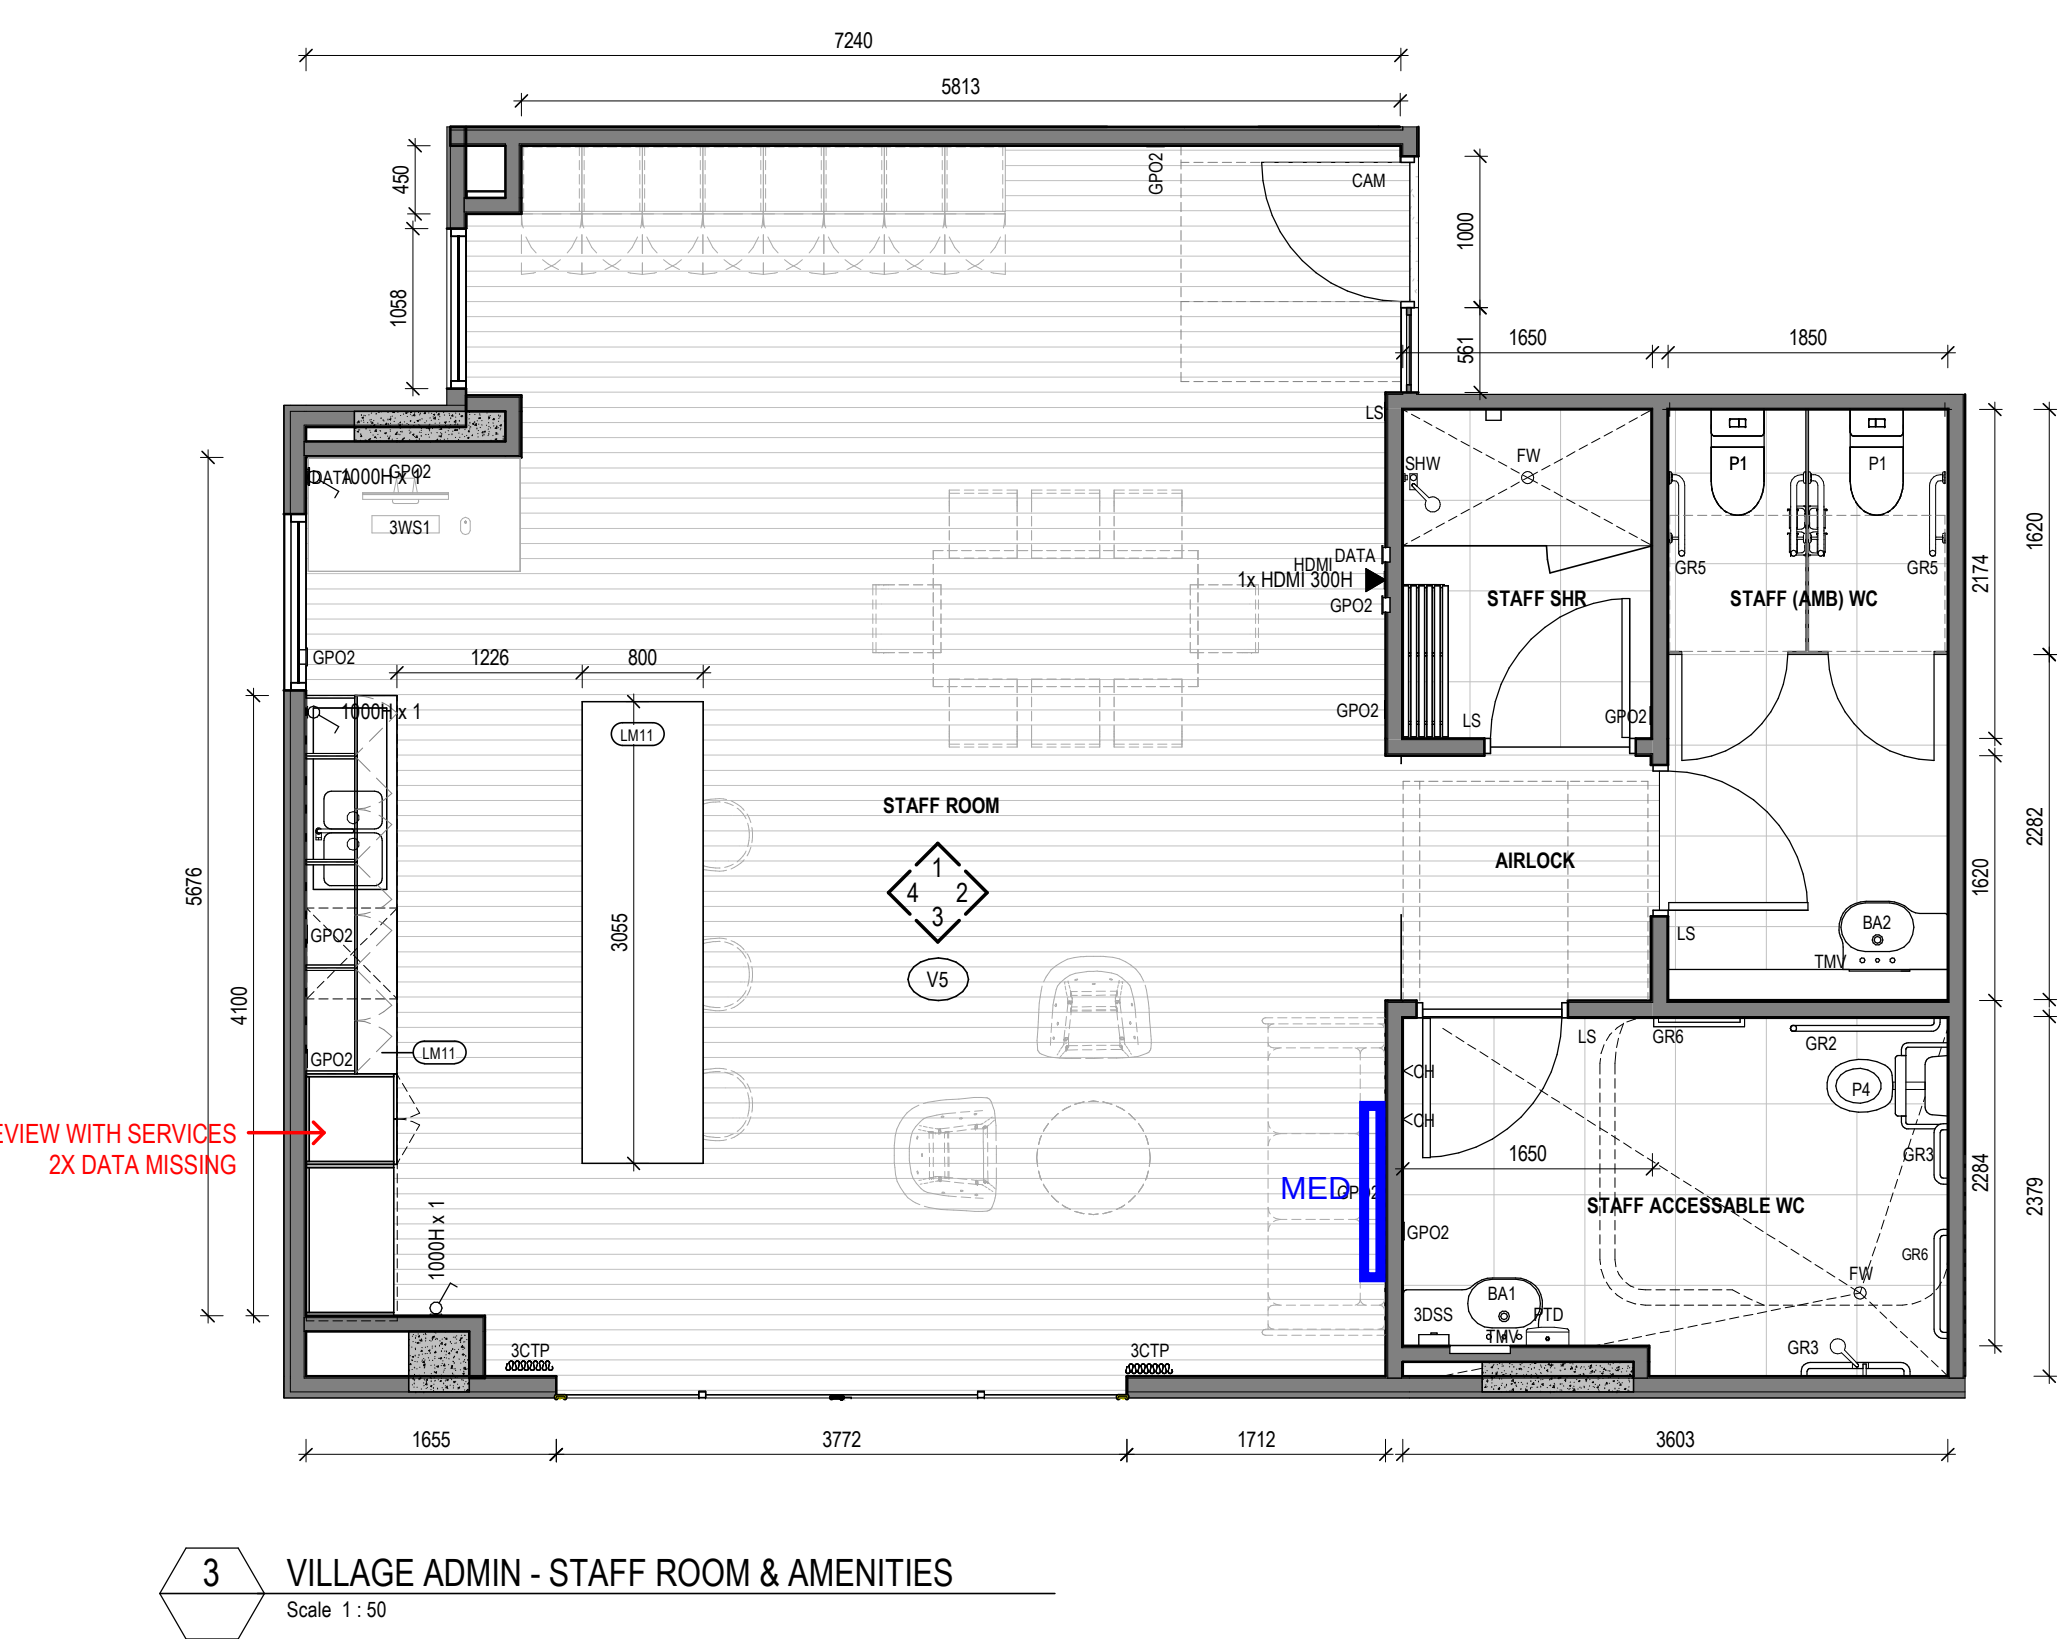



Legend - Floor Finishes

- C CARPET
- CO CONCRETE
- D DECKING
- E EPOXY FINISH
- L LINOLEUM
- M MATTING
- PF PARTICLEBOARD FLOORING
- PU PAVING UNIT - TBC WITH LANDSCAPE
- PW PLYWOOD
- R RUBBER FLOORING
- T TILING
- TF TIMBER FLOORING
- V VINYL


Keynote Legend

- 2WBD WHITEBOARD - GROUP 2
 - 3CLK CLOCK - GROUP 3
 - 3CTP CURTAINS - GROUP 3
 - 3DSS SOAP DISPENSER
 - 3PR PRINTER - GROUP 3
 - 3TV(M) TELEVISION SCREEN 55 INCH - GROUP 3
 - 3WS1 WORK STATION - GROUP 3
 - BA1 BASIN - TYPE 1
 - BA2 BASIN - TYPE 2
 - BH-P BULHEAD - PLASTERBOARD TYPE
 - CAM CCTV CAMERA
 - CBD CUPBOARD
 - CH CLOTHES HOOK
 - DATA DATA OUTLET
 - FW FLOOR WASTE
 - GPO2 POWER OUTLET - DOUBLE
 - GR2 GRAB RAIL - TYPE 2
 - GR3 GRAB RAIL - TYPE 3
 - GR5 GRAB RAIL - TYPE 5
 - GR6 GRAB RAIL - TYPE 6
 - HDMI HDMI OUTLET
 - LO1 LOCKER - TYPE 1
 - LS LIGHT SWITCH
 - LS2 LIGHT SWITCH - TWO WAY
 - P1 TOILET PAN TYPE 01
 - P4 TOILET PAN TYPE 04
 - PBD PINBOARD - FRAMED
 - PTD PAPER TOWEL DISPENSER
 - S2 SINK - TYPE 2
 - SH SHELF
 - SHW SHOWER
 - SK SKIRTING
 - TMV
- X-Small - 600 x 600
Small - 900 x 900
Medium - 1200 x 800
Large - 1500x 800
X-Large - 1800 x 800

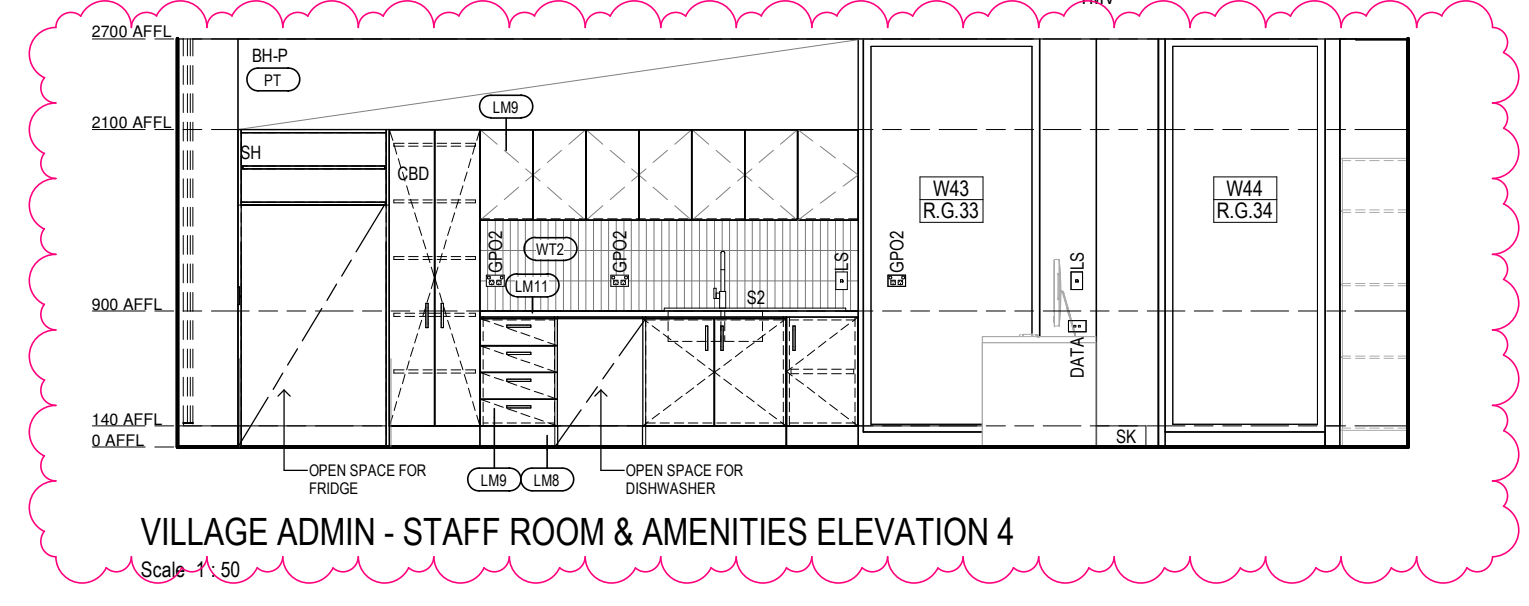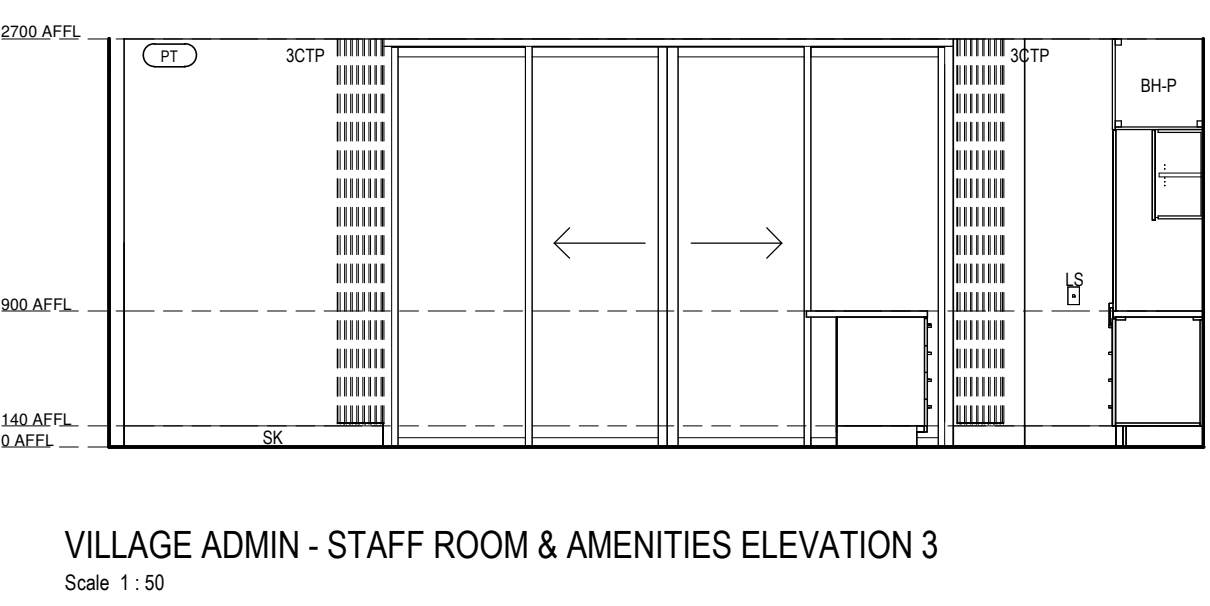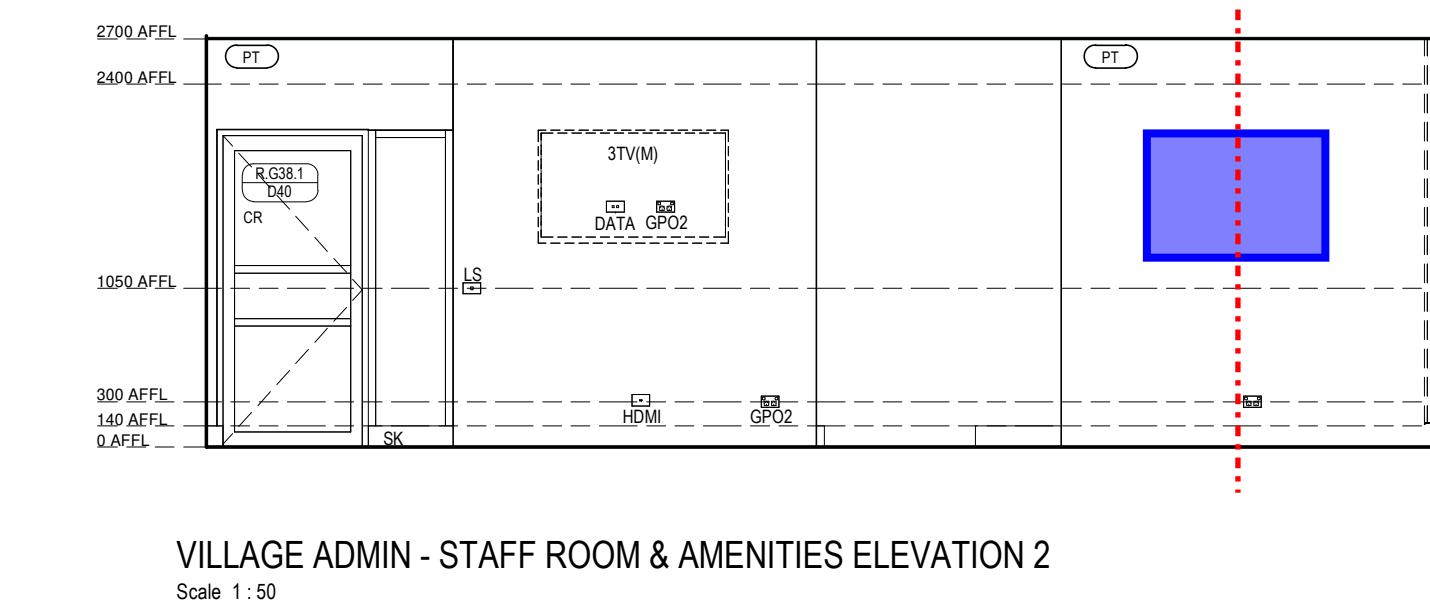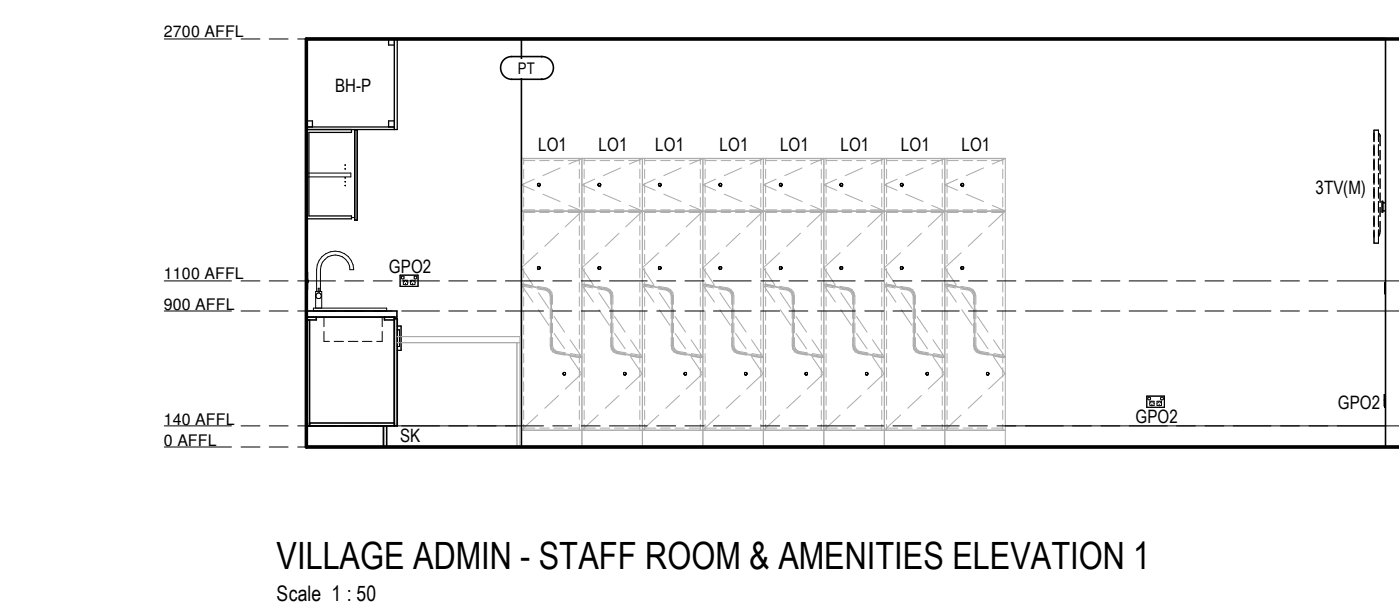


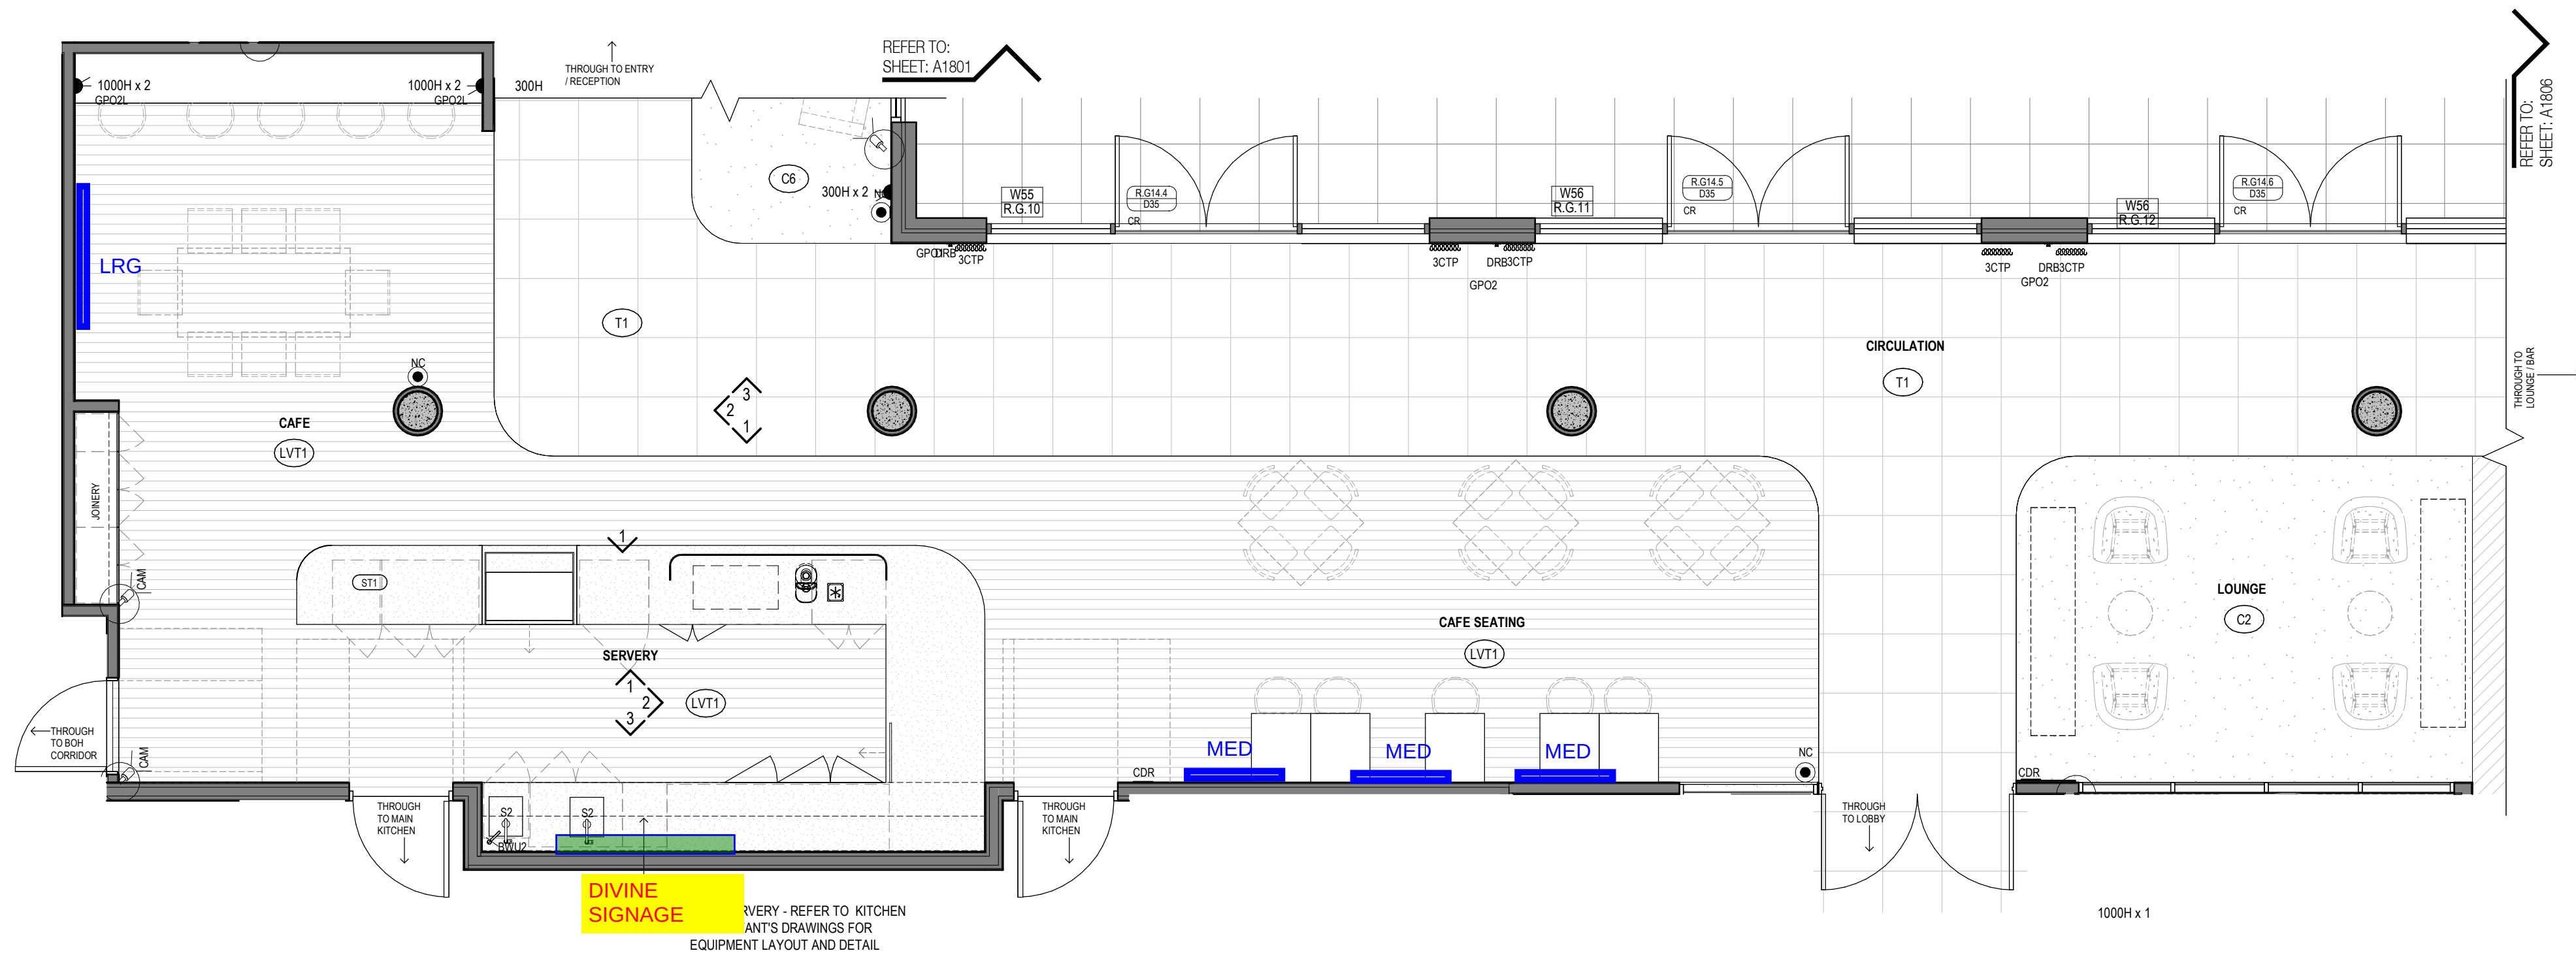


1 VILLAGE LIFESTYLE - CAFE
Scale 1: 50

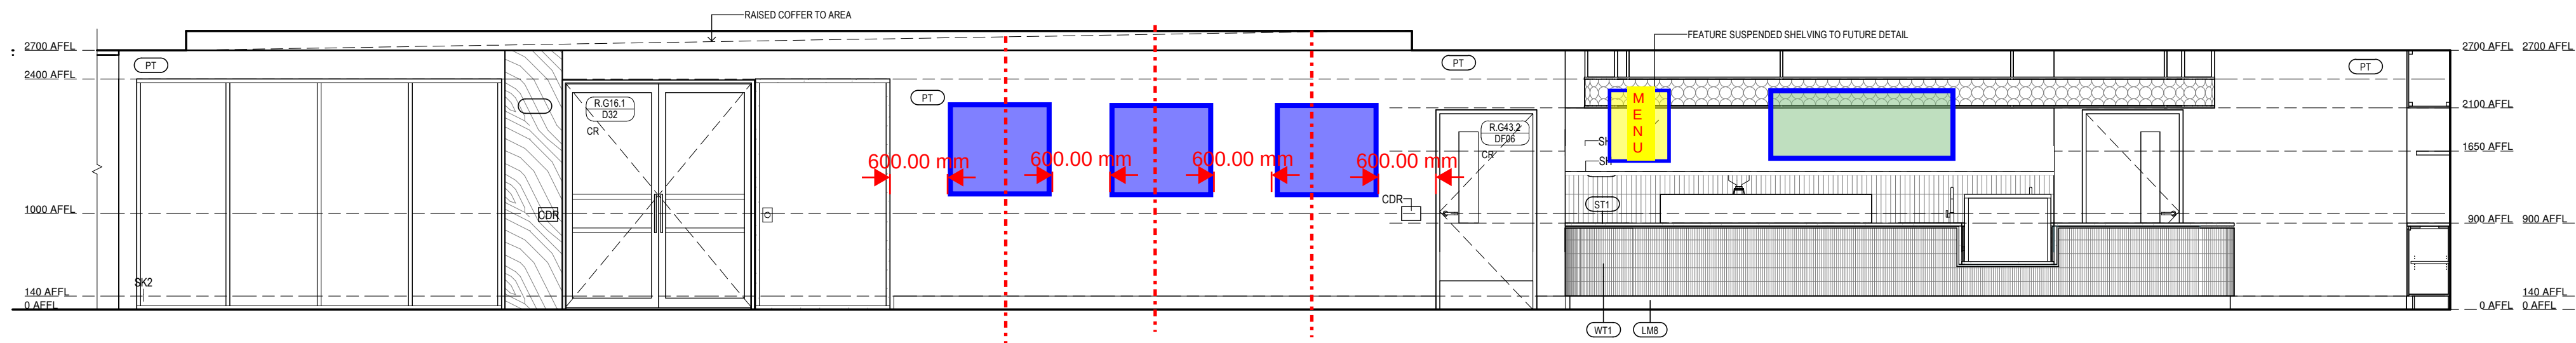


VILLAGE LIFESTYLE - CAFE AREA ELEVATION 1
Scale 1: 50

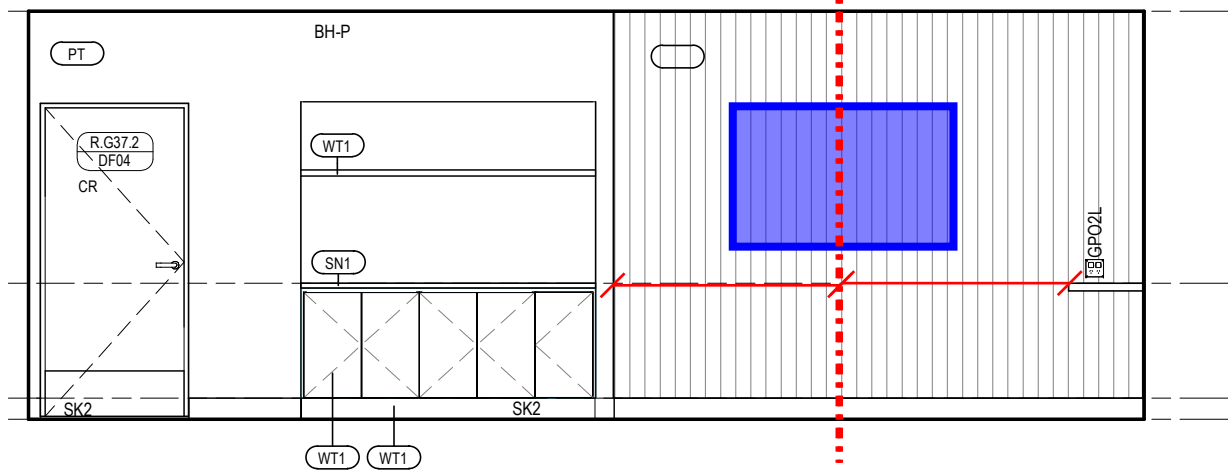


VILLAGE LIFESTYLE - CAFE AREA ELEVATION 2
Scale 1: 50

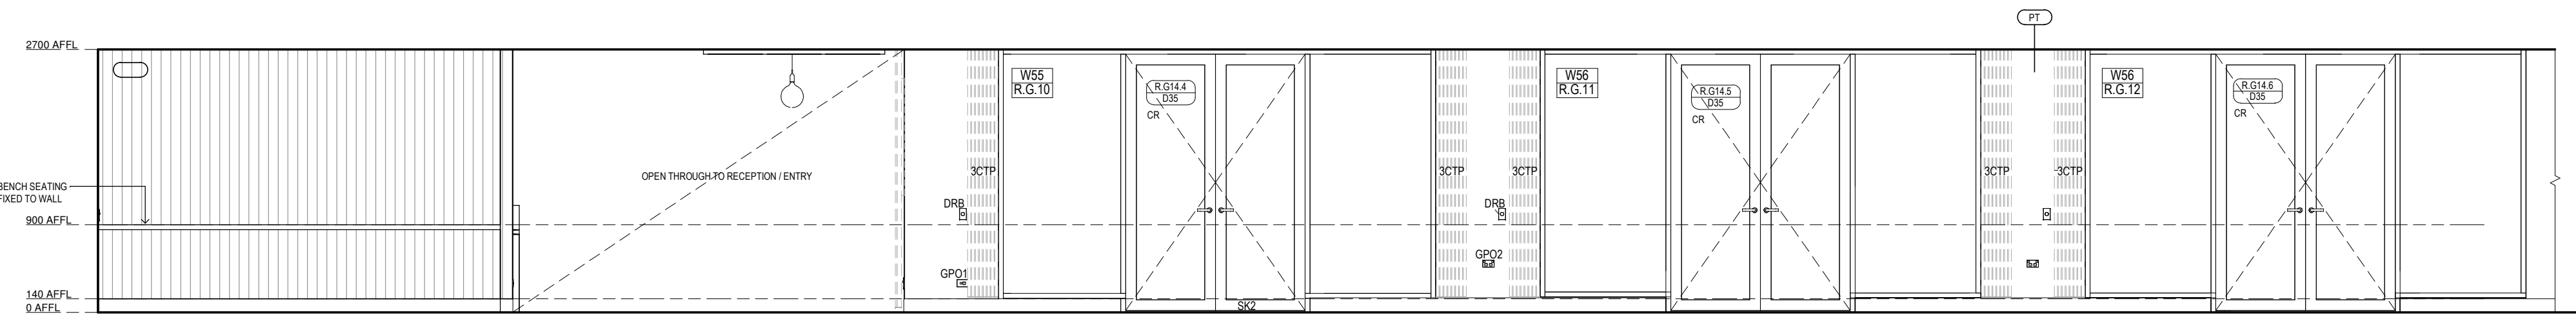


VILLAGE LIFESTYLE - CAFE AREA ELEVATION 3
Scale 1: 50

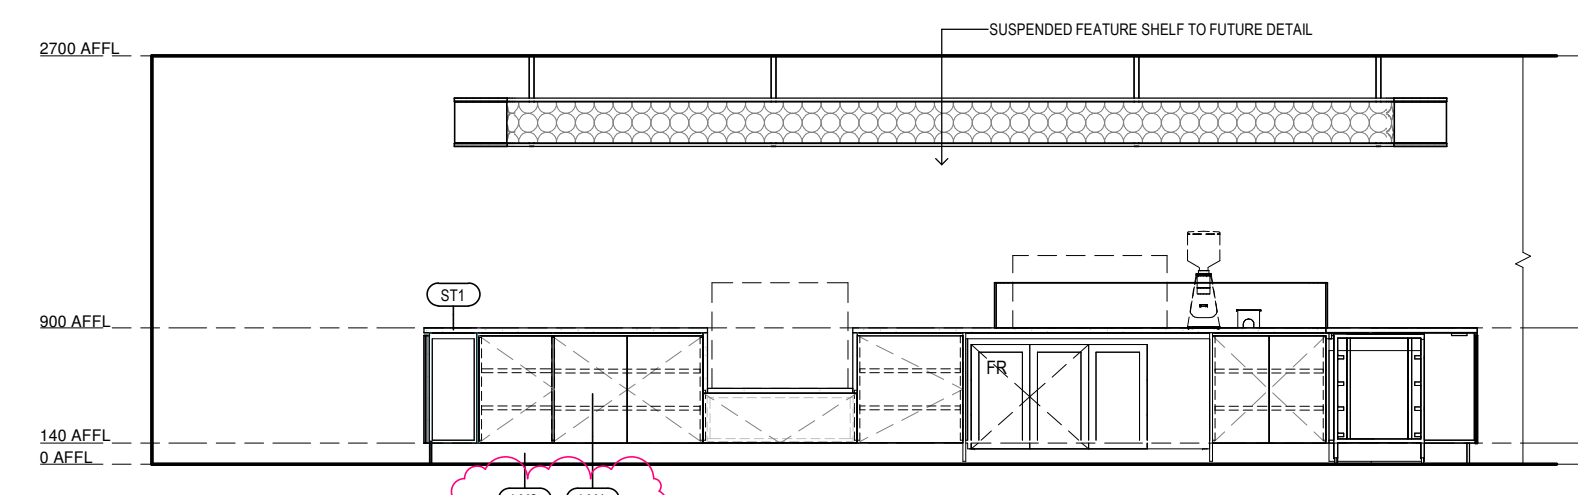

VILLAGE LIFESTYLE - SERVERY ELEVATION 1
Scale 1: 50

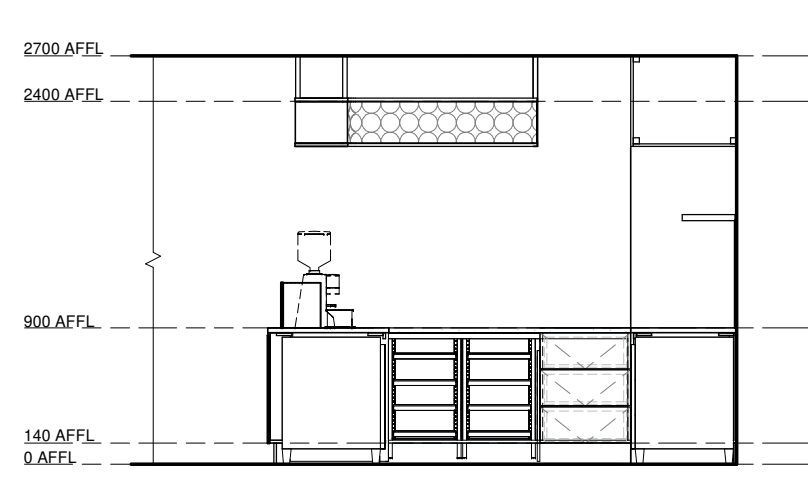

VILLAGE LIFESTYLE - SERVERY ELEVATION 2
Scale 1: 50

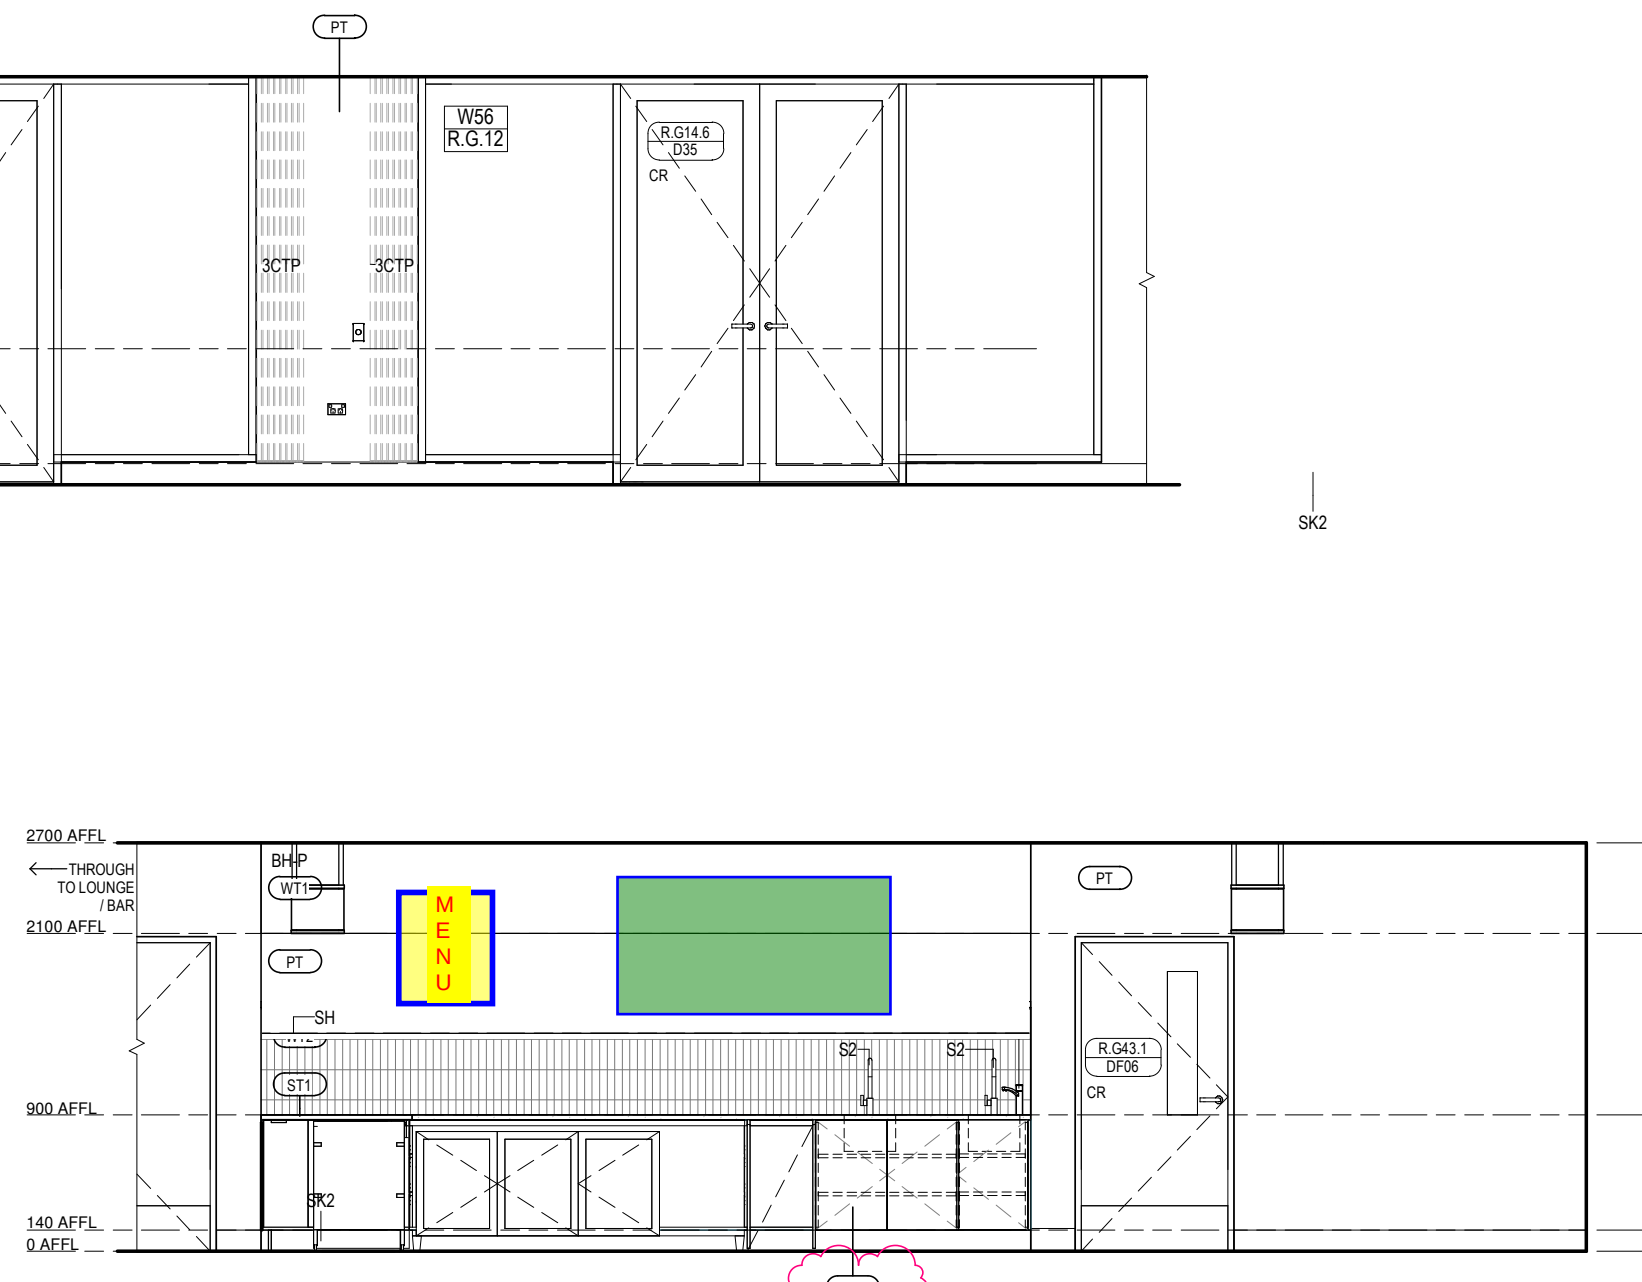

VILLAGE LIFESTYLE - SERVERY ELEVATION 3
Scale 1: 50

Legend - Internal Elevations

DRAWINGS TO BE READ IN CONJUNCTION WITH ARCHITECTURAL SPECIFICATION & MATERIALS, PRODUCTS & FINISHES SCHEDULE.

PT# PAINT FINISH TO ALL WALLS WITHIN NEW & AFFECTED ROOMS/ AREAS UNLESS OTHERWISE SHOWN

CSE	CONCRETE SEALER
DPR	DOOR PROTECTION
GD	GRAPHIC FILM
LM	LAMINATE
MI	MIRROR
PBD	PINBOARD
PT	PAINT FINISH
REN	RENDER FINISH
SB	SPLASHBACK
STN	STONE
WB	WHITEBOARD
WP	WALL PROTECTION
WT	WALL TILE
WV	WALL VINYL

NOTES:
1. LAMINATE CARCASS FOR ALL VISIBLE OPEN SHELVING, UNLESS OTHERWISE NOTED
2. MELAMINETO ALL INTERNAL CARCASS OF JOINERY, UNLESS OTHERWISE NOTED.

Legend - Floor Finishes

C	CARPET
CO	CONCRETE
D	DECKING
E	EPOXY FINISH
L	LINOLEUM
M	MATTING
PF	PARTICLEBOARD FLOORING
PU	PAVING UNIT - TBC WITH LANDSCAPE
PW	PLYWOOD
R	RUBBER FLOORING
T	TILING
TF	TIMBER FLOORING
V	VINYL

Keynote Legend

3CTP	CURTAINS - GROUP 3
BHP	BULKHEAD - PLASTERBOARD TYPE
BWU2	BOILING WATER UNIT - TYPE 2
CAM	CCTV CAMERA
CDR	CARD READER
DRB	DOOR RELEASE BUTTON
FR	FRIDGE (NIC)
GPO1	POWER OUTLET - SINGLE
GPO2	POWER OUTLET - DOUBLE
GPO2L	POWER OUTLET - DOUBLE - LARGE PLATE
NC	NURSE CALL
S2	SINK - TYPE 2
SH	SHELF
SK2	SKIRTING - TYPE 2

Feature Artwork

Standard Artwork

X-SML	X-Small - 600 x 600
SML	Small - 900 x 900
MED	Medium - 1200 x 800
LRG	Large - 1500x 800
XLG	X-Large - 1800 x 800

Revision/Issue	Date
P1 Consolidated Set-to-date / SMG Comments	2025.08.15
P2 Tender Pack Issue	2025.09.05

**Clarke
Hopkins
Clarke**

ClarkeHopkinsClarke

Melbourne
L9, Melbourne Connect
700 Swanston Street
Carlton Victoria 3053
Telephone (03) 9419 4340
Email studio@chc.com.au
www.chc.com.au

Sydney
3/78 Campbell Street
Sunny Hills NSW 2010
Telephone (02) 9221 9200
Email studio@chc.com.au
www.chc.com.au


Scale	As indicated @ A1
Date	01/03/2024
Drawn	EL
Architect	EL

Project
Summerset Oakleigh
52 Golf Road, Oakleigh South, VIC


Drawing
Internal Elevations - Village Lifestyle - Cafe

Drawing No.
230185/A1805
P2


PRELIMINARY

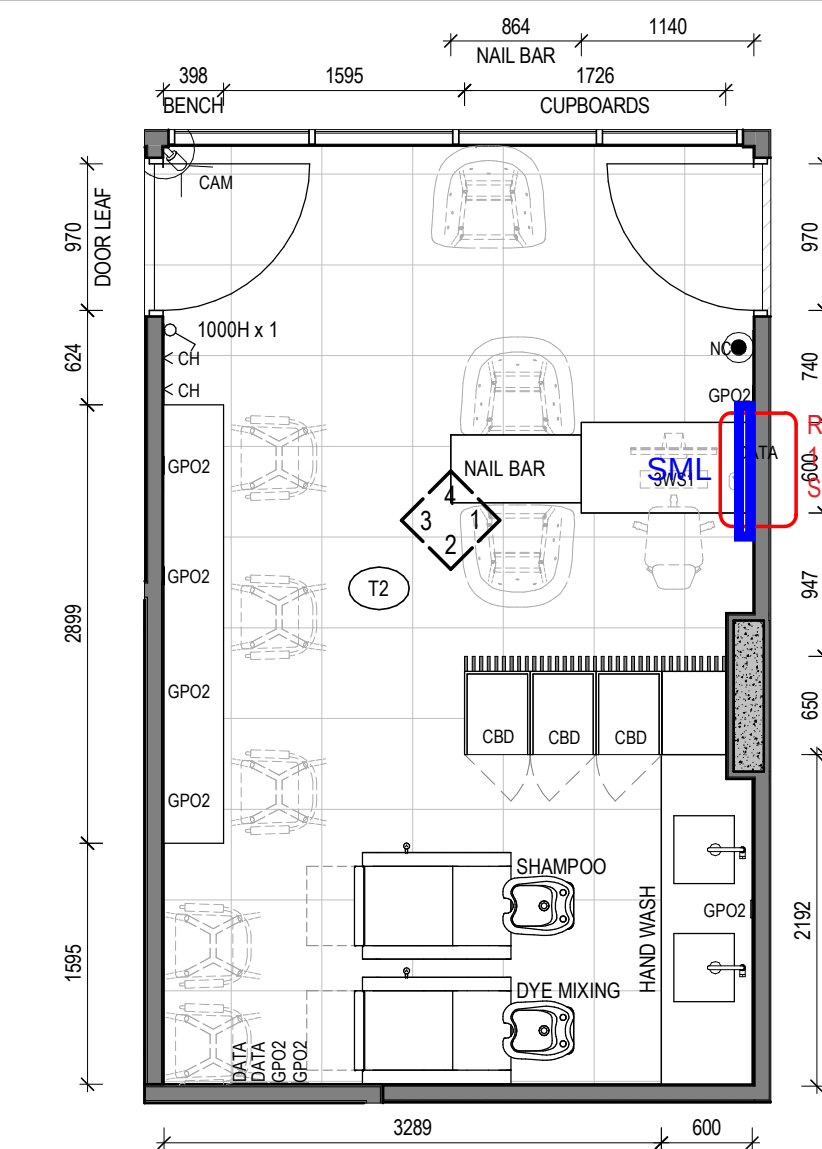


1 VILLAGE HEALTH & WELLNESS - SALON
Scale 1:50

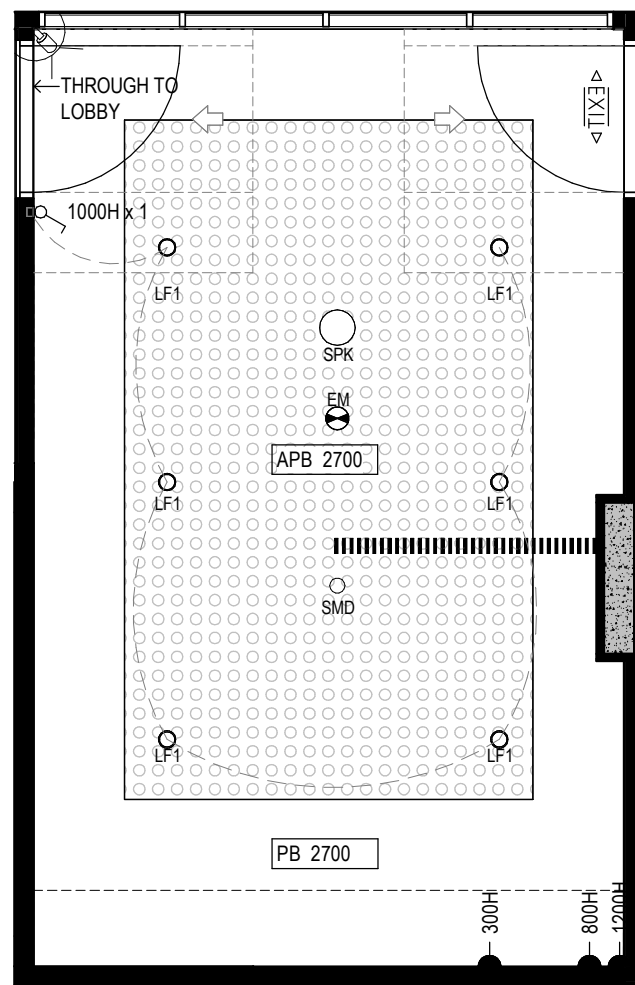


2 RCP - VILLAGE HEALTH & WELLNESS - SALON
Scale 1:50

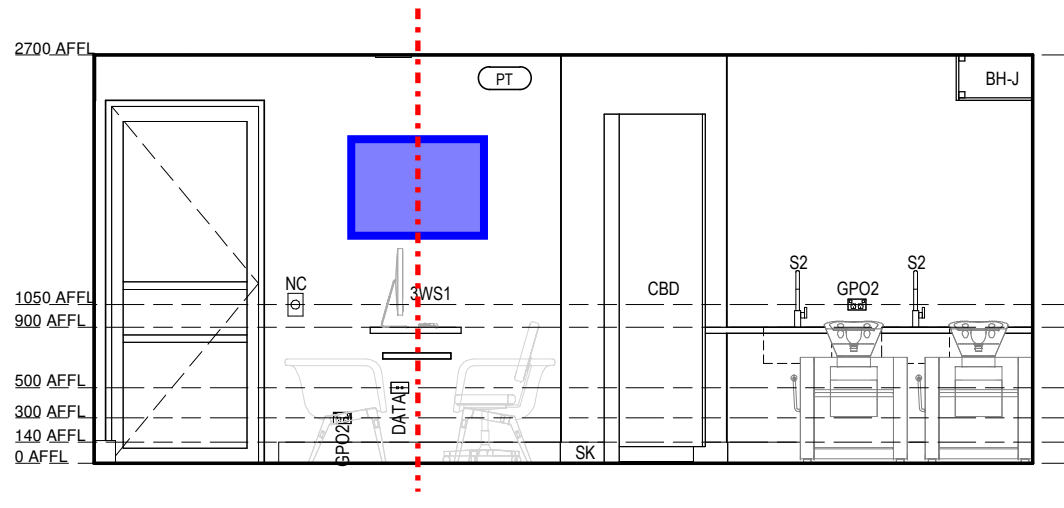


VILLAGE HEALTH & WELLNESS - SALON ELEVATION 1
Scale 1:50

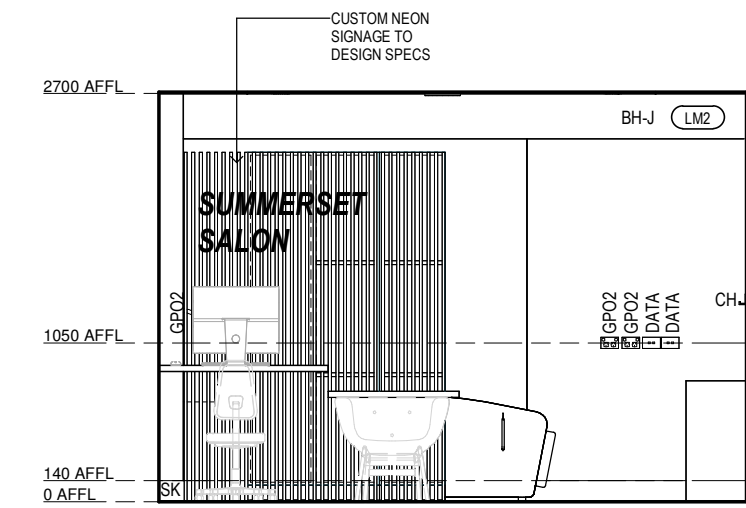

VILLAGE HEALTH & WELLNESS - SALON ELEVATION 2
Scale 1:50

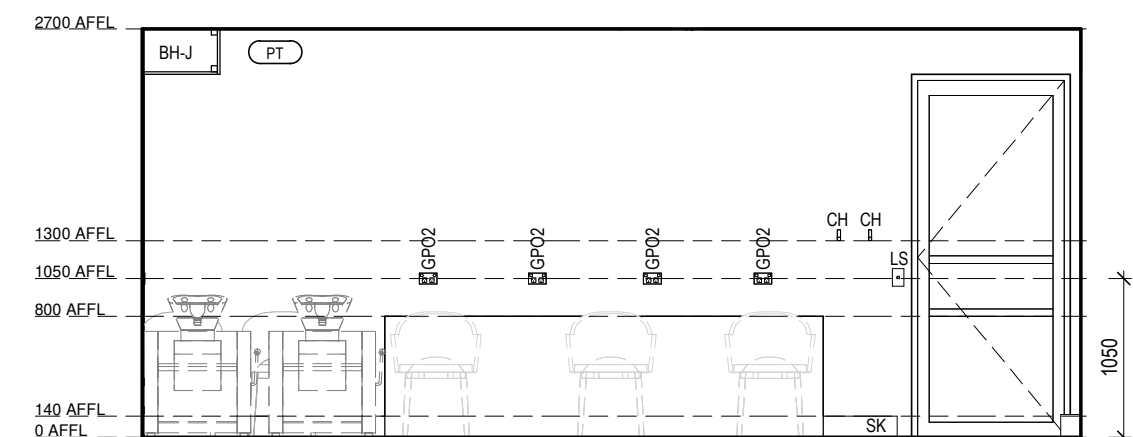


VILLAGE HEALTH & WELLNESS - SALON ELEVATION 3
Scale 1:50

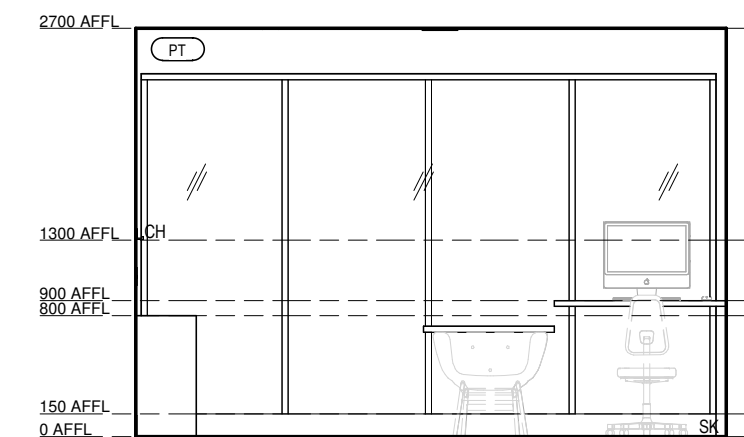


VILLAGE HEALTH & WELLNESS - SALON ELEVATION 4
Scale 1:50


SERVICES DRAWING
HAS 1X EXTRA GPO2
AND 2X EXTRA DATA

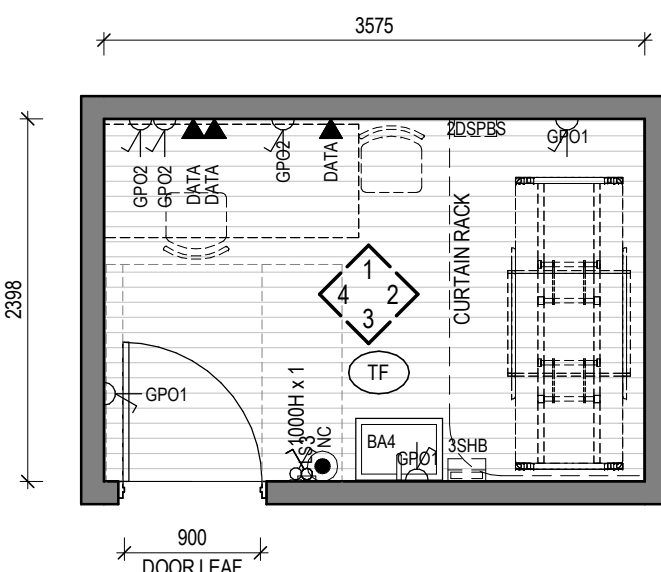


3 VILLAGE HEALTH & WELLNESS - CONSULT
Scale 1:50

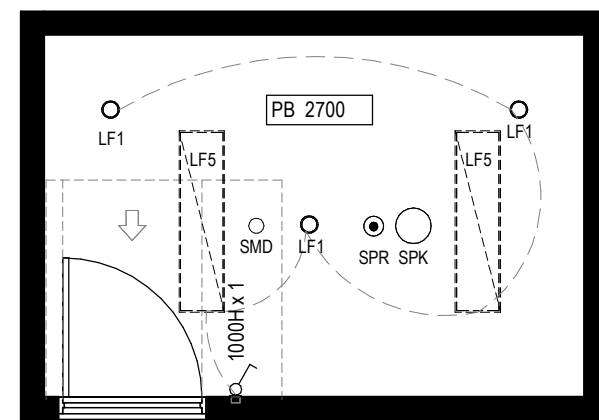


4 RCP - VILLAGE HEALTH & WELLNESS - CONSULT
Scale 1:50

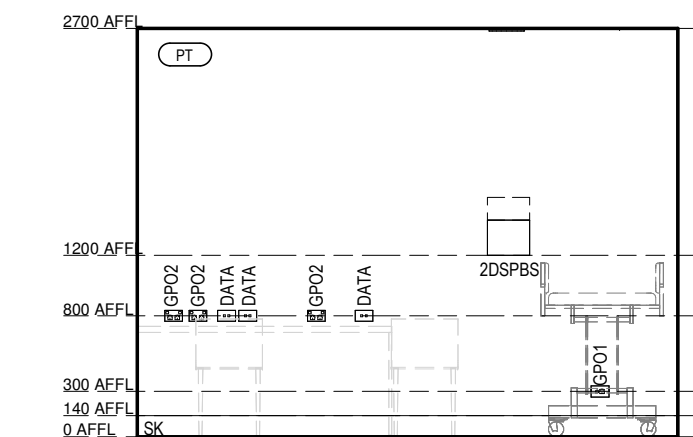


VILLAGE HEALTH & WELLNESS - CONSULT ELEVATION 1
Scale 1:50

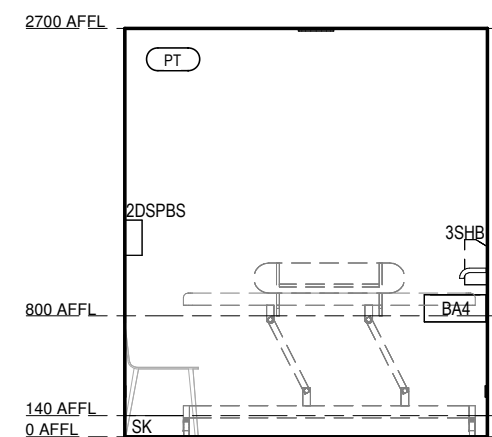

VILLAGE HEALTH & WELLNESS - CONSULT ELEVATION 2
Scale 1:50

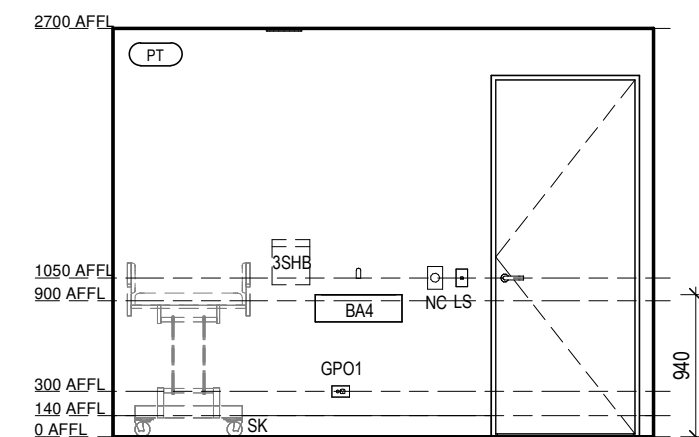


VILLAGE HEALTH & WELLNESS - CONSULT ELEVATION 3
Scale 1:50

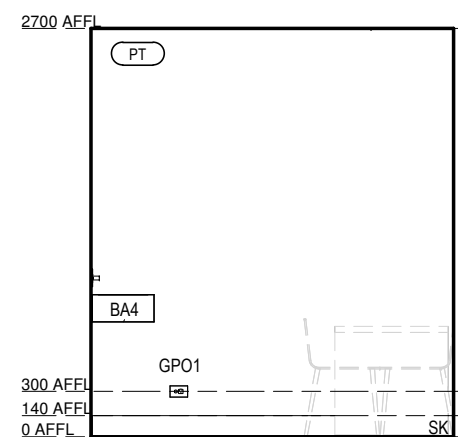


VILLAGE HEALTH & WELLNESS - CONSULT ELEVATION 4
Scale 1:50

SERVICES DWG
INCLUDES:


1XGPO2 BY EXTRA
EQUIPMENT (THIS
MACHINE ISNT IN THE
RDS)

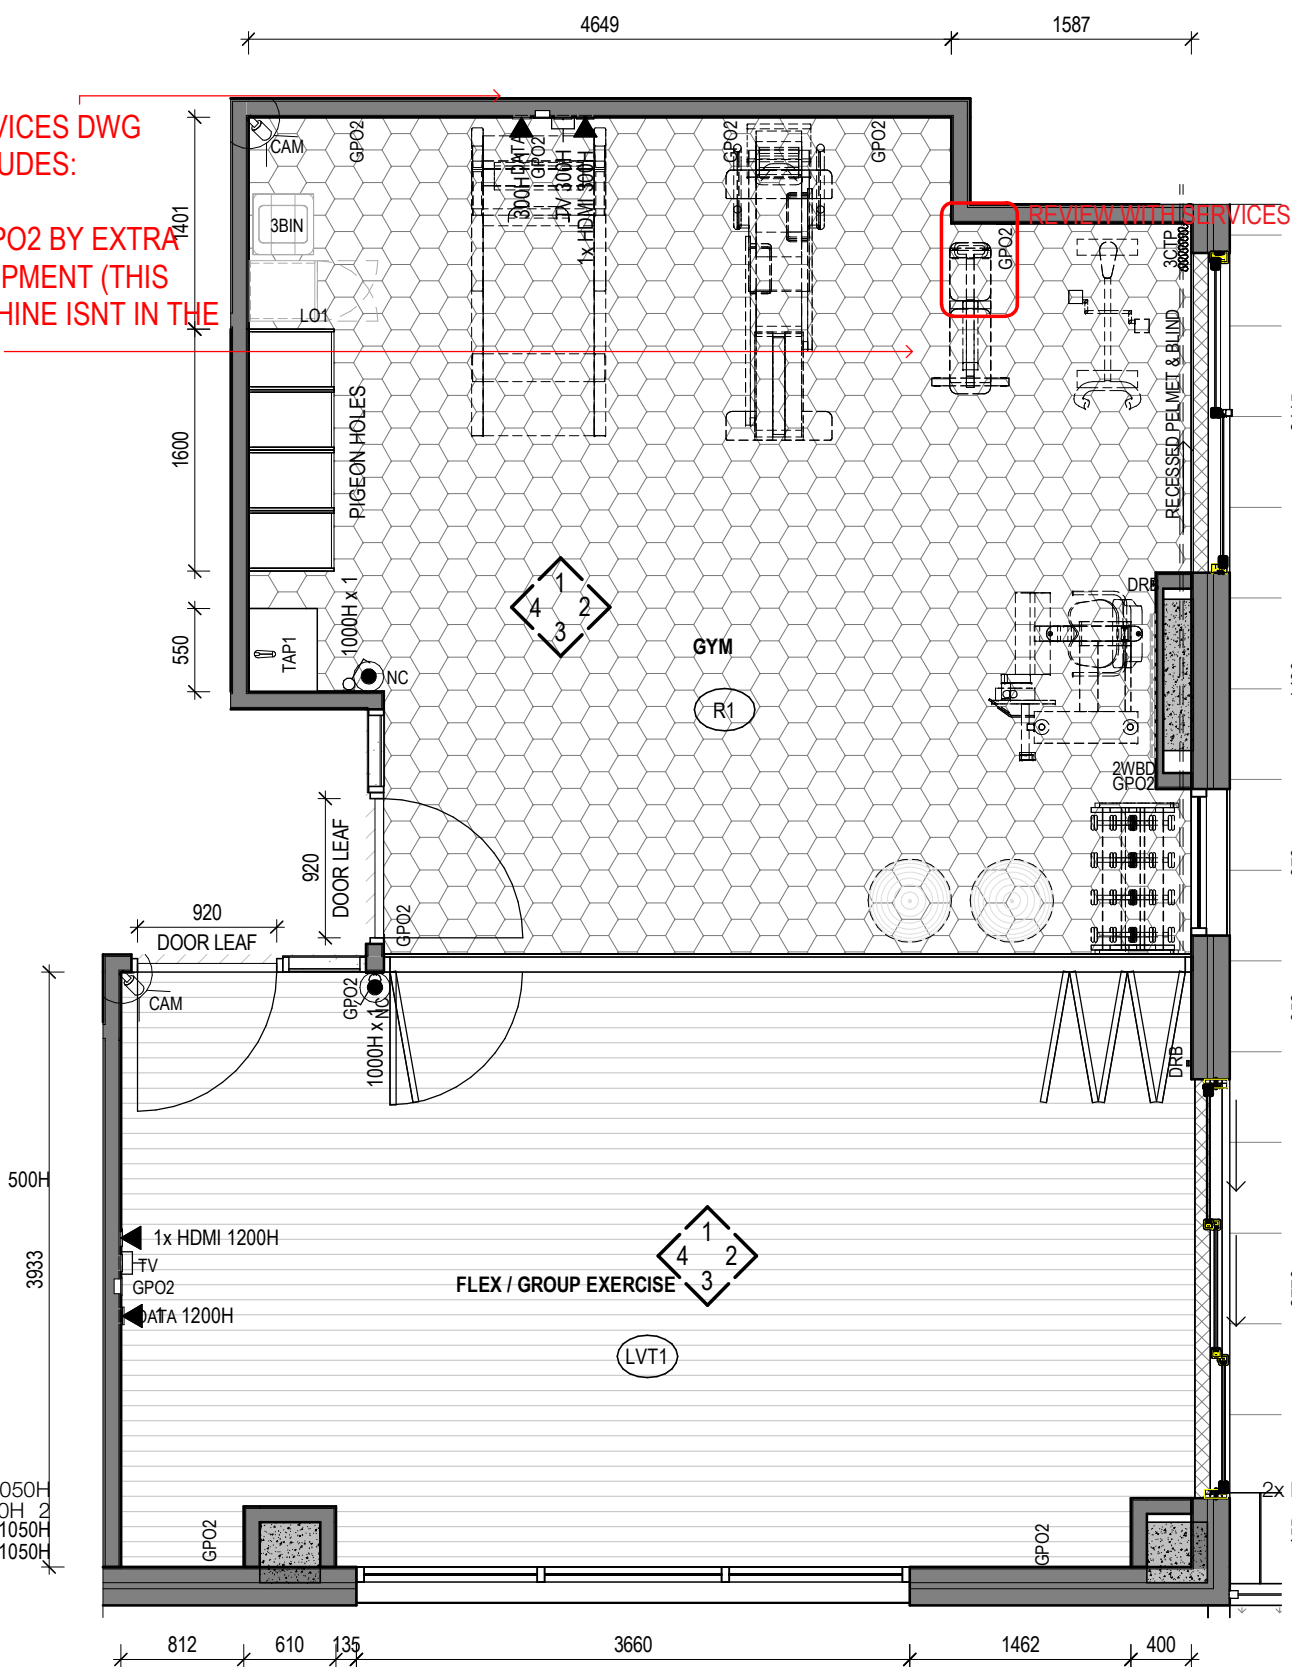


5 VILLAGE HEALTH & WELLNESS - GYM
Scale 1:50

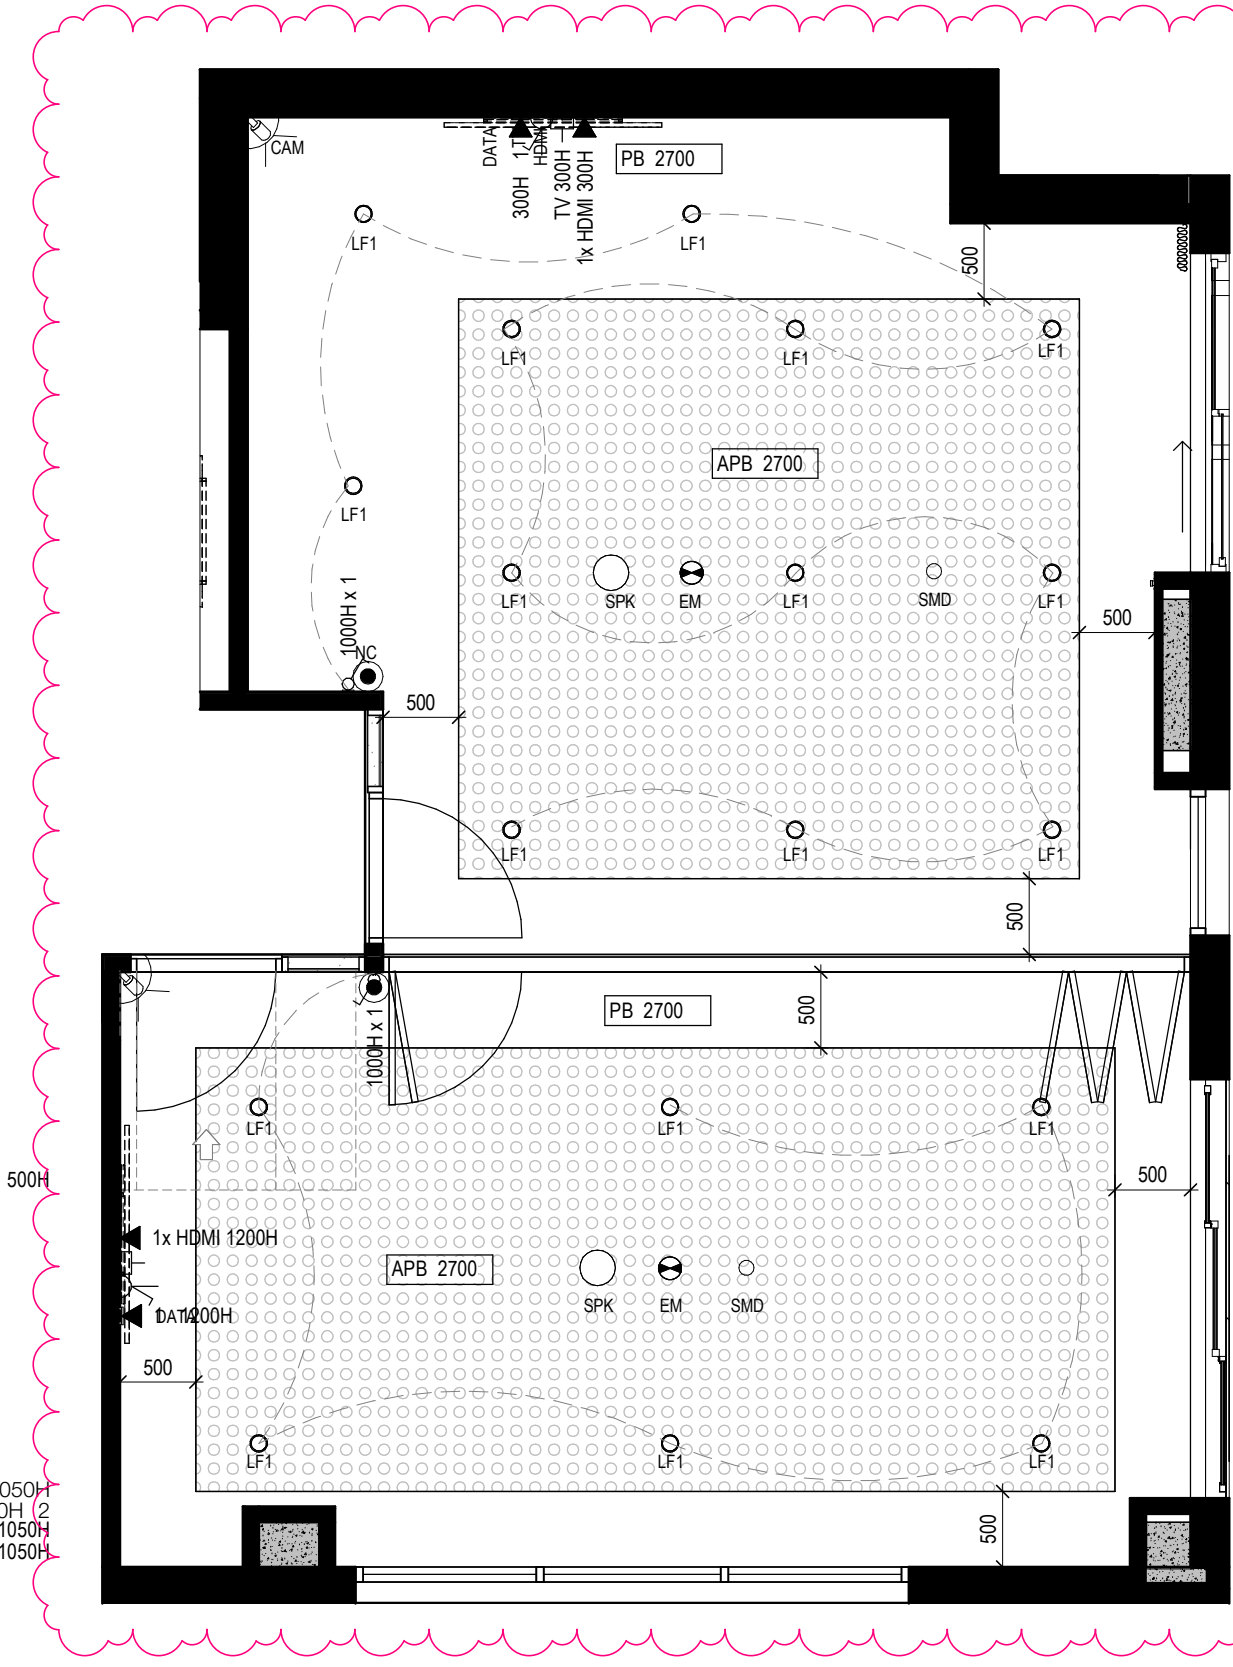


6 RCP - VILLAGE HEALTH & WELLNESS - GYM
Scale 1:50

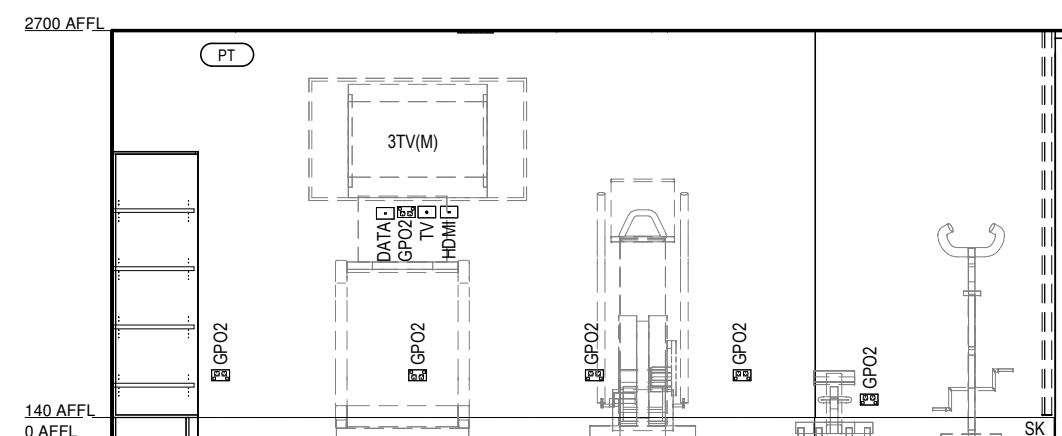


VILLAGE HEALTH & WELLNESS - GYM ELEVATION 1
Scale 1:50

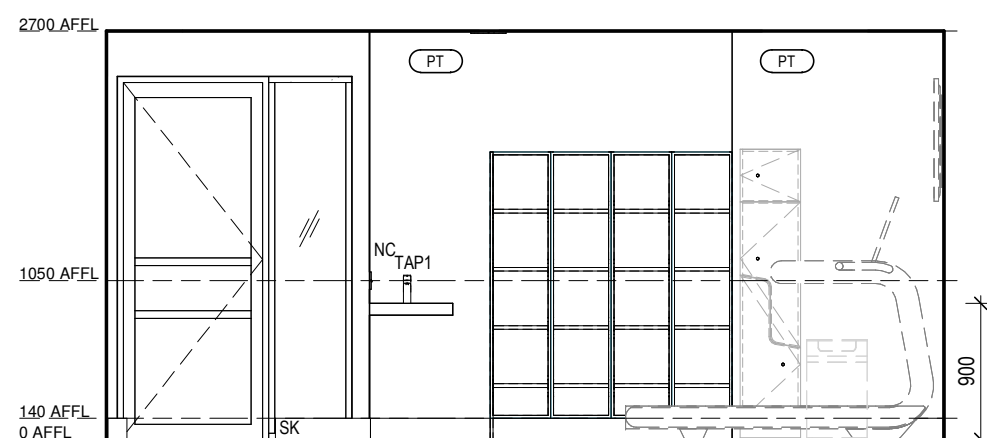


VILLAGE HEALTH & WELLNESS - GYM ELEVATION 2
Scale 1:50

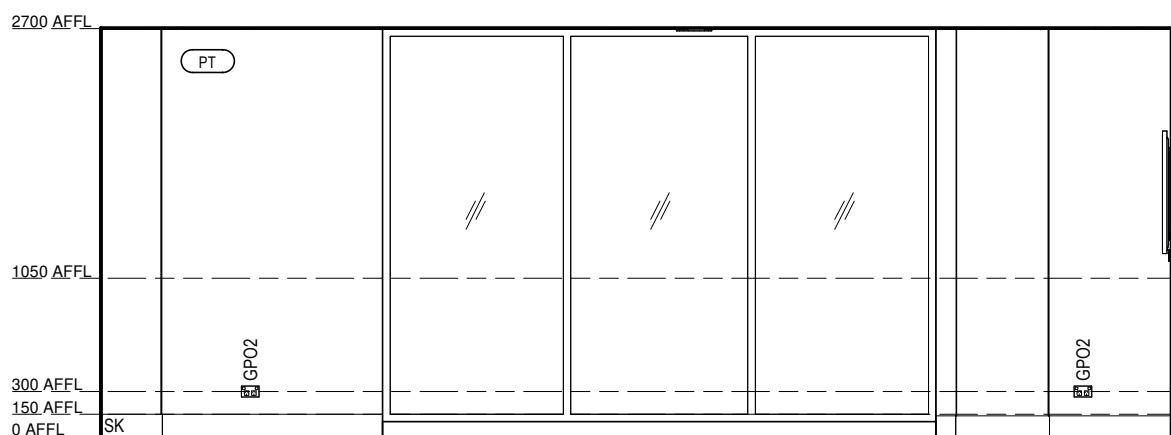


VILLAGE HEALTH & WELLNESS - GYM ELEVATION 3
Scale 1:50

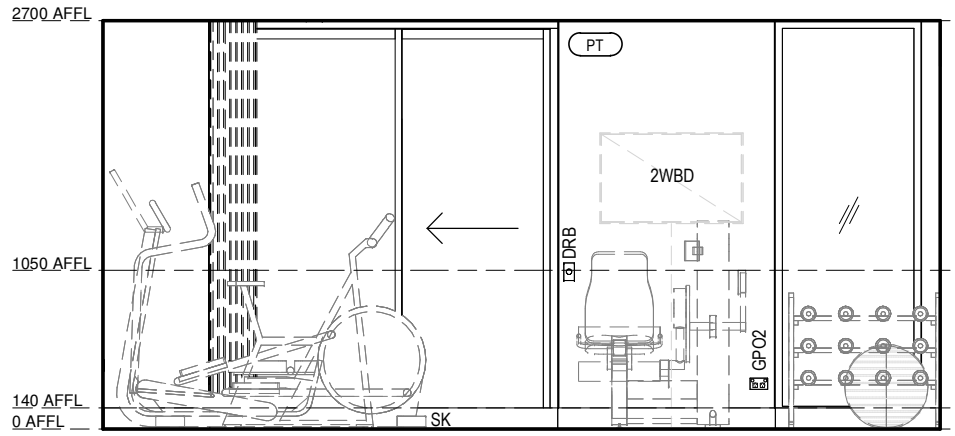


VILLAGE HEALTH & WELLNESS - GYM ELEVATION 4
Scale 1:50

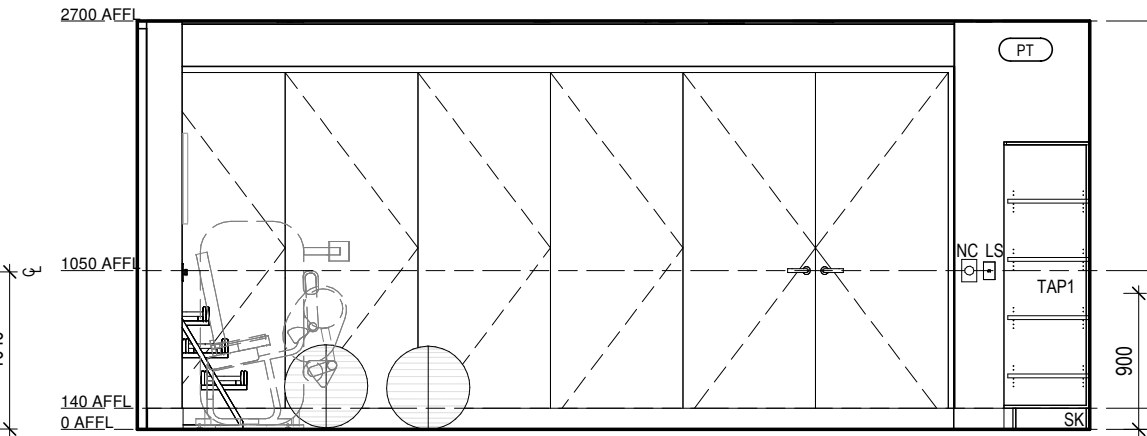

VILLAGE HEALTH & WELLNESS - GYM ELEVATION 5
Scale 1:50

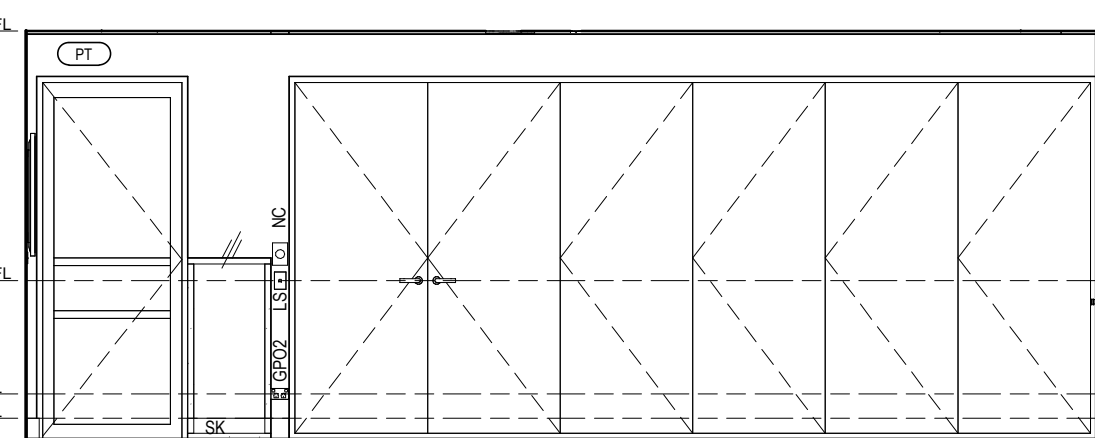

VILLAGE HEALTH & WELLNESS - GYM ELEVATION 6
Scale 1:50

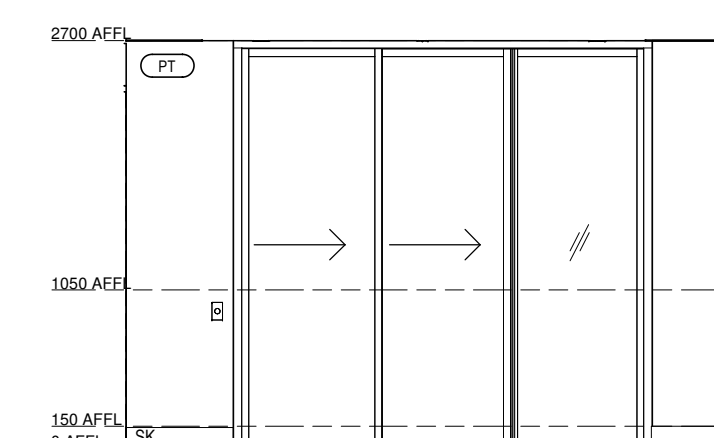

VILLAGE HEALTH & WELLNESS - GYM ELEVATION 7
Scale 1:50

Feature Artwork

Standard Artwork

X-SML
SML
MED
LRG
XLG

X-Small - 600 x 600

Small - 900 x 900

Medium - 1200 x 800

Large - 1500x 800

X-Large - 1800 x 800

PRELIMINARY

Revision/Issue	Date
a Issued for Coordination - 100% DD	2024.04.12
P1 Consolidated Set-to-date / SMG Comments	2025.08.15

Clarke
Hopkins
Clarke

Melbourne
L3, Melbourne Connect
700 Swanston Street
Carlton Victoria 3053
Telephone (03) 9419 4340
Email studio@chc.com.au
www.chc.com.au


Sydney
3/78 Campbell Street
Sunny Hills NSW 2010
Telephone (02) 9221 9200
Email studio@chc.com.au
www.chc.com.au

Scale	1:50 @ A1
Date	01/03/2024
Drawn	
Architect	


Project
Summerset Oakleigh
52 Golf Road, Oakleigh South, VIC

Drawing
Internal Elevations - Village Health &
Wellness - Salon, Consult & Gym


Drawing No.
230185/A1810
P1

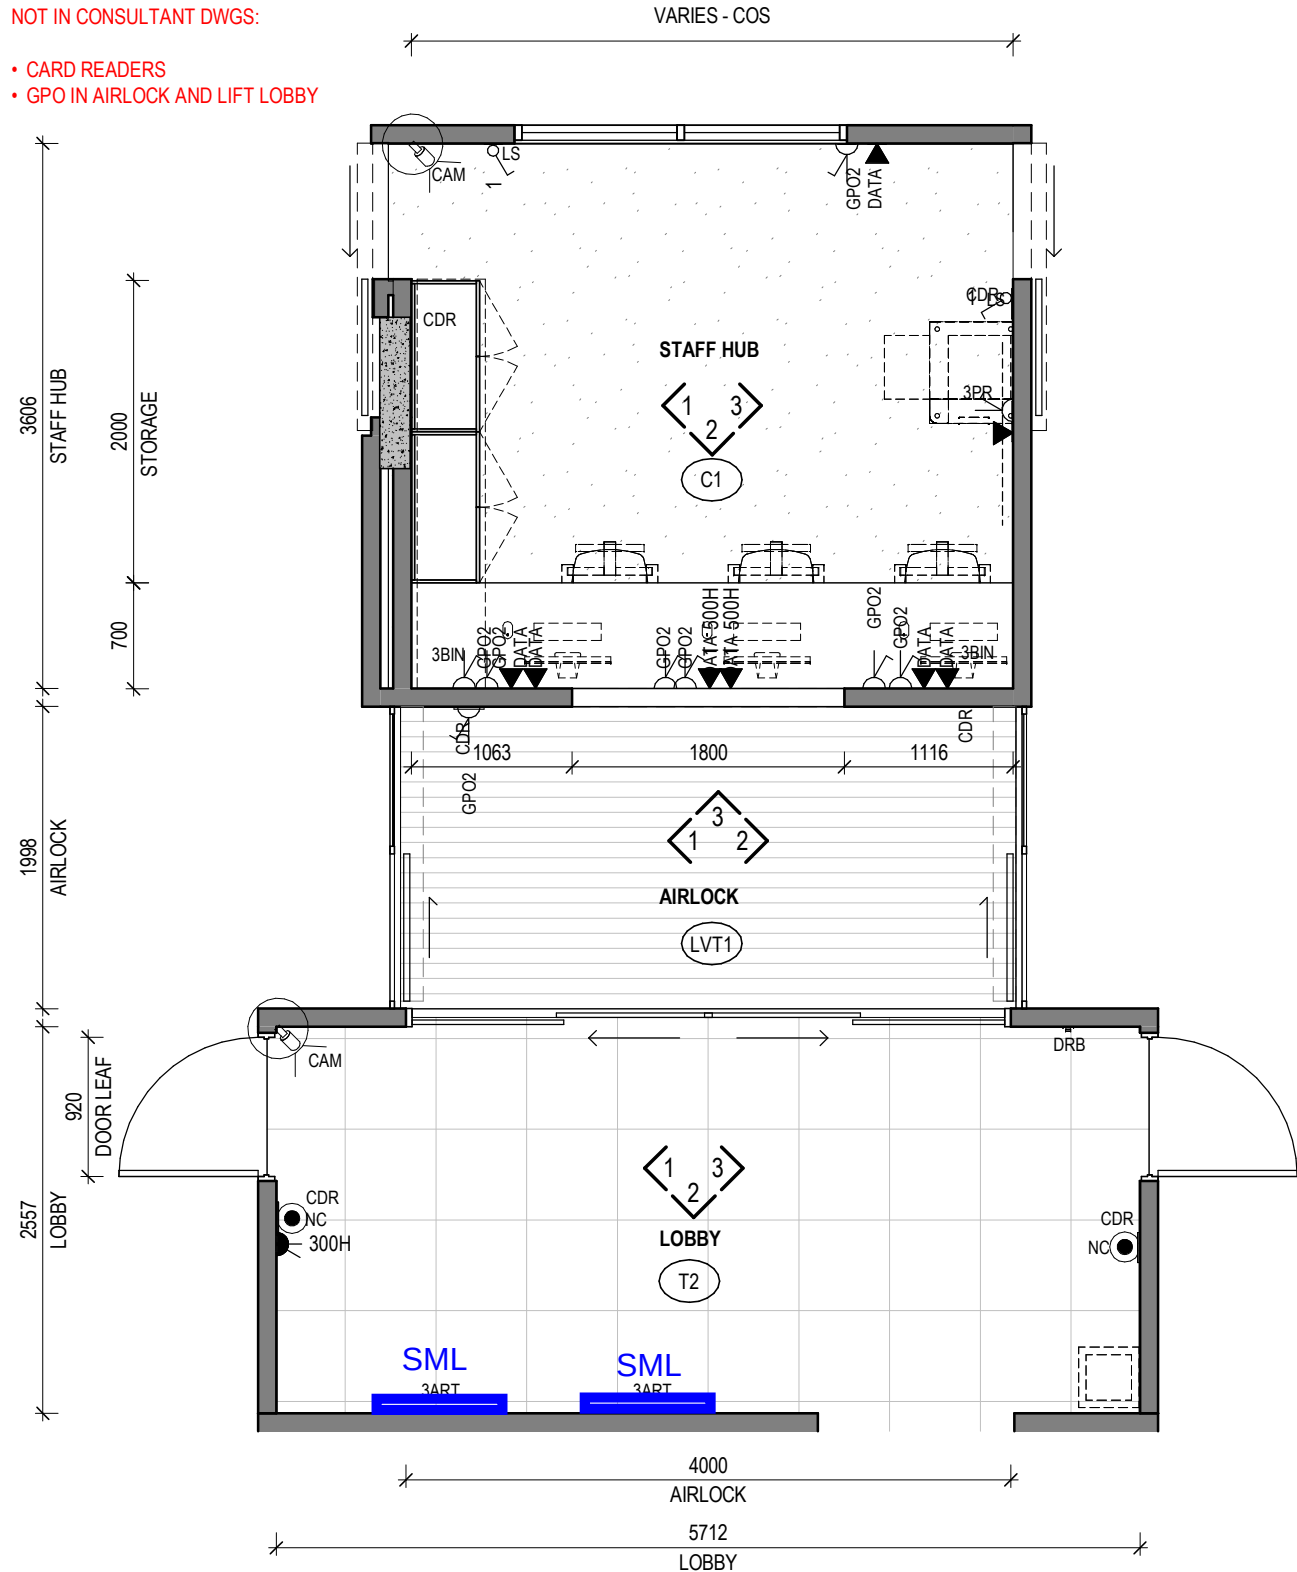


1 RACF COMMUNAL - LOBBY & STAFF HUB
Scale 1 : 50

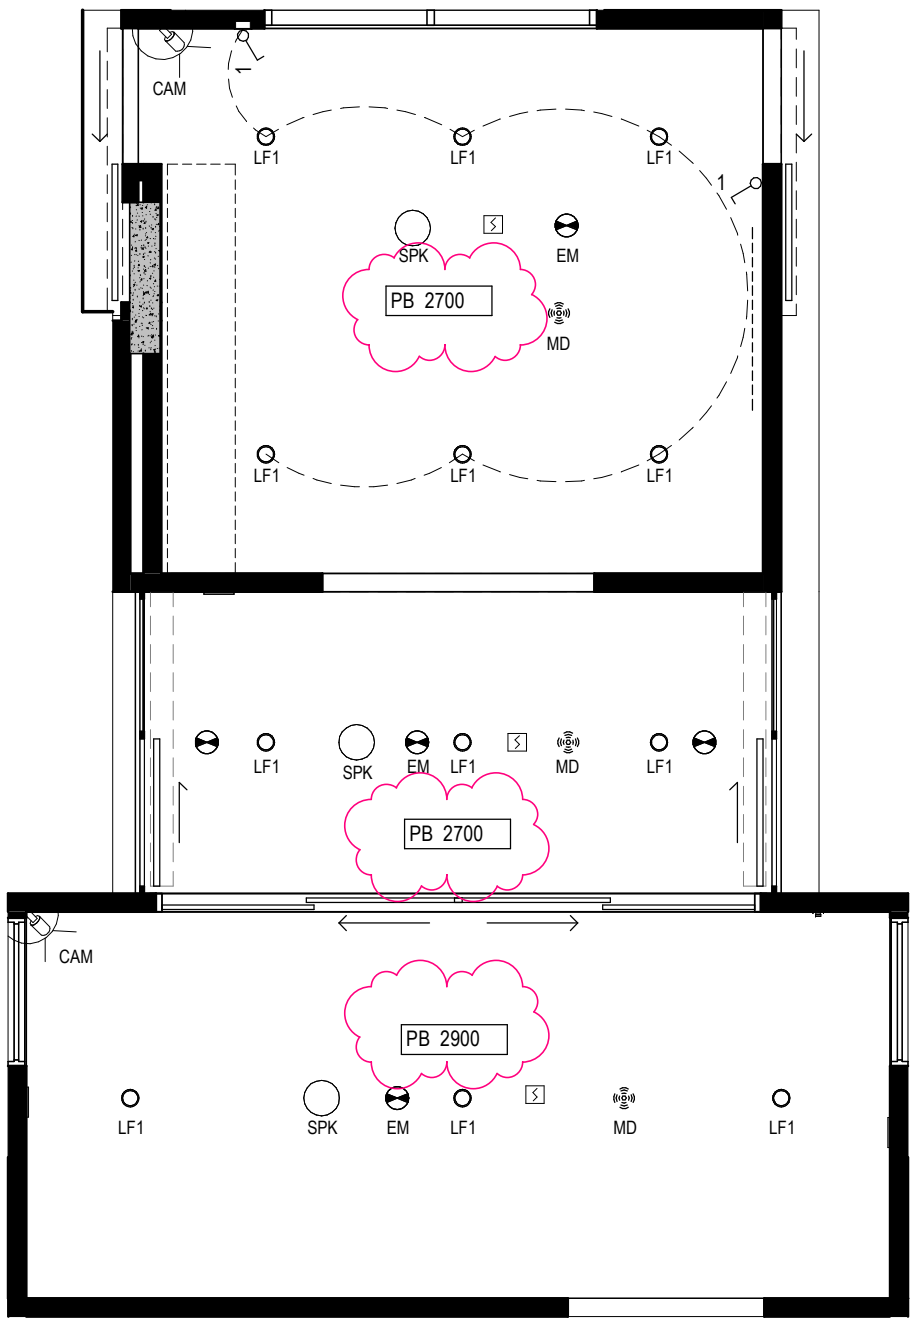


2 RCP - RACF COMMUNAL - LOBBY & STAFF HUB
Scale 1 : 50

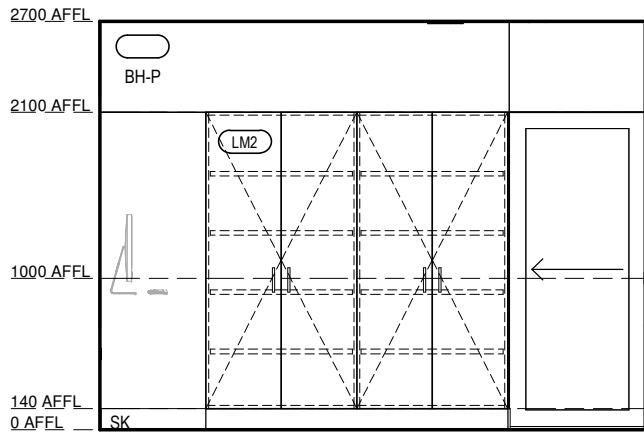


RACF COMMUNAL - STAFF HUB - ELEVATION 1
Scale 1 : 50

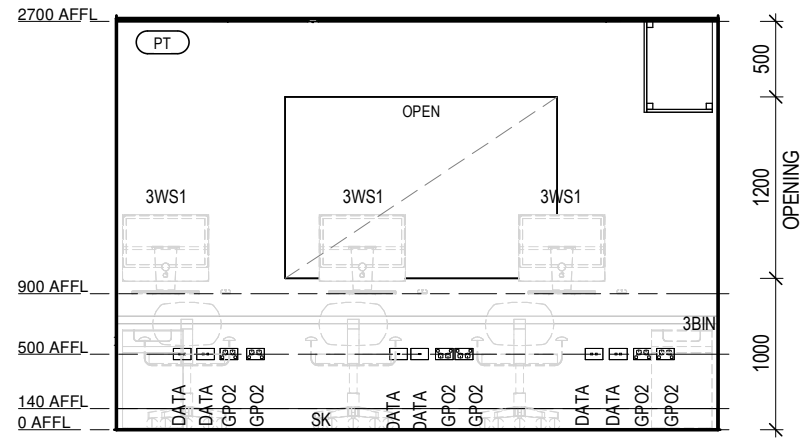


RACF COMMUNAL - STAFF HUB - ELEVATION 2
Scale 1 : 50

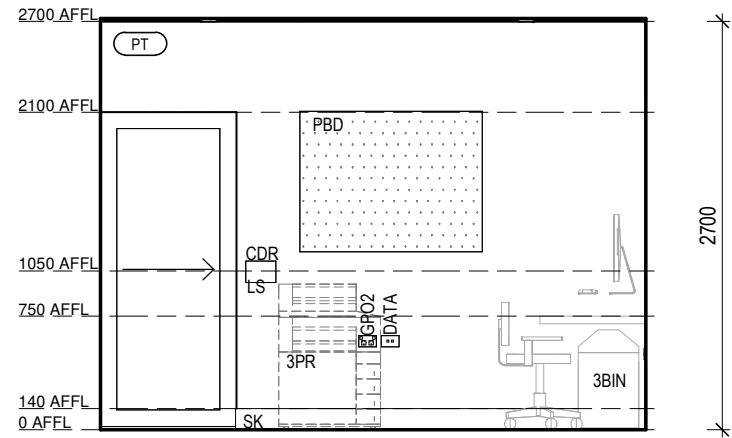


RACF COMMUNAL - STAFF HUB ELEVATION 3
Scale 1 : 50

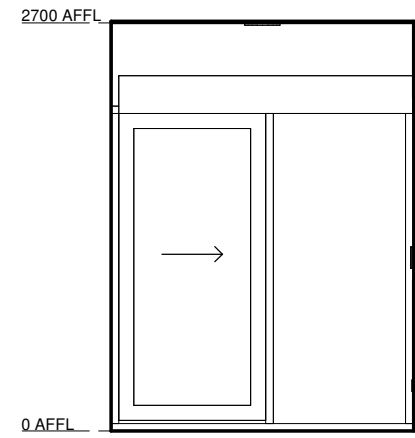


RACF COMMUNAL - AIRLOCK ELEVATION 1
Scale 1 : 50

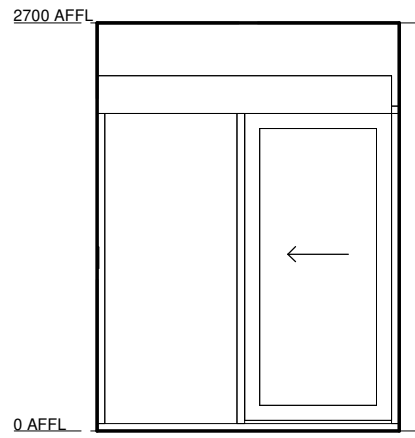


RACF COMMUNAL - AIRLOCK ELEVATION 2
Scale 1 : 50

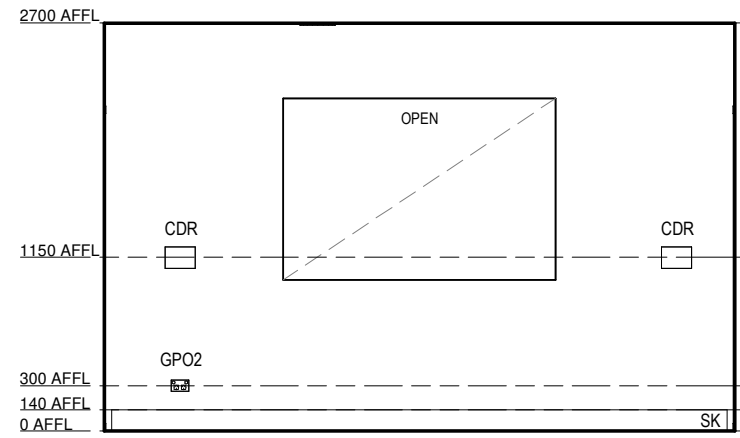


RACF COMMUNAL - AIRLOCK ELEVATION 3
Scale 1 : 50

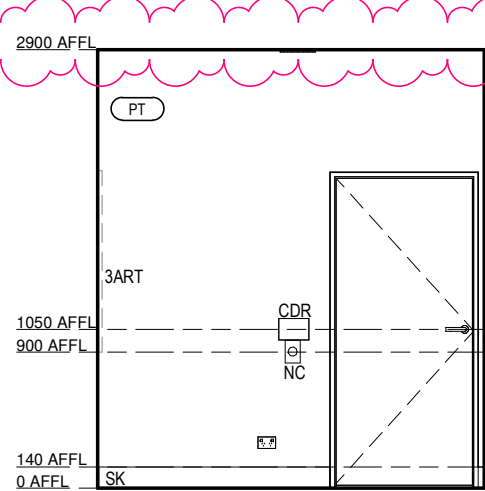

RACF COMMUNAL - LIFT LOBBY ELEVATION 1
Scale 1 : 50

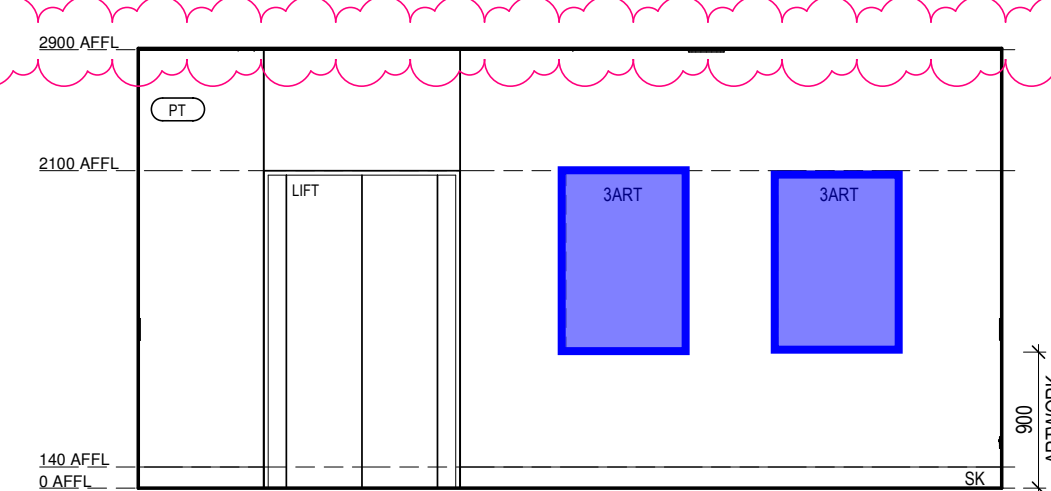


RACF COMMUNAL - LIFT LOBBY ELEVATION 2
Scale 1 : 50

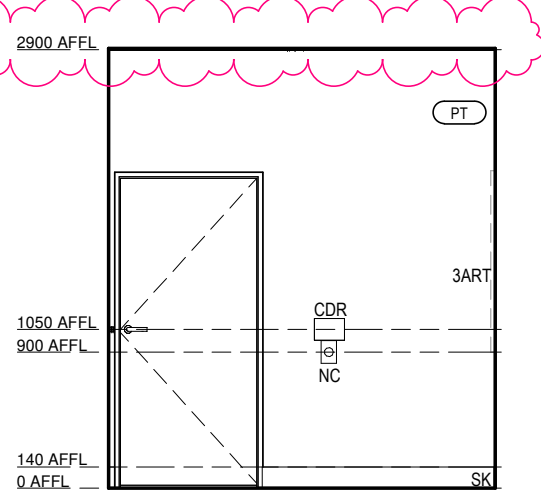


RACF COMMUNAL - LIFT LOBBY ELEVATION 3
Scale 1 : 50


LEVEL 2 ONLY - LEVEL 1 STORAGE SPACE
AND CLINICAL MANAGERS OFFICE

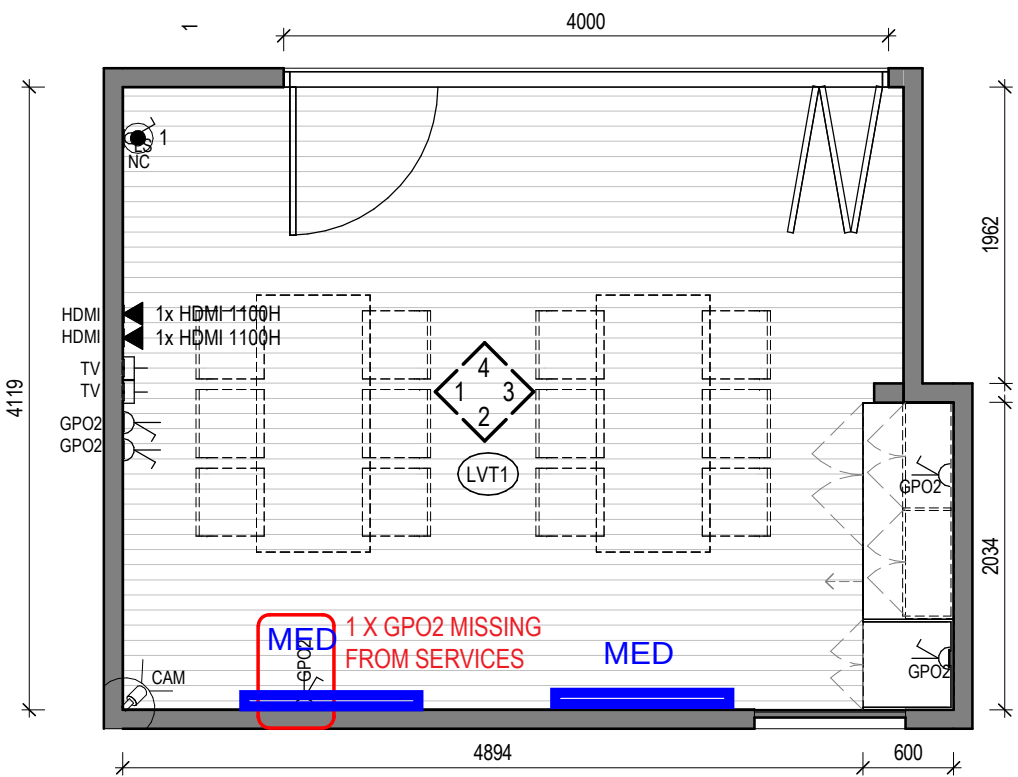


3 RACF COMMUNAL - ACTIVITY ROOM
Scale 1 : 50

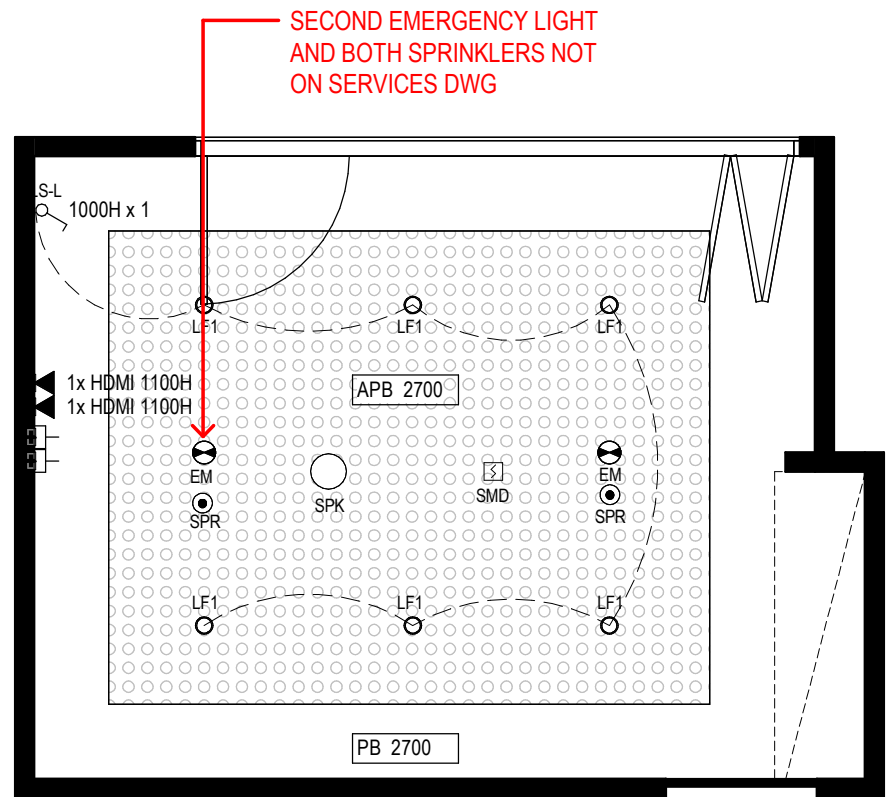


4 RCP - RACF COMMUNAL - ACTIVITY
Scale 1 : 50

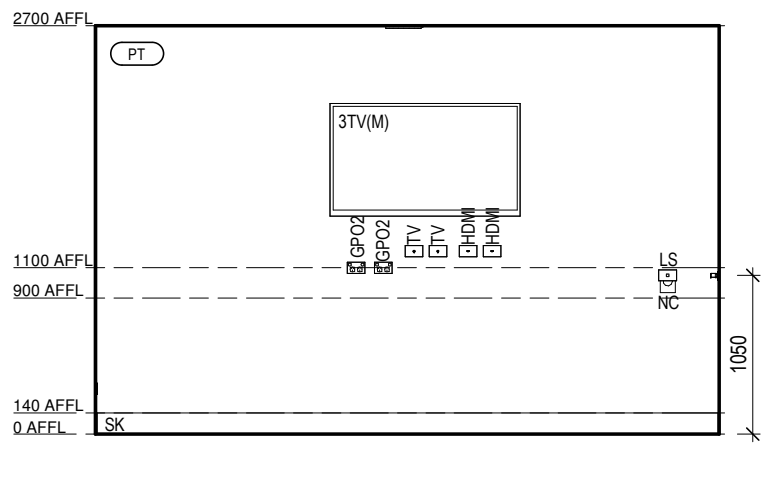


RACF COMMUNAL - ACTIVITY ELEVATION 1
Scale 1 : 50

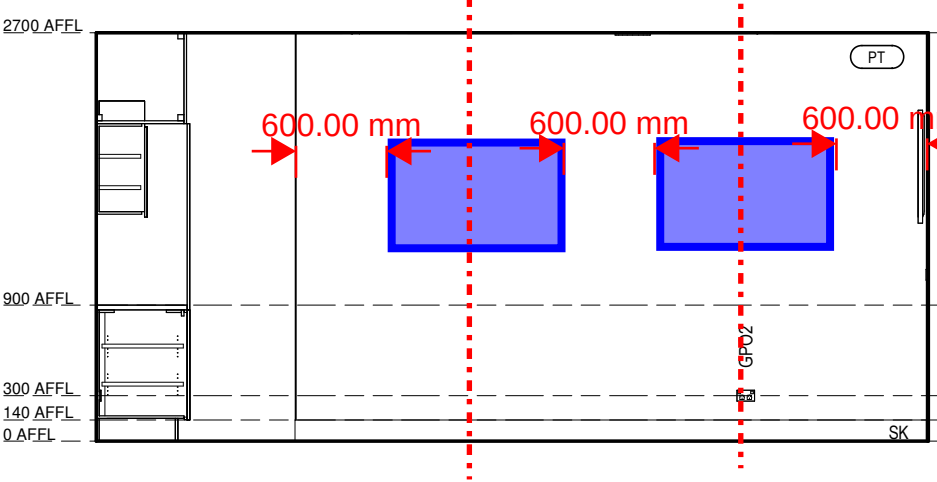

RACF COMMUNAL - ACTIVITY ELEVATION 2
Scale 1 : 50

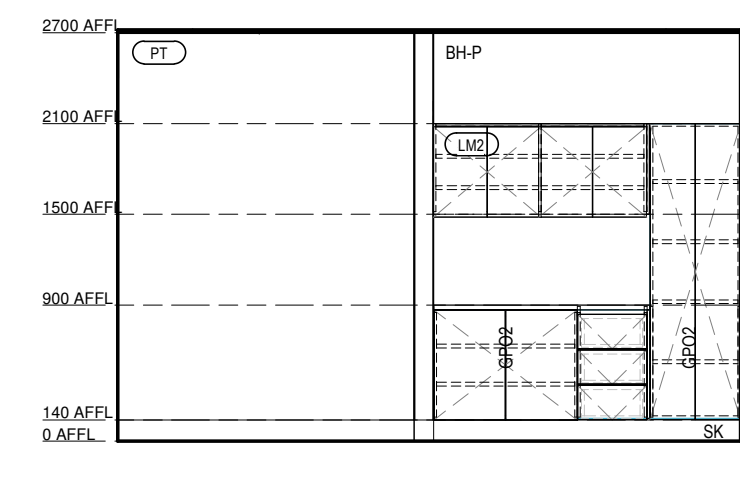

RACF COMMUNAL - ACTIVITY ELEVATION 3
Scale 1 : 50

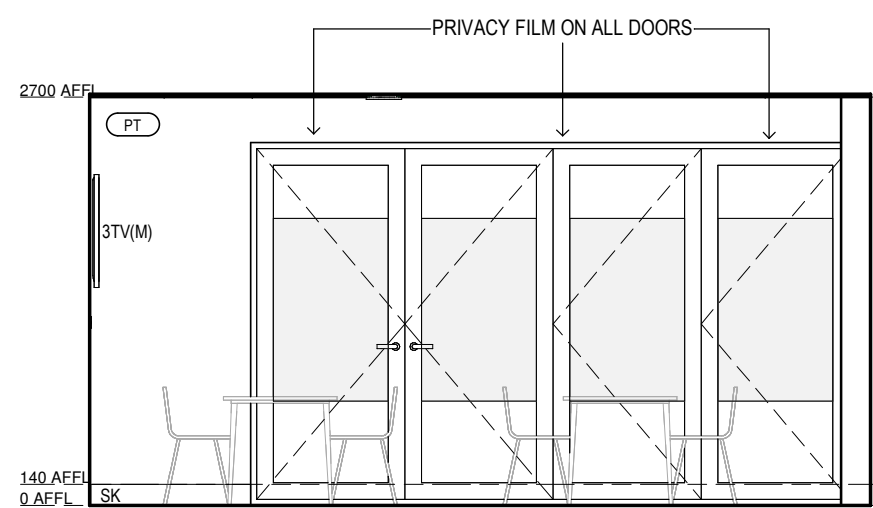

RACF COMMUNAL - ACTIVITY ELEVATION 4
Scale 1 : 50

Legend - Internal Elevations

DRAWINGS TO BE READ IN CONJUNCTION WITH ARCHITECTURAL SPECIFICATION & MATERIALS, PRODUCTS & FINISHES SCHEDULE.

PT# PAINT FINISH TO ALL WALLS WITHIN NEW & AFFECTED ROOMS/ AREAS UNLESS OTHERWISE SHOWN

- CSE CONCRETE SEALER
- DPR DOOR PROTECTION
- GD GRAPHIC FILM
- LM LAMINATE
- MI MIRROR
- PBD PINBOARD
- PT PAINT FINISH
- REN RENDER FINISH
- SB SPLASHBACK
- STN STONE
- WB WHITEBOARD
- WP WALL PROTECTION
- WT WALL TILE
- WV WALL VINYL

NOTES:
1. LAMINATE CARCASS FOR ALL VISIBLE OPEN SHELVING, UNLESS OTHERWISE NOTED
2. MELAMINETO ALL INTERNAL CARCASS OF JOINERY, UNLESS OTHERWISE NOTED.

Legend - Floor Finishes

- C CARPET
- CO CONCRETE
- D DECKING
- E EPOXY FINISH
- L LINOLEUM
- M MATTING
- PF PARTICLEBOARD FLOORING
- PU PAVING UNIT - TBC WITH LANDSCAPE
- PW PLYWOOD
- R RUBBER FLOORING
- T TILING
- TF TIMBER FLOORING
- V VINYL

Keynote Legend

- 3ART ARTWORK - GROUP 3
- 3BIN WASTE BIN - GROUP 3
- 3PR PRINTER - GROUP 3
- 3TV(M) TELEVISION SCREEN 55 INCH - GROUP 3
- 3WS1 WORK STATION - GROUP 3
- BHP BULKHEAD - PLASTERBOARD TYPE
- CAM CCTV CAMERA
- CDR CARD READER
- DATA DATA OUTLET
- DRB DOOR RELEASE BUTTON
- EM EMERGENCY LIGHT
- GPO2 POWER OUTLET - DOUBLE
- HDMI HDMI OUTLET
- LF1 LIGHT FITTING - TYPE 1
- LS LIGHT SWITCH
- LS-L LIGHT SWITCH - LARGE PLATE
- MD MOTION DETECTOR
- NC NURSE CALL
- PBD PINBOARD - FRAMED
- SK SKIRTING
- SMD SMOKE DETECTOR
- SPK ANUNCIATOR
- SPR SPRINKLER
- TV TELEVISION COAXIAL OUTLET

Feature Artwork

Standard Artwork

- X-SML X-Small - 600 x 600
- SML Small - 900 x 900
- MED Medium - 1200 x 800
- LRG Large - 1500x 800
- XLG X-Large - 1800 x 800

PRELIMINARY

Revision/Issue	Date
a Issued for Coordination - 100% DD	2024.04.12
P1 Preliminary Internal Elevations - RACF	2025.08.08
P2 Consolidated Set-to-date / SMG Comments	2025.08.15

Clarke
Hopkins
Clarke

ClarkeHopkinsClarke

Melbourne

L3, Melbourne Connect

700 Swanston Street

Carlton Victoria 3053

Telephone (03) 9419 4340

Email studio@chc.com.au

Sydney

3/78 Campbell Street

Sunny Hills NSW 2010

Telephone (02) 9221 9200

Email studio@chc.com.au

www.chc.com.au

Scale	As indicated @ A1
Date	01/03/2024
Drawn	Author
Architect	Checker


Project
Summerset Oakleigh
52 Golf Road, Oakleigh South, VIC

Drawing
Internal Elevations - RACF Communal -
Lobby, Staff Hub & Activity Room


Drawing No.

230185/A1815


P2

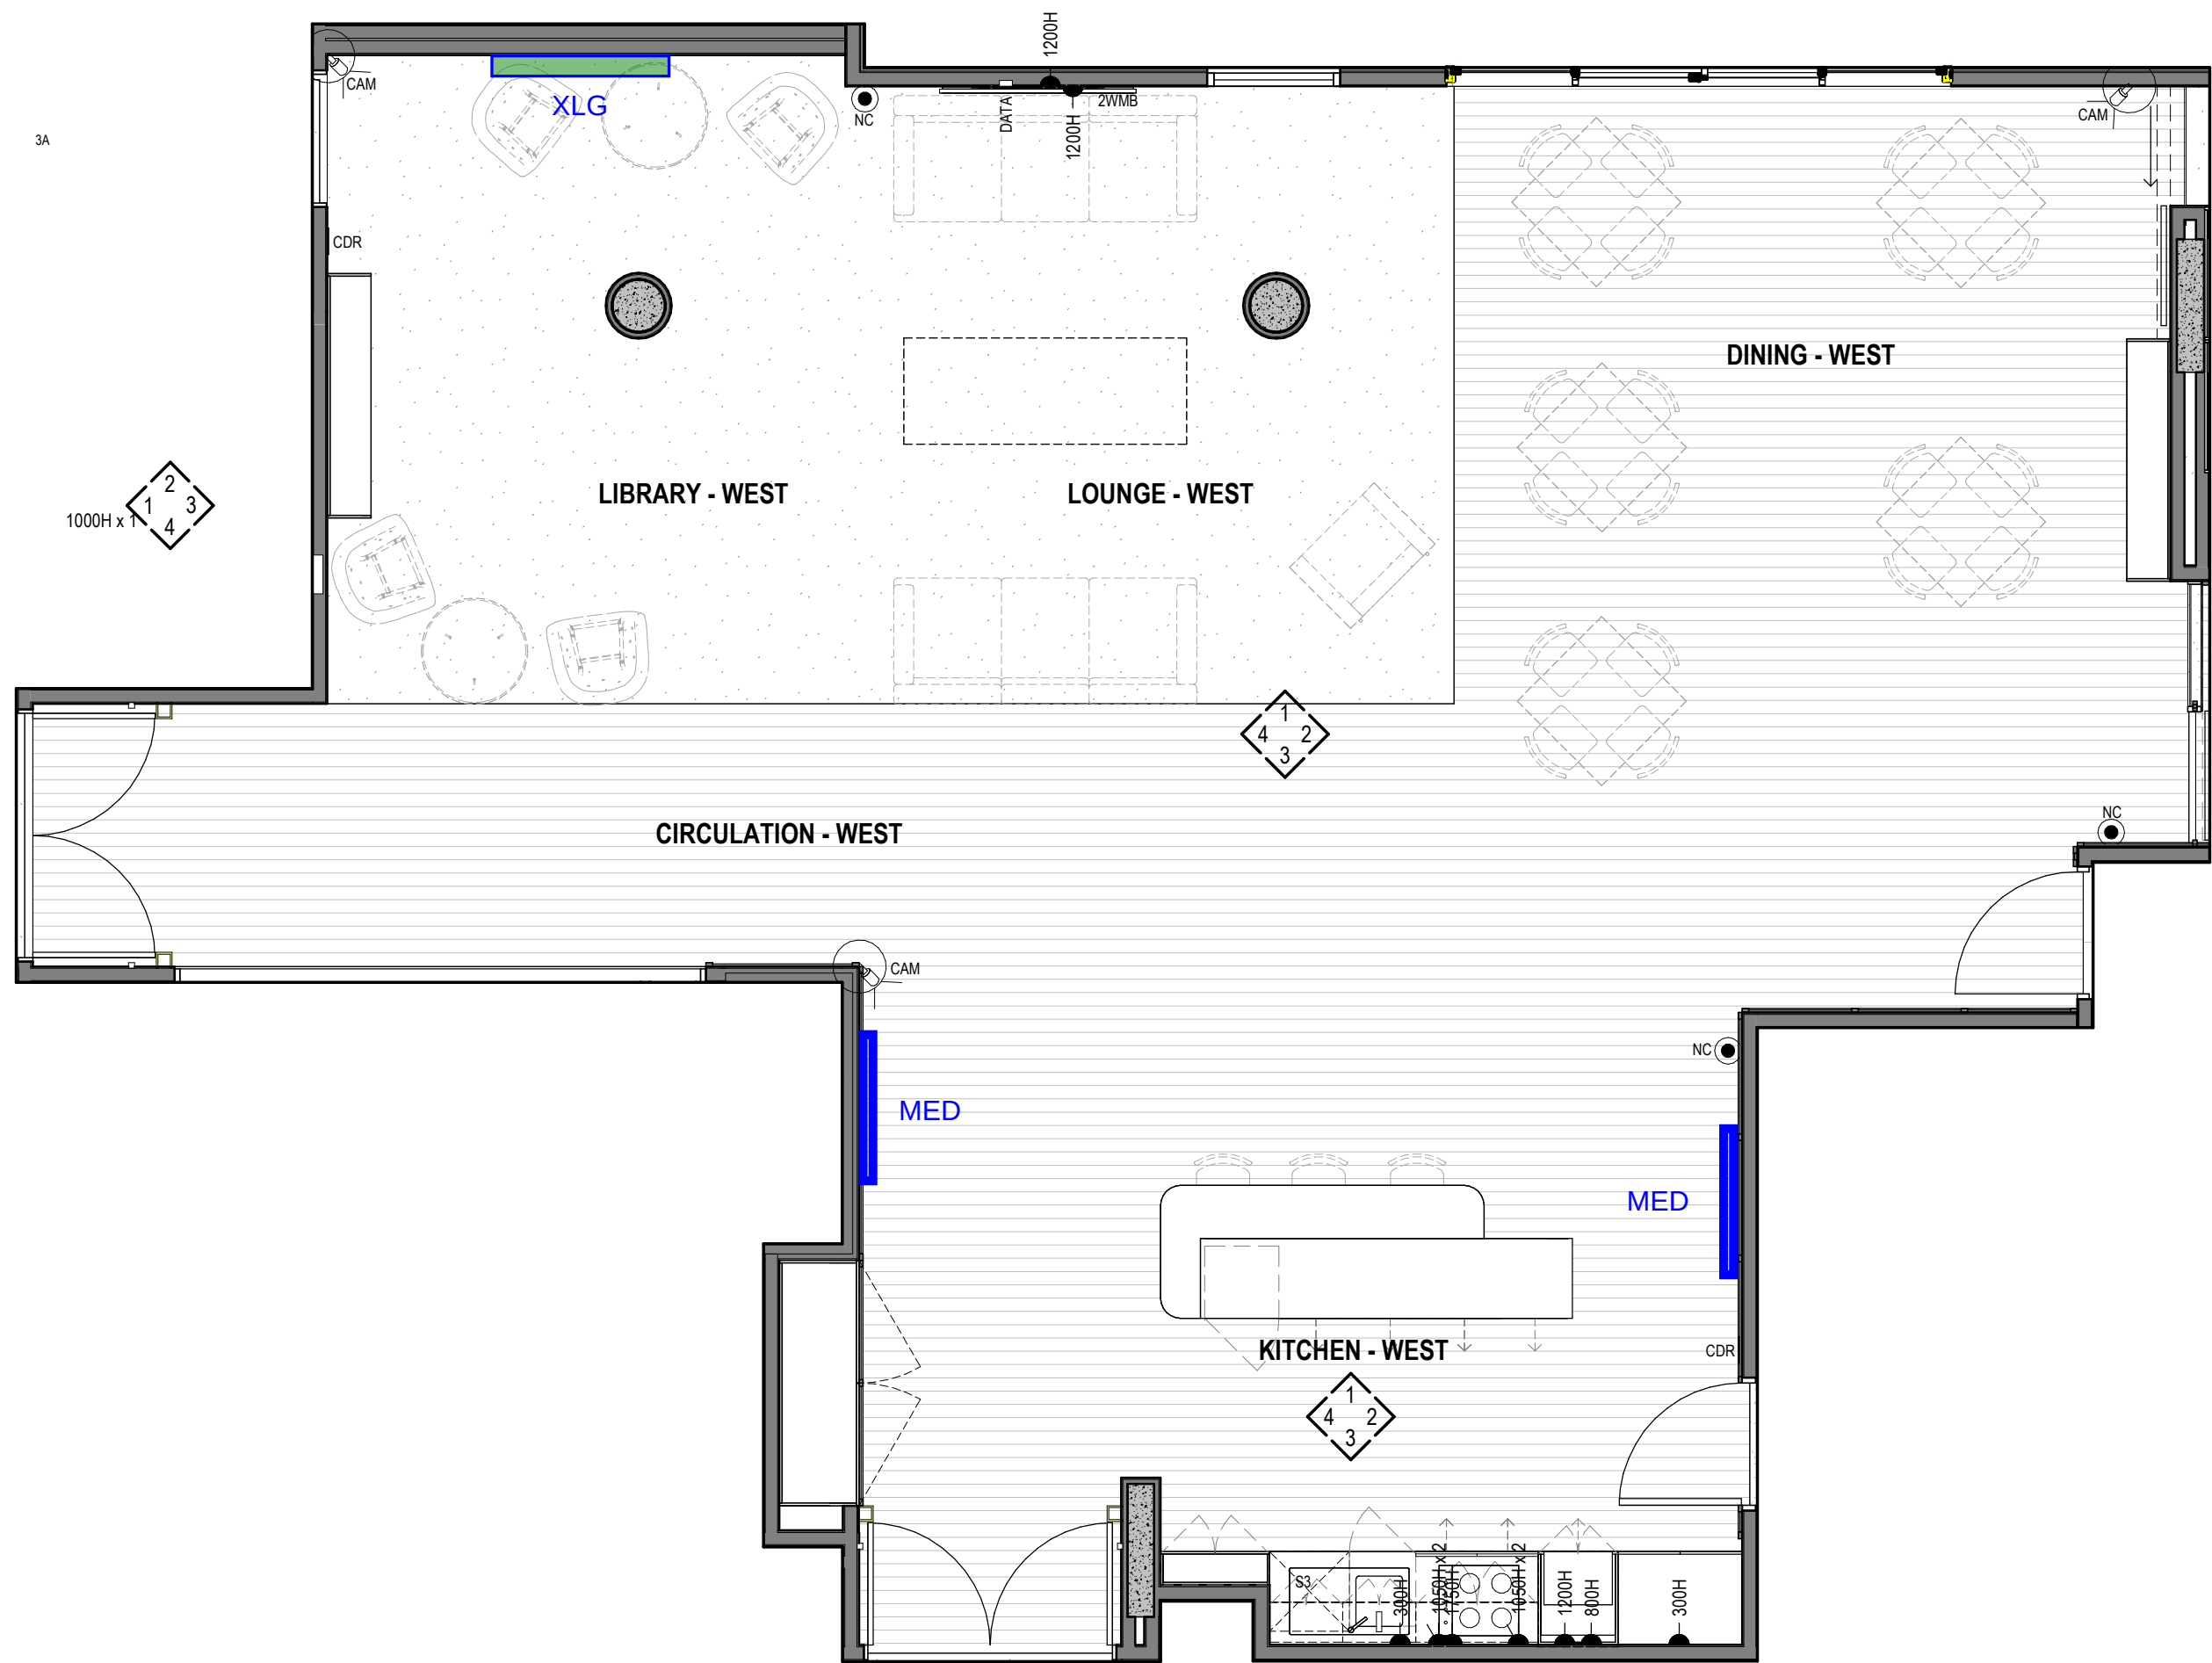


1 RACF Communal Kitchen, Living, Dining - West
Scale 1 : 50

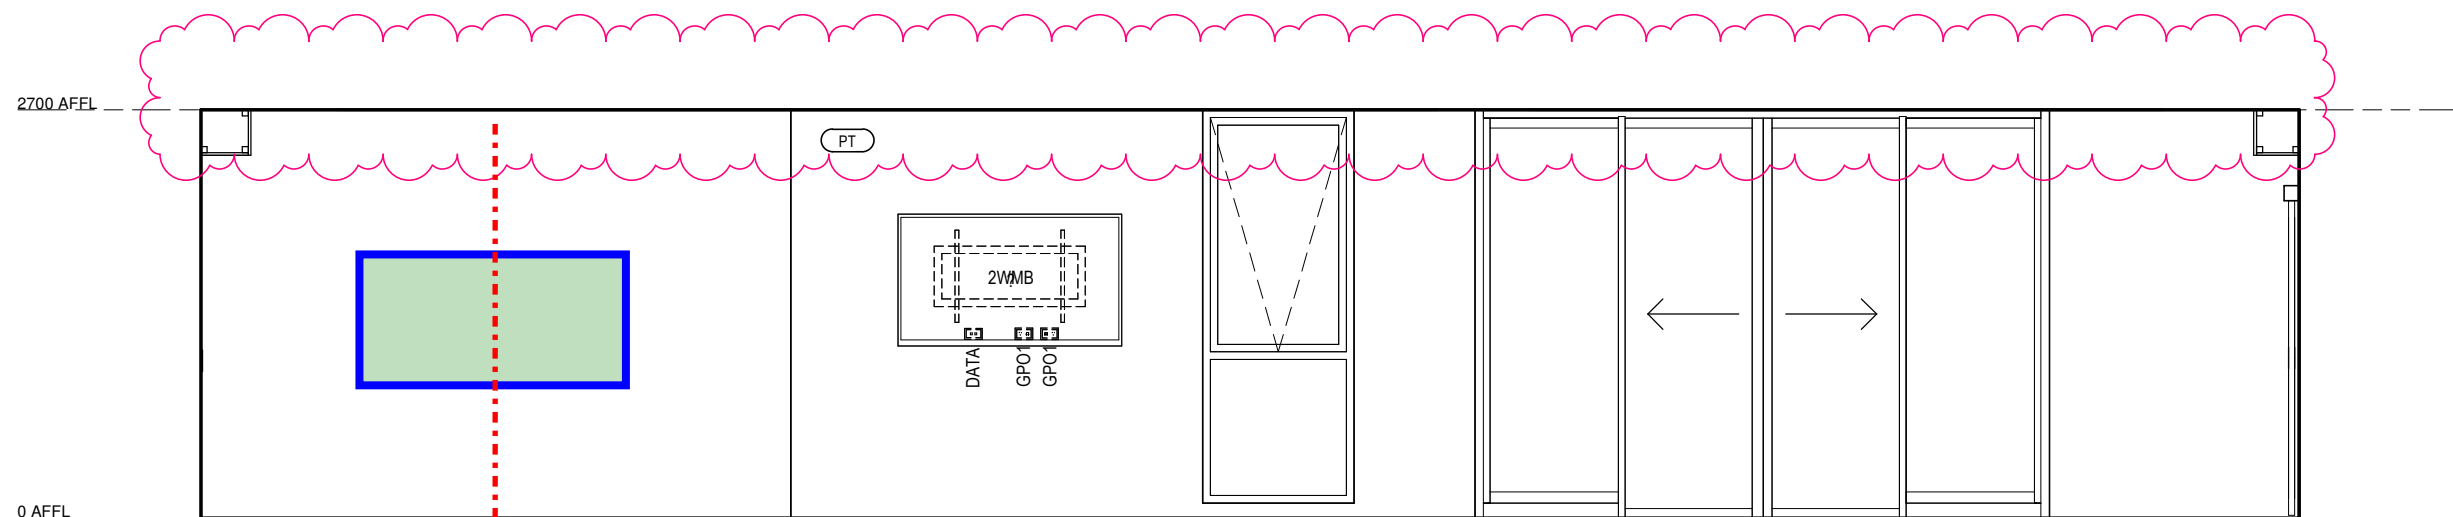


RACF - LIBRARY, LOUNGE & DINING - ELEVATION 1
Scale 1 : 50

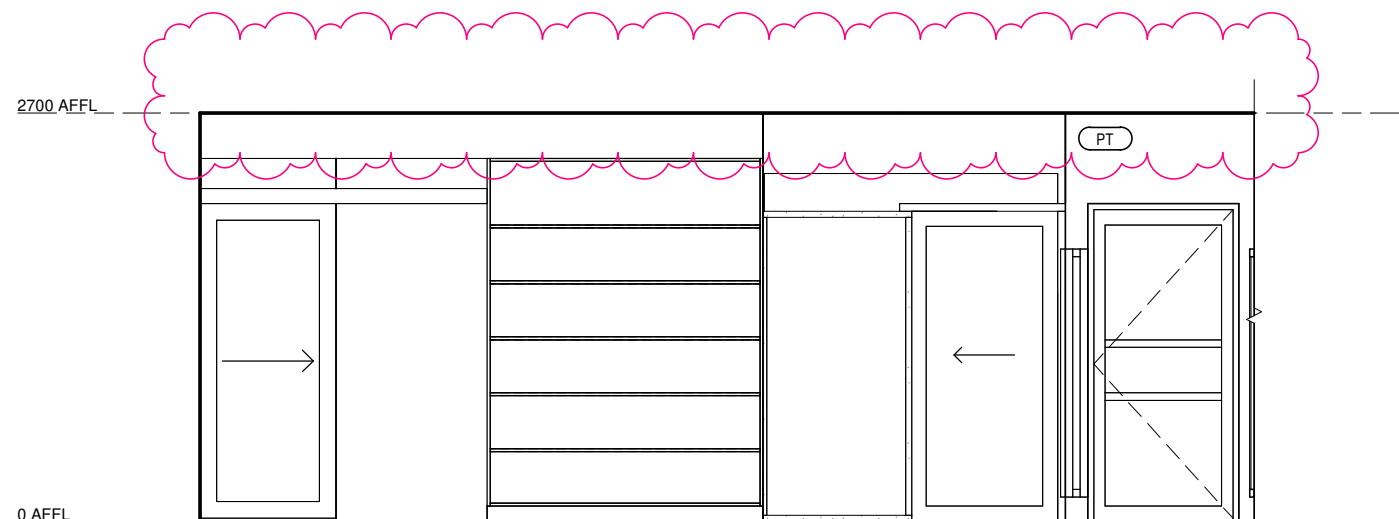


RACF - LIBRARY, LOUNGE & DINING - ELEVATION 2
Scale 1 : 50

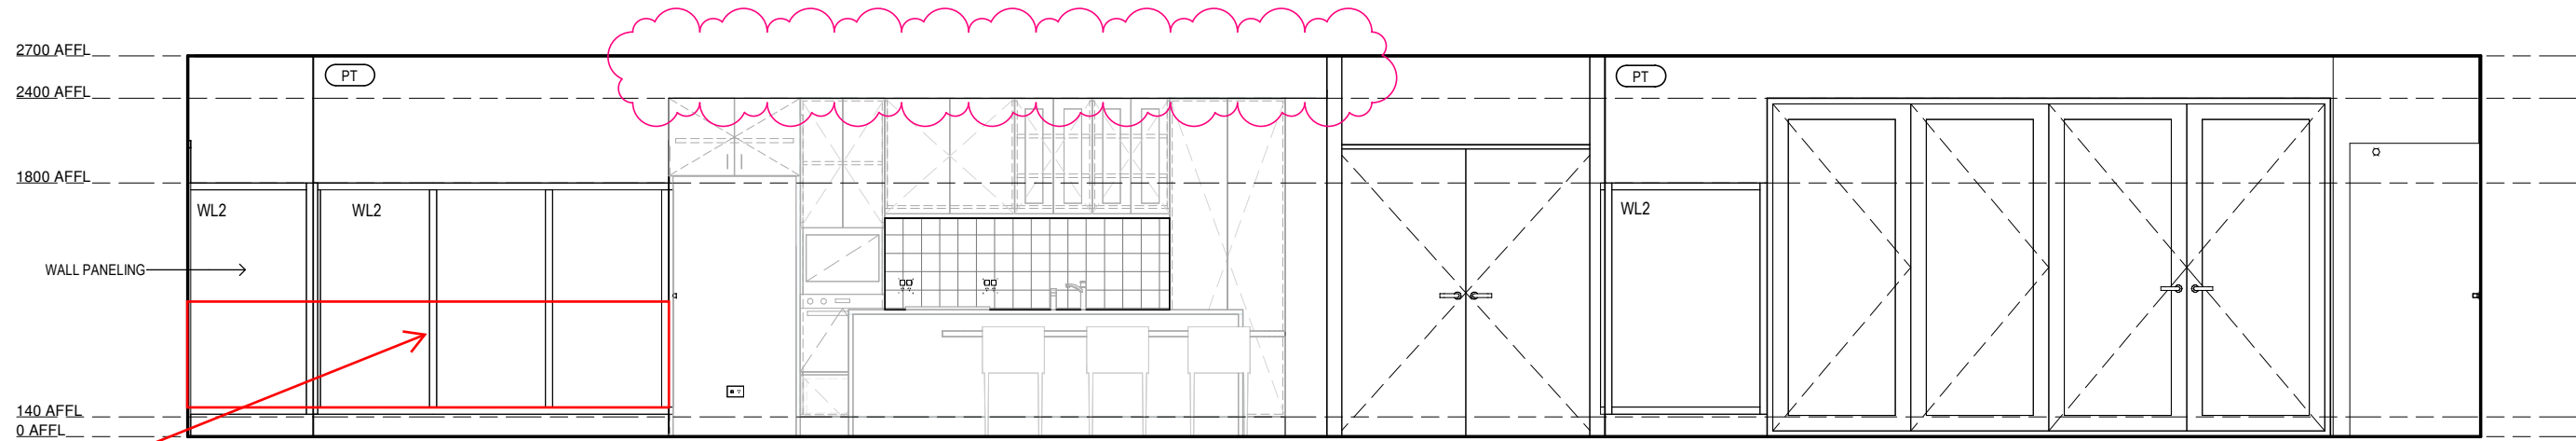


RACF Communal Living, Dining and Library - West - Elevation 3
Scale 1 : 50

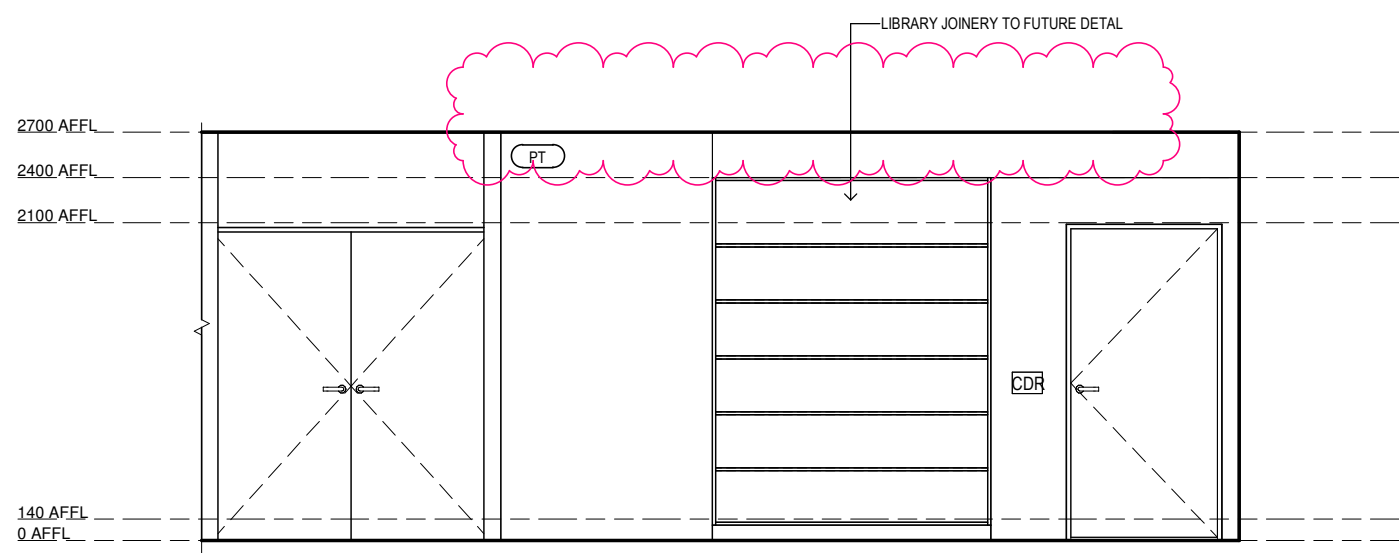


RACF Communal Living, Dining and Library - West - Elevation 4
Scale 1 : 50

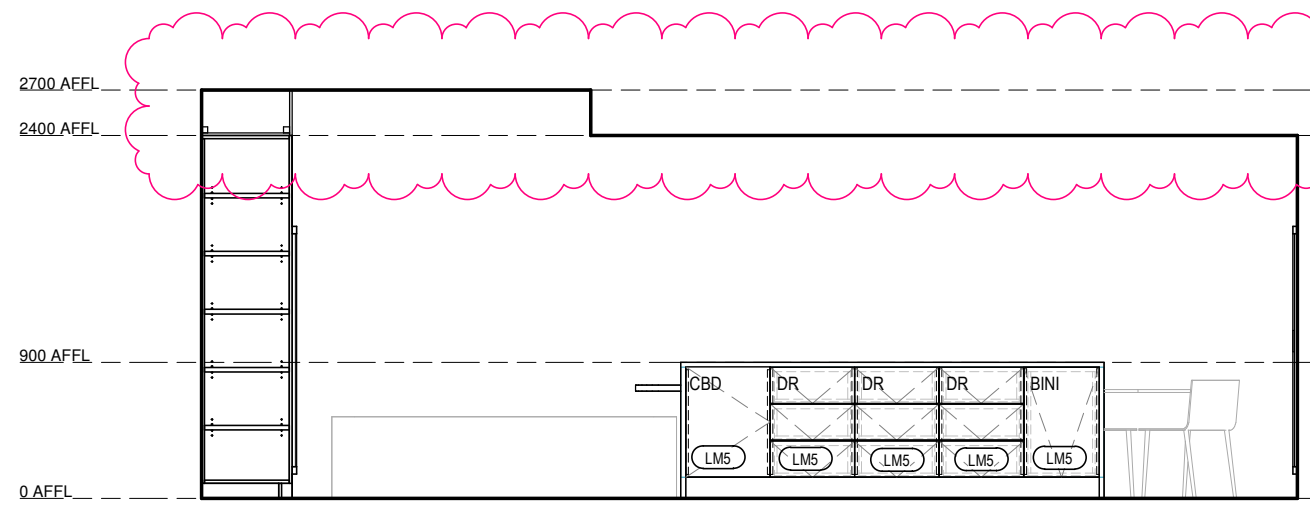


RACF Resident Kitchen - West - Elevation 1
Scale 1 : 50

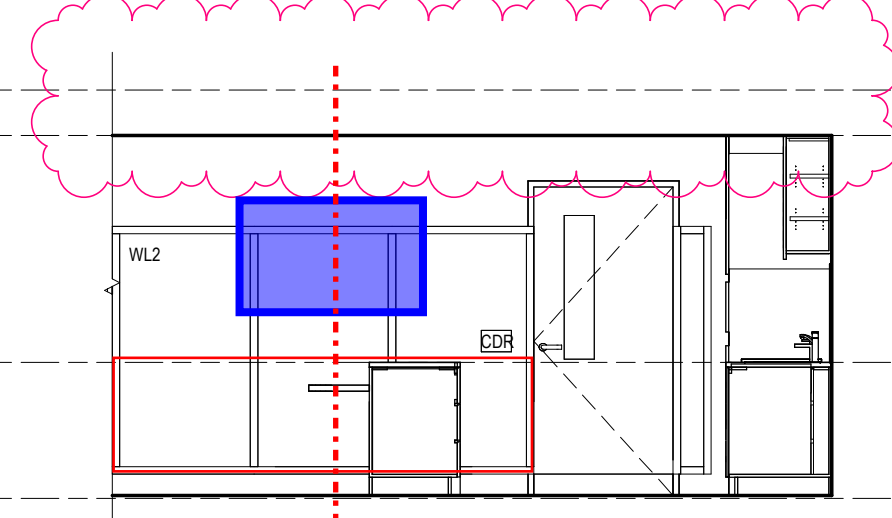

RACF Resident Kitchen - West - Elevation 2
Scale 1 : 50

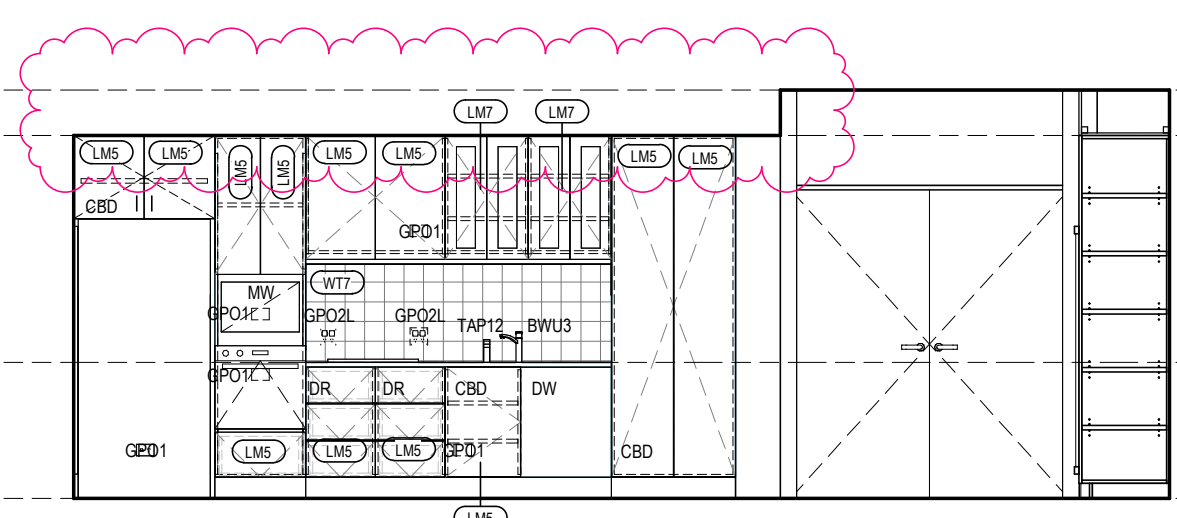

RACF Resident Kitchen - West - Elevation 3
Scale 1 : 50

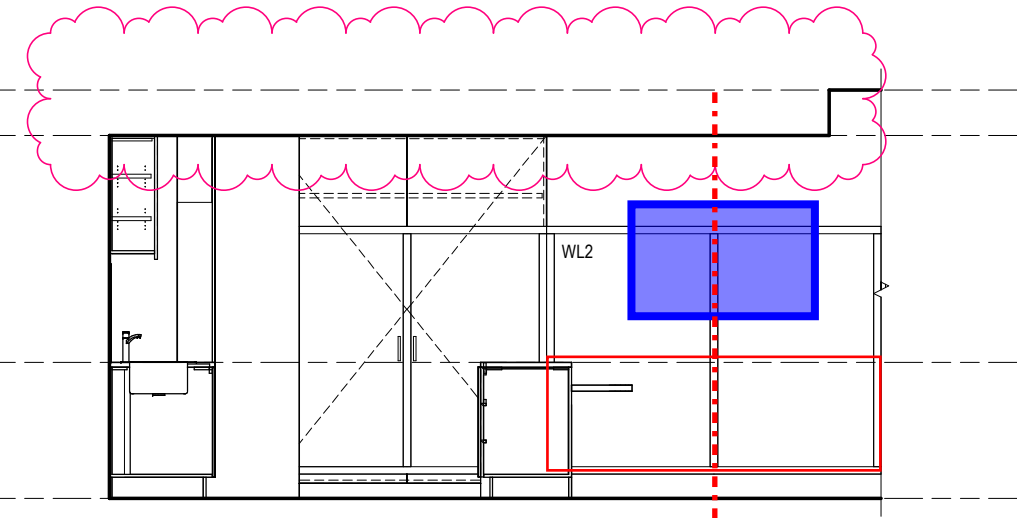

RACF Resident Kitchen - West - Elevation 4
Scale 1 : 50

Legend - Internal Elevations

DRAWINGS TO BE READ IN CONJUNCTION WITH ARCHITECTURAL SPECIFICATION & MATERIALS, PRODUCTS & FINISHES SCHEDULE.

PT# PAINT FINISH TO ALL WALLS WITHIN NEW & AFFECTED ROOMS/ AREAS UNLESS OTHERWISE SHOWN

- CSE CONCRETE SEALER
- DPR DOOR PROTECTION
- GD GRAPHIC FILM
- LM LAMINATE
- MI MIRROR
- PBD PINBOARD
- PT PAINT FINISH
- REN RENDER FINISH
- SB SPLASHBACK
- STN STONE
- WB WHITEBOARD
- WP WALL PROTECTION
- WT WALL TILE
- WV WALL VINYL

NOTES:
1. LAMINATE CARCASS FOR ALL VISIBLE OPEN SHELVING, UNLESS OTHERWISE NOTED
2. MELAMINETO ALL INTERNAL CARCASS OF JOINERY, UNLESS OTHERWISE NOTED.

Legend - Floor Finishes

- C CARPET
- CO CONCRETE
- D DECKING
- E EPOXY FINISH
- L LINOLEUM
- M MATTING
- PF PARTICLEBOARD FLOORING
- PU PAVING UNIT - TBC WITH LANDSCAPE
- PW PLYWOOD
- R RUBBER FLOORING
- T TILING
- TF TIMBER FLOORING
- V VINYL

Keynote Legend

- 2WMB TV WALL MOUNTED BRACKET - GROUP 2
- BN BN - INTEGRATED
- BNW3 BOILING WATER UNIT - TYPE 3
- CAM CCTV CAMERA
- CBD CUPBOARD
- CDR CARD READER
- DATA DATA OUTLET
- DR DRAWER
- DW DISHWASHER
- GP01 POWER OUTLET - SINGLE
- GP02L POWER OUTLET - DOUBLE - LARGE PLATE
- MW MICROWAVE - GROUP 3
- NC NURSE CALL
- S3 SINK - TYPE 3
- TAP12 TAP - TYPE 12
- WL2 WALL PANNELLING - TYPE 2

Feature Artwork

Standard Artwork

- X-SML X-Small - 600 x 600
- SML Small - 900 x 900
- MED Medium - 1200 x 800
- LRG Large - 1500x 800
- XLG X-Large - 1800 x 800

Revision/Issue	Date
P1 Preliminary Internal Elevations - RACF	2025.08.08
P2 Consolidated Set-to-date / SMG Comments	2025.08.15



**Clarke
Hopkins
Clarke**

ClarkeHopkinsClarke

Melbourne

L9, Melbourne Connect

700 Swanston Street

Carlton Victoria 3053

Telephone (03) 9419 4340

Email studio@chc.com.au

www.chc.com.au

Sydney

3/78 Campbell Street

Surry Hills NSW 2010

Telephone (02) 9221 9200

Email studio@chc.com.au

www.chc.com.au


Scale	As indicated @ A1
Date	01/03/2024
Drawn	
Architect	

Project	Summerset Oakleigh
	52 Golf Road, Oakleigh South, VIC


Drawing	Internal Elevations - RACF Communal - Kitchen, Living & Dining - West
---------	---

Drawing No.	230185/A1816	P2
-------------	--------------	----


PRELIMINARY

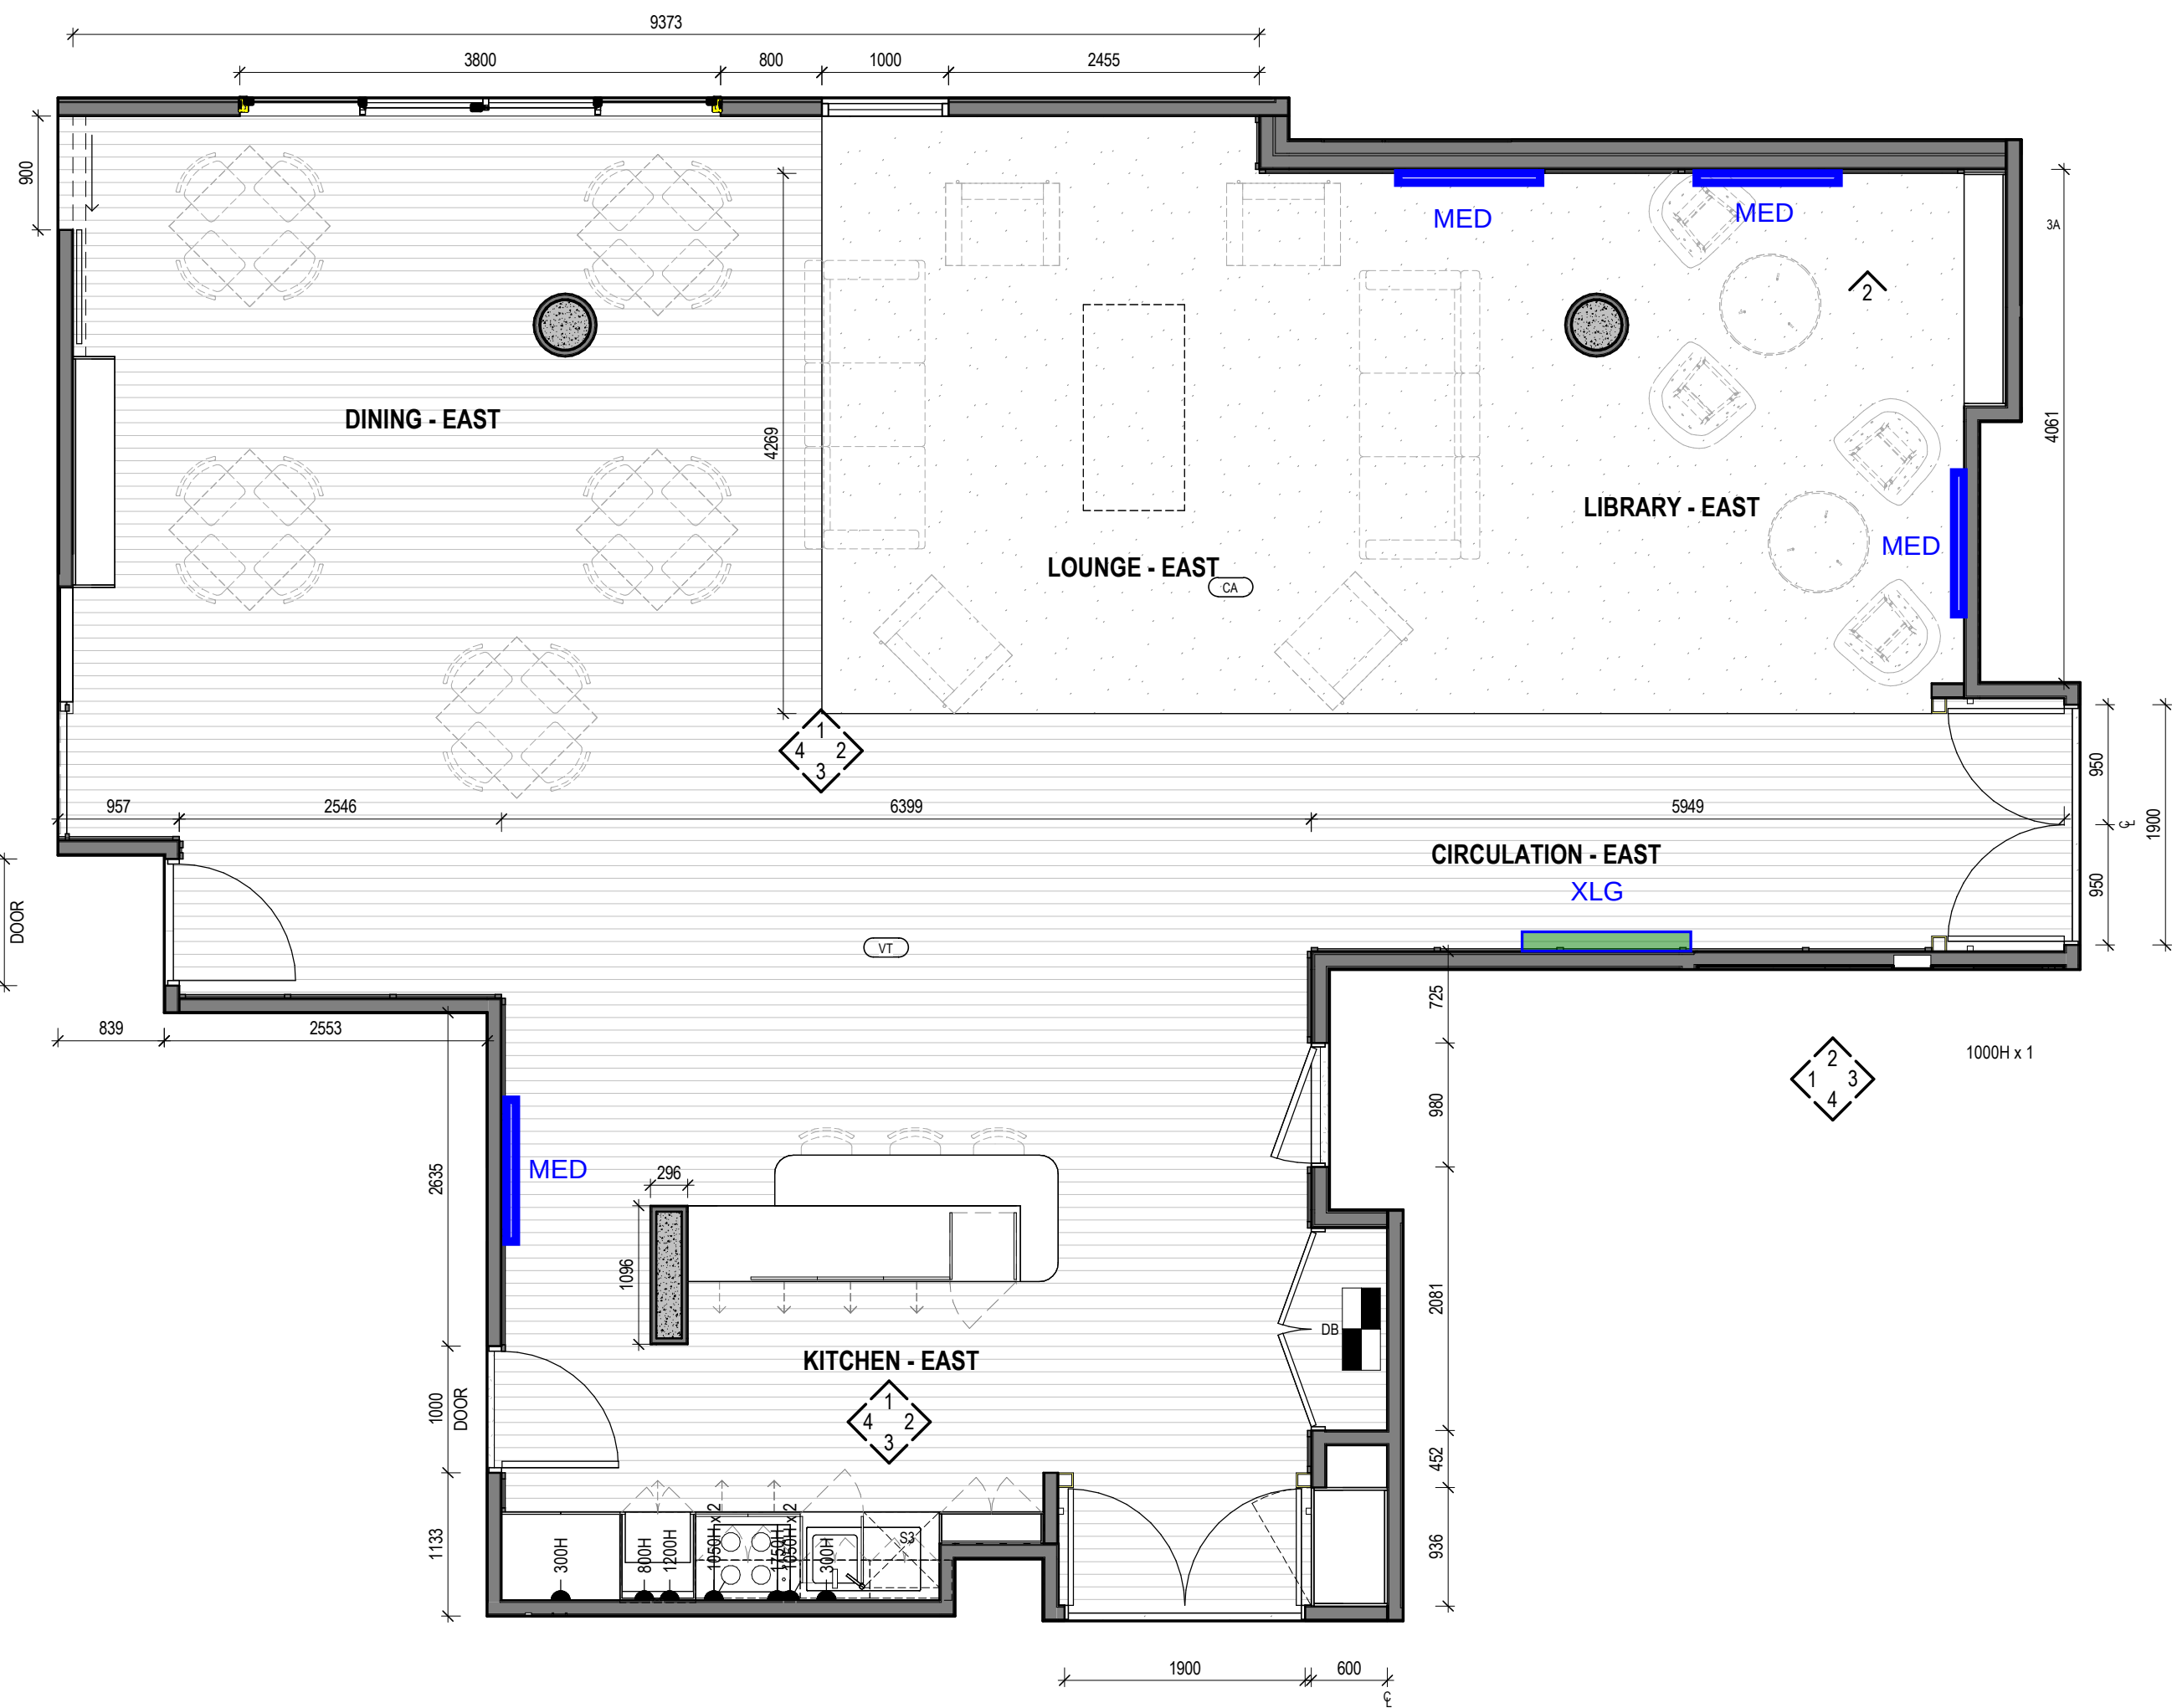


1 RACF Communal Kitchen_Living_Dining - East
Scale 1:50

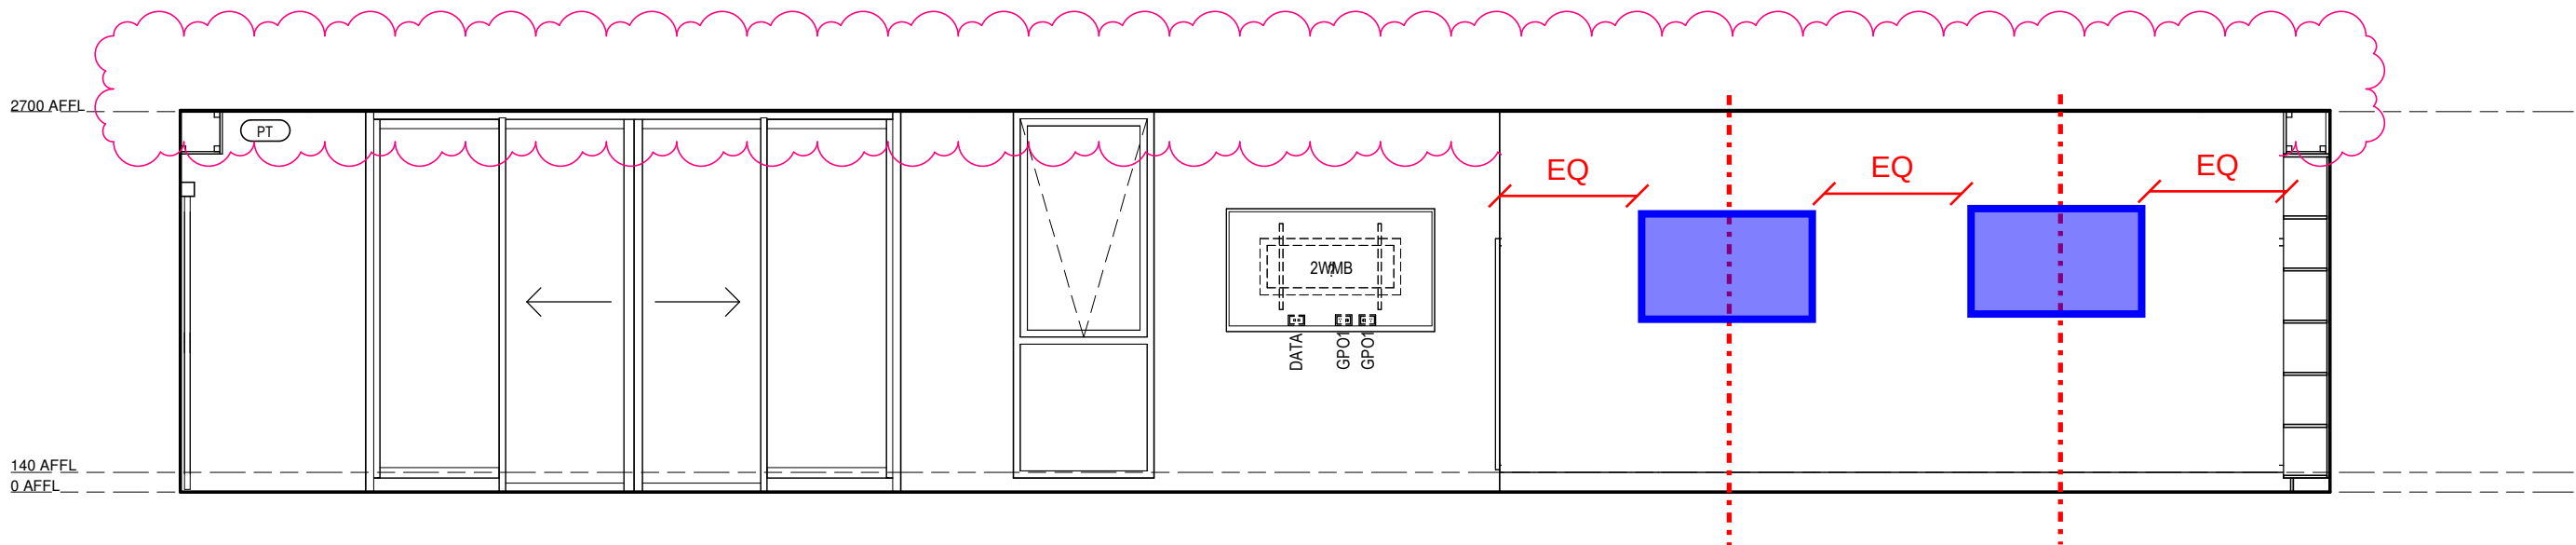


RACF Communal Living, Dining and Library - East - Elevation 1
Scale 1:50

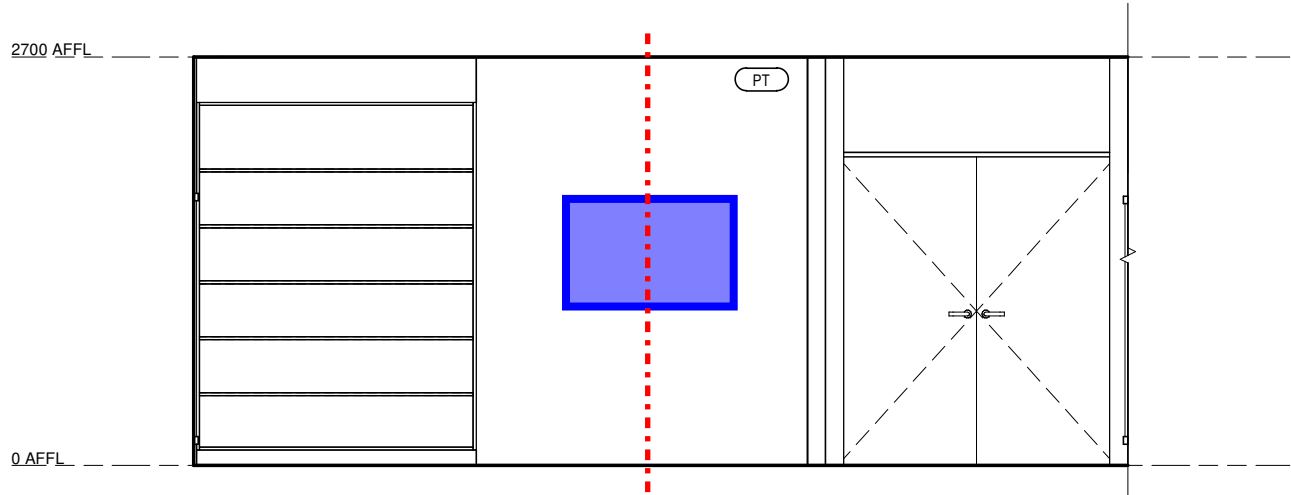


RACF Communal Living, Dining and Library - East - Elevation 2
Scale 1:50

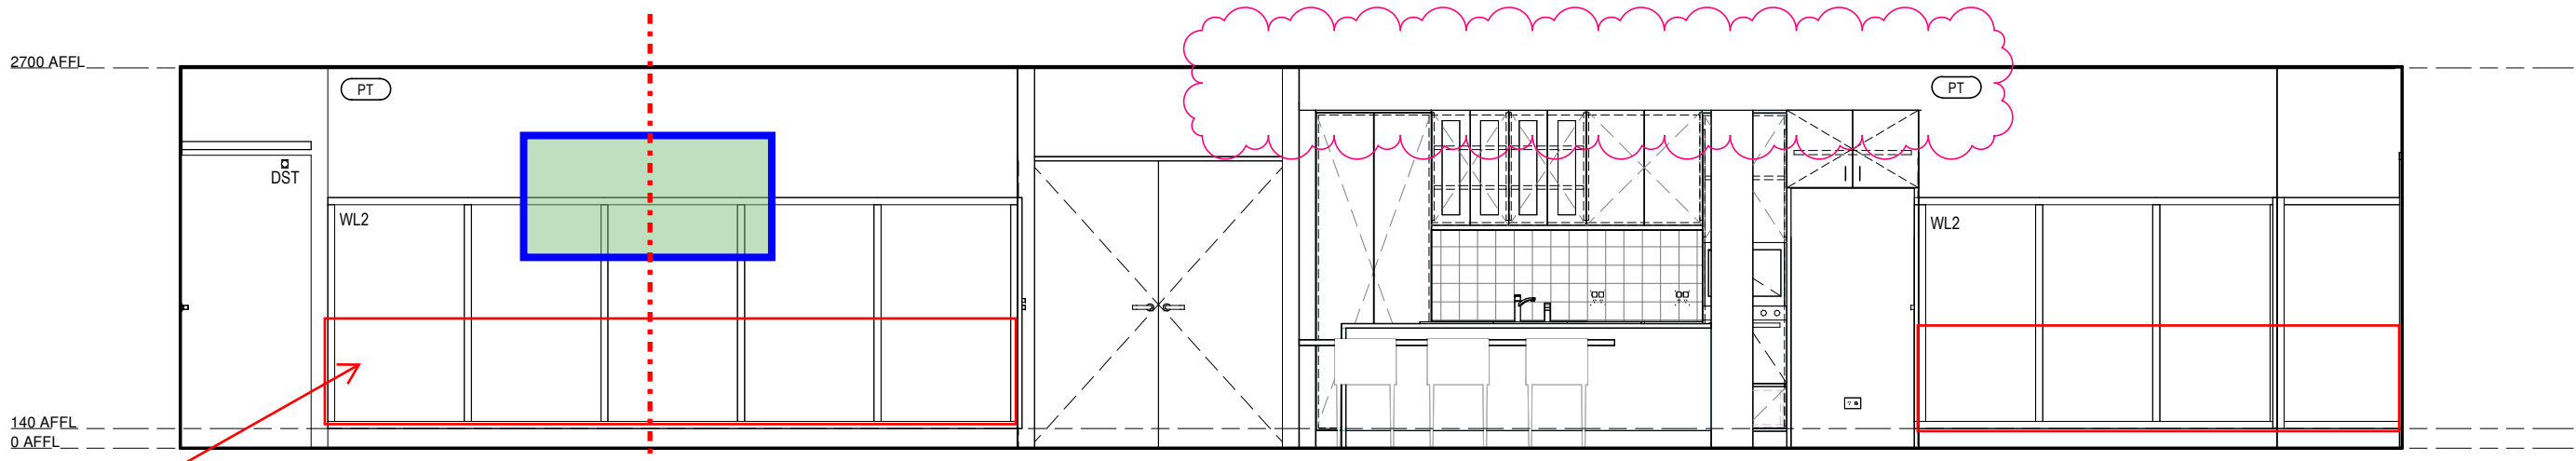


RACF Communal Living, Dining and Library - East - Elevation 3
Scale 1:50

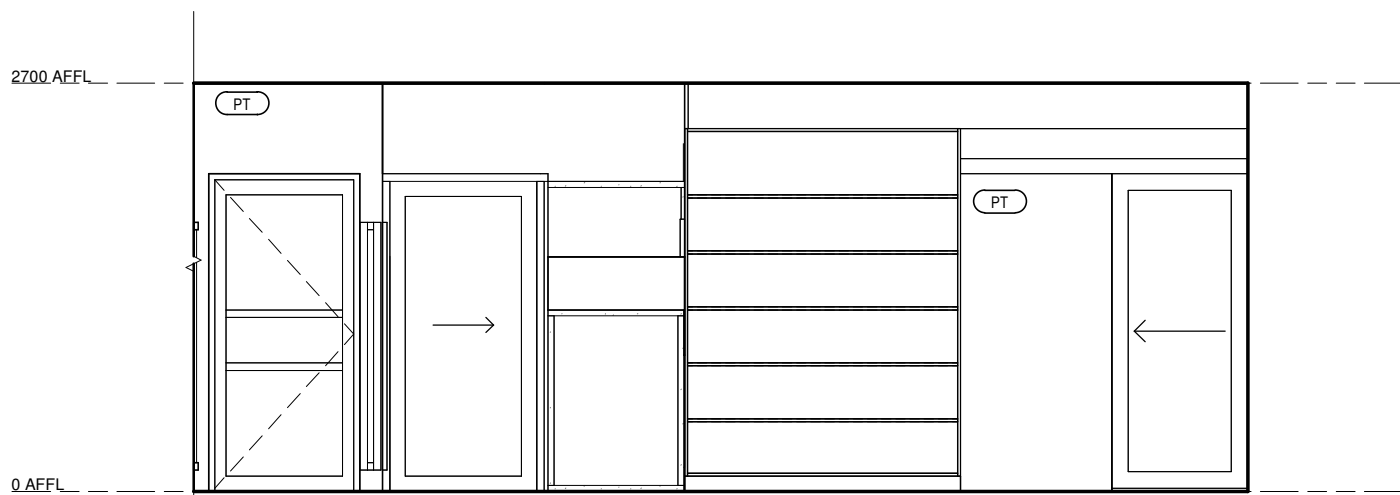


RACF Communal Living, Dining and Library - East - Elevation 4
Scale 1:50

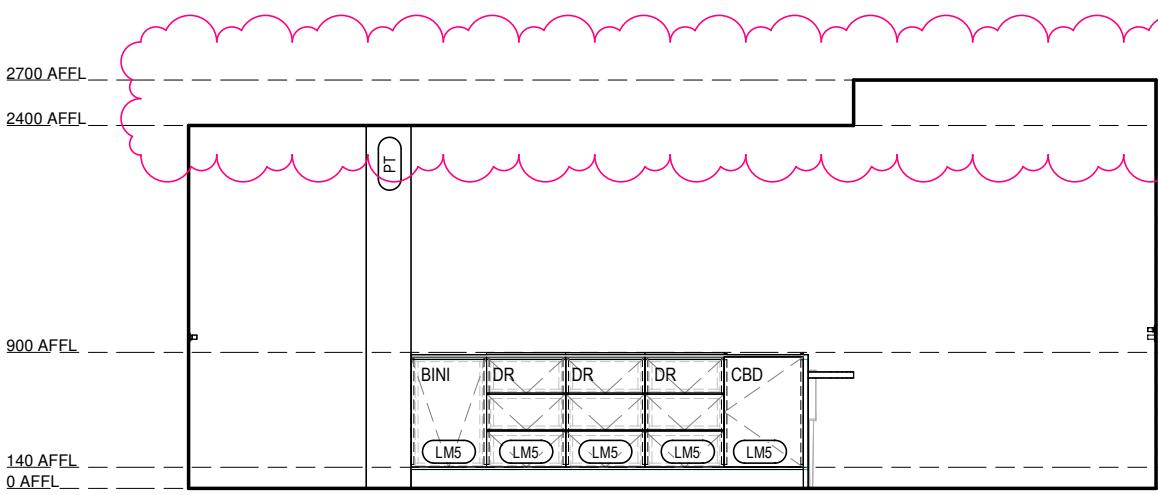


RACF Resident Kitchen - East - Elevation 1
Scale 1:50

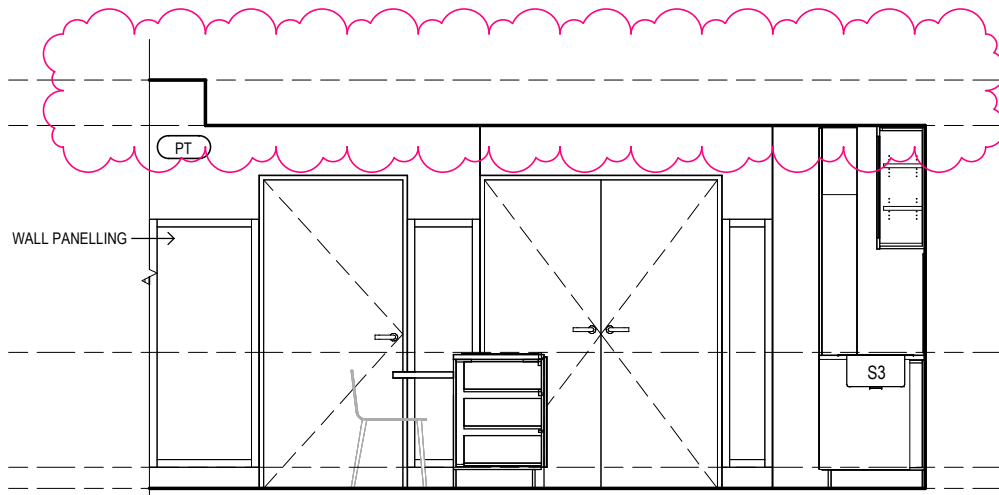

RACF Resident Kitchen - East - Elevation 2
Scale 1:50

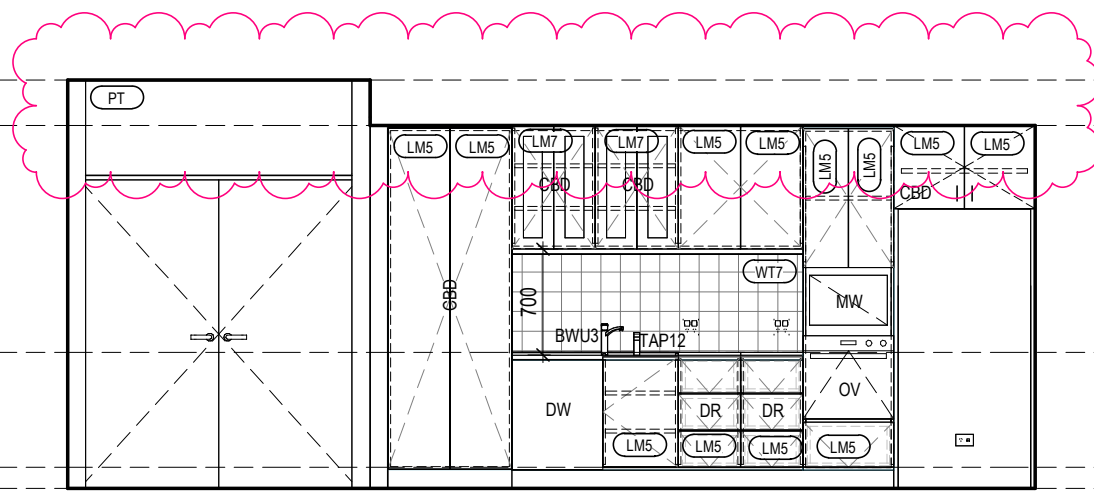

RACF Resident Kitchen - East - Elevation 3
Scale 1:50

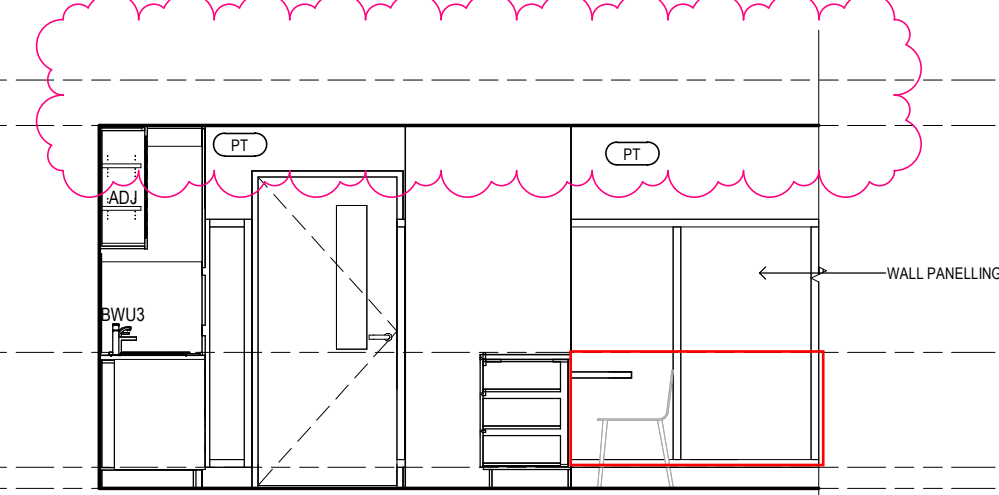

RACF Resident Kitchen - East - Elevation 4
Scale 1:50

Legend - Internal Elevations

DRAWINGS TO BE READ IN CONJUNCTION WITH ARCHITECTURAL SPECIFICATION & MATERIALS, PRODUCTS & FINISHES SCHEDULE.

PT# PAINT FINISH TO ALL WALLS WITHIN NEW & AFFECTED ROOMS/ AREAS UNLESS OTHERWISE SHOWN

- CSE CONCRETE SEALER
- DPR DOOR PROTECTION
- GD GRAPHIC FILM
- LM LAMINATE
- MI MIRROR
- PBD PINBOARD
- PT PAINT FINISH
- REN RENDER FINISH
- SB SPLASHBACK
- STN STONE
- WB WHITEBOARD
- WP WALL PROTECTION
- WT WALL TILE
- WV WALL VINYL

NOTES:
1. LAMINATE CARCASS FOR ALL VISIBLE OPEN SHELVING, UNLESS OTHERWISE NOTED
2. MELAMINETO ALL INTERNAL CARCASS OF JOINERY, UNLESS OTHERWISE NOTED.

Legend - Floor Finishes

- C CARPET
- CO CONCRETE
- D DECKING
- E EPOXY FINISH
- L LINOLEUM
- M MATTING
- PF PARTICLEBOARD FLOORING
- PU PAVING UNIT - TBC WITH LANDSCAPE
- PW PLYWOOD
- R RUBBER FLOORING
- T TILING
- TF TIMBER FLOORING
- V VINYL

Keynote Legend

- ADJ ADJUSTABLE SHELF
- BIN BIN - INTEGRATED
- BWU3 BOILING WATER UNIT - TYPE 3
- CBD CLIPBOARD
- DB DISTRIBUTION BOARD
- DR DRAWER
- DST DOOR STOP
- DW DISHWASHER
- MW MICROWAVE - GROUP 3
- OY OVEN
- S3 SINK - TYPE 3
- TAP12 TAP - TYPE 12
- WL2 WALL PANELLING - TYPE 2

Feature Artwork

Standard Artwork

- X-SML X-Small - 600 x 600
- SML Small - 900 x 900
- MED Medium - 1200 x 800
- LRG Large - 1500x 800
- XLG X-Large - 1800 x 800

PRELIMINARY

Revision/Issue	Date
P1 Preliminary Internal Elevations - RACF	2025.08.08
P2 Consolidated Set-to-date / SMG Comments	2025.08.15

**Clarke
Hopkins
Clarke**

ClarkeHopkinsClarke

Melbourne

L9, Melbourne Connect

700 Swanston Street

Carlton Victoria 3053

Telephone (03) 9419 4340

Email studio@chc.com.au

www.chc.com.au

Sydney

3/78 Campbell Street

Surry Hills NSW 2010

Telephone (02) 9221 9200

Email studio@chc.com.au

www.chc.com.au

Scale	As indicated @ A1
Date	01/03/2024
Drawn	
Architect	

Project	Summerset Oakleigh
	52 Golf Road, Oakleigh South, VIC

Drawing	Internal Elevations - RACF Communal - Kitchen, Living & Dining - East
---------	--

Drawing No.	230185/A1817	P2
-------------	--------------	----

General Notes

BUILDER TO VIEW THE SITE DURING THE TENDER PERIOD TO SATISFY THEMSELVES OF THE LATENT SITE CONDITIONS AND FULL EXTENT OF WORK AS REQUIRED TO ALLOW FOR THE COMPLETION OF ALL WORKS AS DETAILED IN ALL DOCUMENTATION.

ALL DOCUMENTS ARE TO BE REVIEWED IN CONJUNCTION WITH RELEVANT CONSULTANTS DRAWINGS AND SPECIFICATIONS.

CONTRACTOR TO USE 92MM STUD FRAMING UNLESS NOTED OTHERWISE. ALL WALL LININGS TO EXTEND TO 150mm ABOVE THE CEILING UNLESS NOTED OTHERWISE. ALL

ALLOW FOR WALL STRENGTHENING BEHIND WALL MOUNTED FIXTURES AND FITTINGS INCLUDING BUT NOT LIMITED TO GRABRAILS, HANDRAILS, EQUIPMENT HOOKS, DRUG SAFES.

Legend - General

- WALL TYPE
- RELATIVE LEVEL
- PROPOSED FINISH LEVEL
- TRAVEL PATH

Feature Artwork

Standard Artwork

- X-SML X-Small - 600 x 600
- SML Small - 900 x 900
- MED Medium - 1200 x 800
- LRG Large - 1500x 800
- XLG X-Large - 1800 x 800

PRELIMINARY

Clarke Hopkins Clarke

Melbourne
700 Swanston Street
Carlton Victoria 3053
Telephone (03) 9419 4340
Email studio@chc.com.au
www.chc.com.au

Sydney
3/78 Campbell Street
Surry Hills NSW 2010
Telephone (02) 9221 9200
Email studio@chc.com.au
www.chc.com.au

Scale
Date
Drawn
Architect



Project
Summerset Oakleigh
52 Golf Road, Oakleigh South, VIC

Drawing
General Arrangement Plan - First Floor

Drawing No.
230185/A1203
P8

Revision/Issue
P5 Preliminary Issue for Kitchen Consultant
P6 Preliminary GA Plan Issue for Co-ordination and Review
P7 Consolidated Set-to-date / SMG Comments
P8 Tender Pack - Doors and Windows

Date
2025.07.08
2025.07.29
2025.08.15
2025.08.15

General Notes

BUILDER TO VIEW THE SITE DURING THE TENDER PERIOD TO SATISFY THEMSELVES OF THE LATENT SITE CONDITIONS AND FULL EXTENT OF WORK AS REQUIRED TO ALLOW FOR THE COMPLETION OF ALL WORKS AS DETAILED IN ALL DOCUMENTATION.

ALL DOCUMENTS ARE TO BE REVIEWED IN CONJUNCTION WITH RELEVANT CONSULTANTS DRAWINGS AND SPECIFICATIONS.

CONTRACTOR TO USE 92MM STUD FRAMING UNLESS NOTED OTHERWISE. ALL WALL LININGS TO EXTEND TO 150mm ABOVE THE CEILING UNLESS NOTED OTHERWISE. ALL

ALLOW FOR WALL STRENGTHENING BEHIND WALL MOUNTED FIXTURES AND FITTINGS INCLUDING BUT NOT LIMITED TO GRABRAILS, HANDRAILS, EQUIPMENT HOOKS, DRUG SAFES.

Legend - General

- WALL TYPE
- RELATIVE LEVEL
- PROPOSED FINISH LEVEL
- TRAVEL PATH

- Feature Artwork
- Standard Artwork
- X-SML
- SML
- MED
- LRG
- XLG
- X-Small - 600 x 600
- Small - 900 x 900
- Medium - 1200 x 800
- Large - 1500x 800
- X-Large - 1800 x 800

PRELIMINARY



Revision/Issue	Date
P5 Preliminary Issue for Kitchen Consultant	2025.07.08
P6 Preliminary GA Plan Issue for Co-ordination and Review	2025.07.29
P7 Consolidated Set-to-date / SMG Comments	2025.08.15
P8 Tender Pack - Doors and Windows	2025.08.15

Clarke
Hopkins
Clarke

ClarkeHopkinsClarke
Melbourne
L9, Melbourne Connect
700 Swanston Street
Carlton Victoria 3053
Telephone (03) 9419 4340
Email studio@chc.com.au
www.chc.com.au

Sydney
3/78 Campbell Street
Surry Hills NSW 2010
Telephone (02) 9221 9200
Email studio@chc.com.au
www.chc.com.au


Scale
Date
Drawn
Architect

1:100 @ A1
01/03/2024


Project
Summerset Oakleigh
52 Golf Road, Oakleigh South, VIC

Drawing
General Arrangement Plan - Second Floor


Drawing No.
230185/A1204
P8

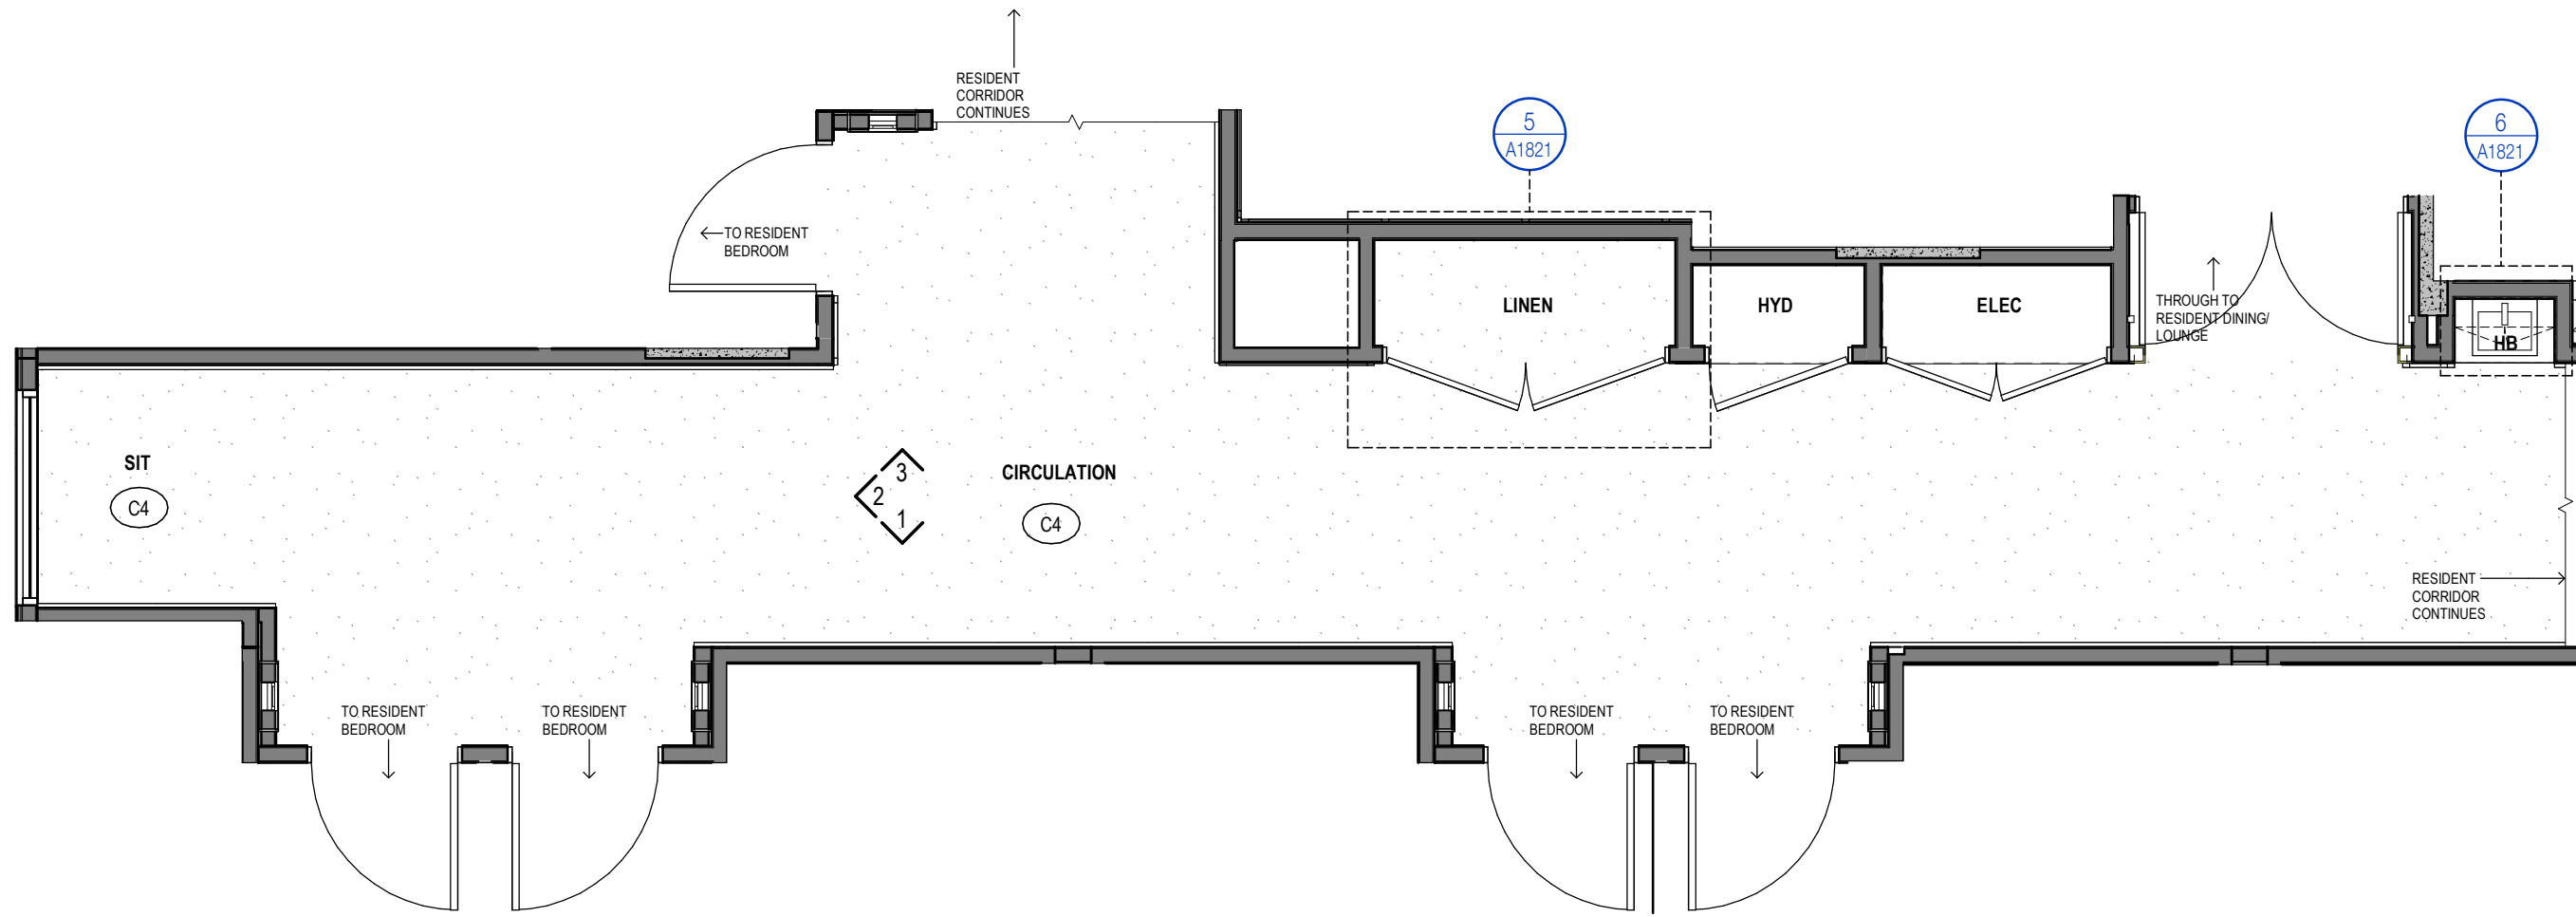


1 TYPICAL RACF CORRIDOR - INSTANCE 1
Scale 1 : 50

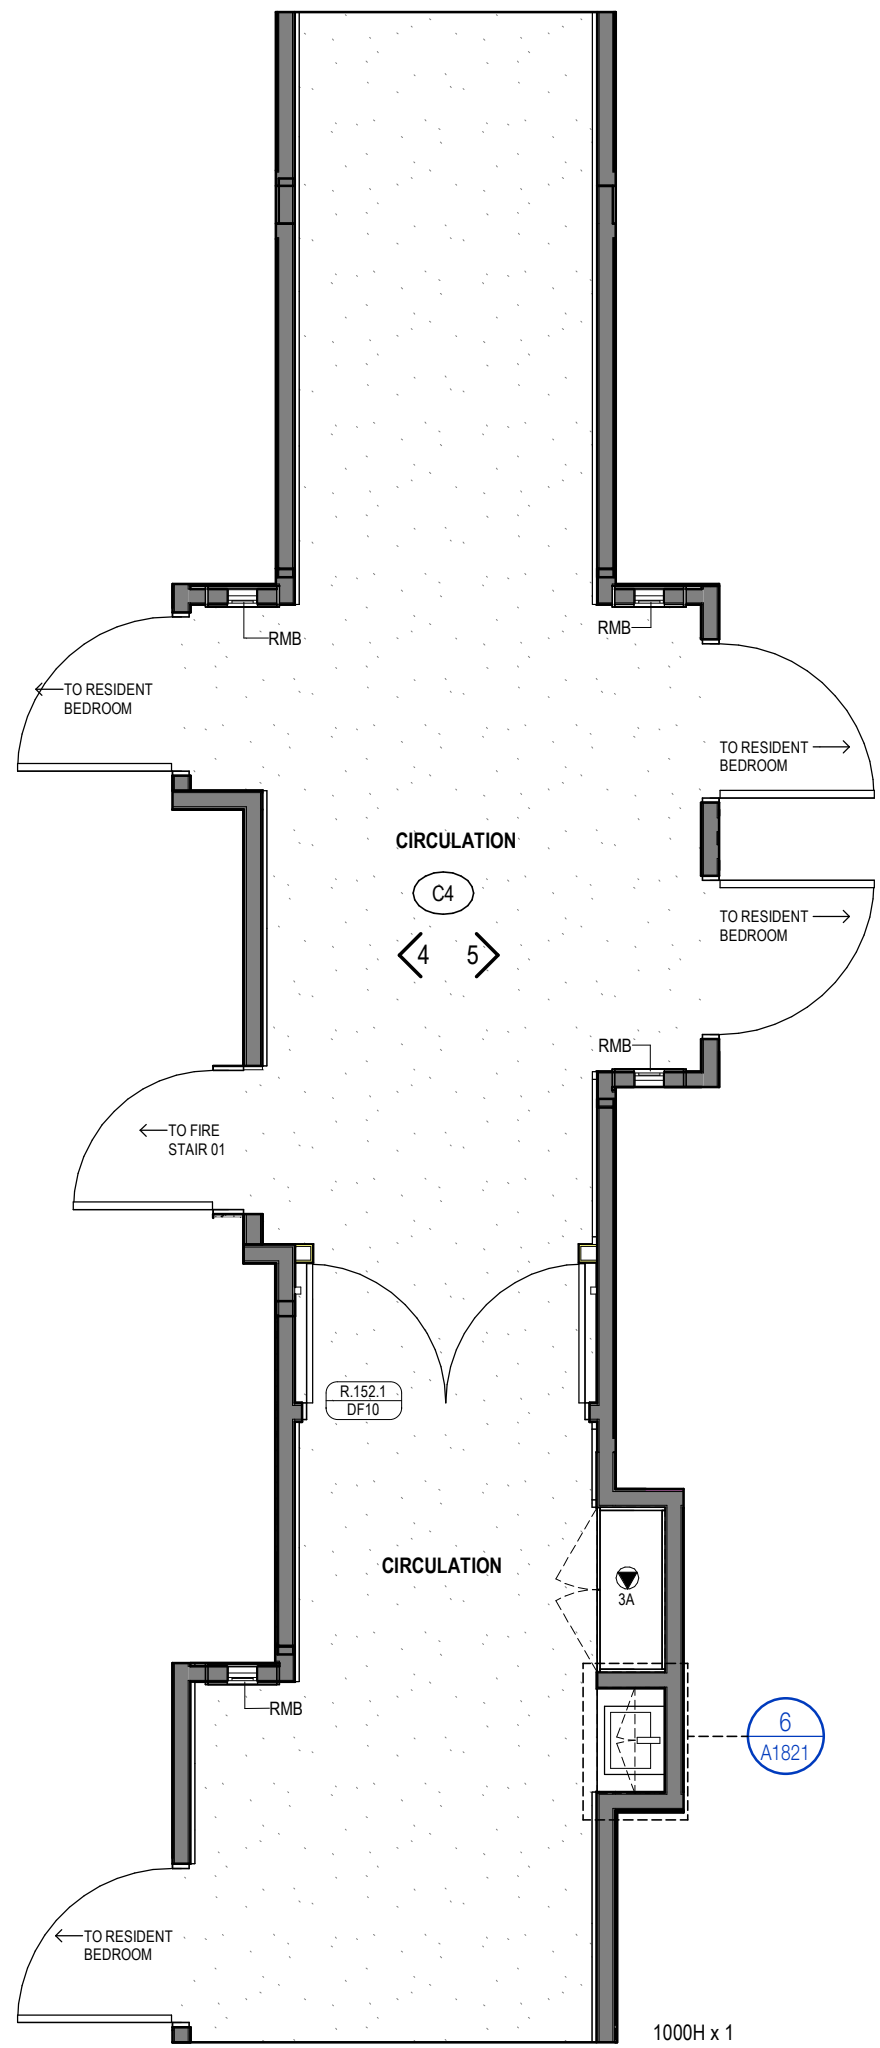


2 TYPICAL RACF CORRIDOR - INSTANCE 2
Scale 1 : 50

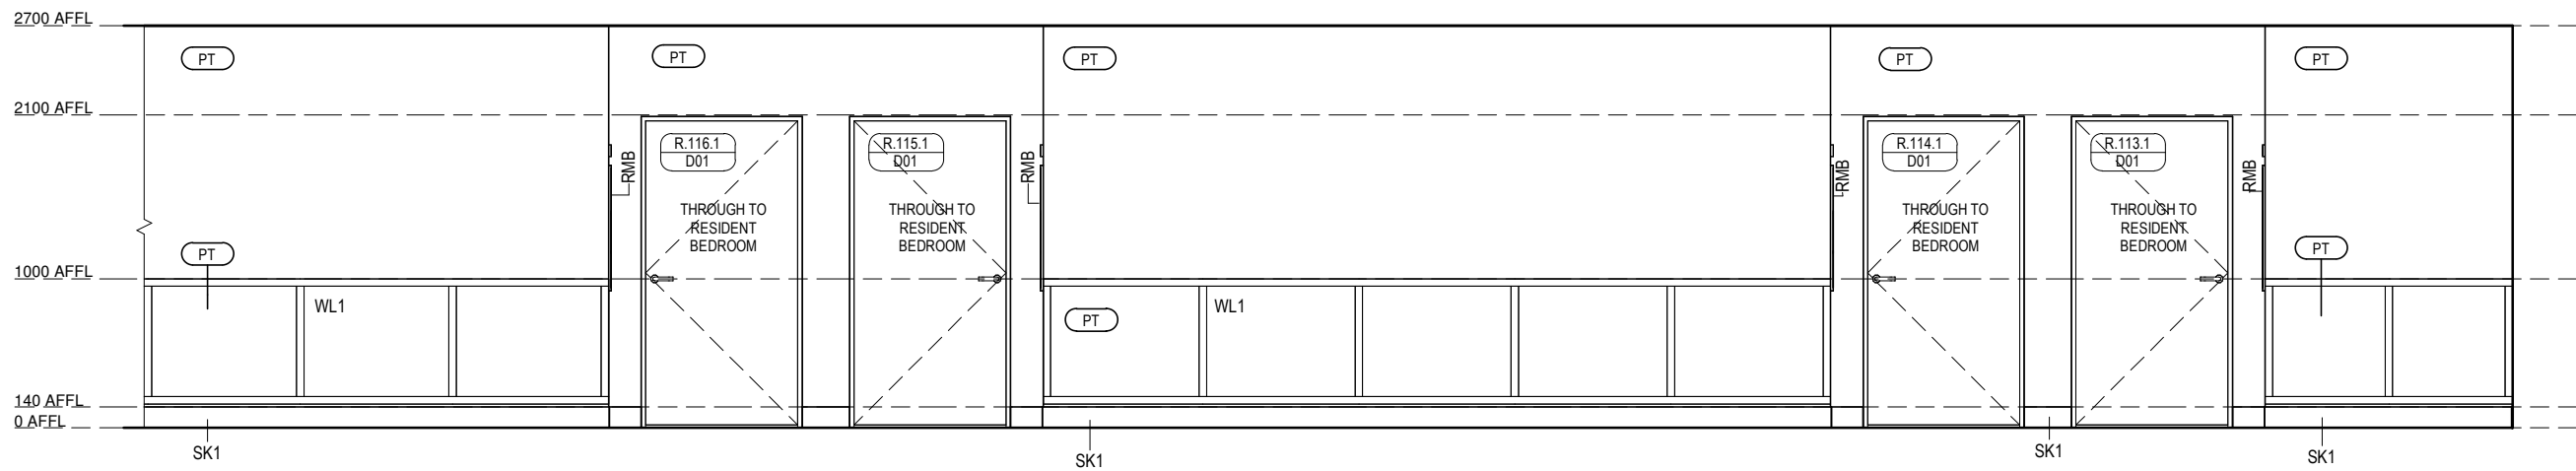


TYPICAL RESIDENT CORRIDOR
ELEVATION 1
Scale 1 : 50

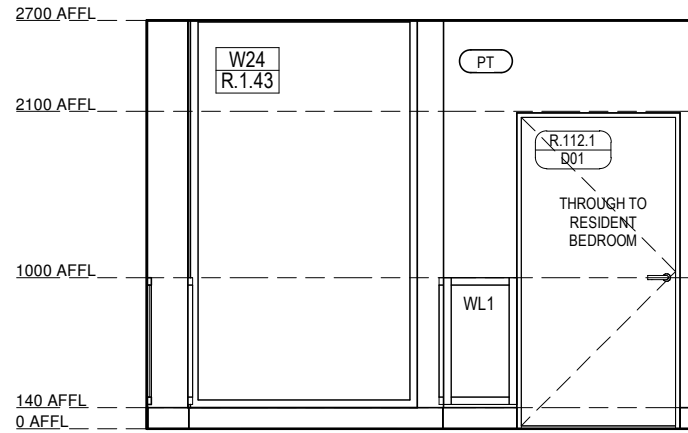


TYPICAL RESIDENT CORRIDOR
ELEVATION 2
Scale 1 : 50

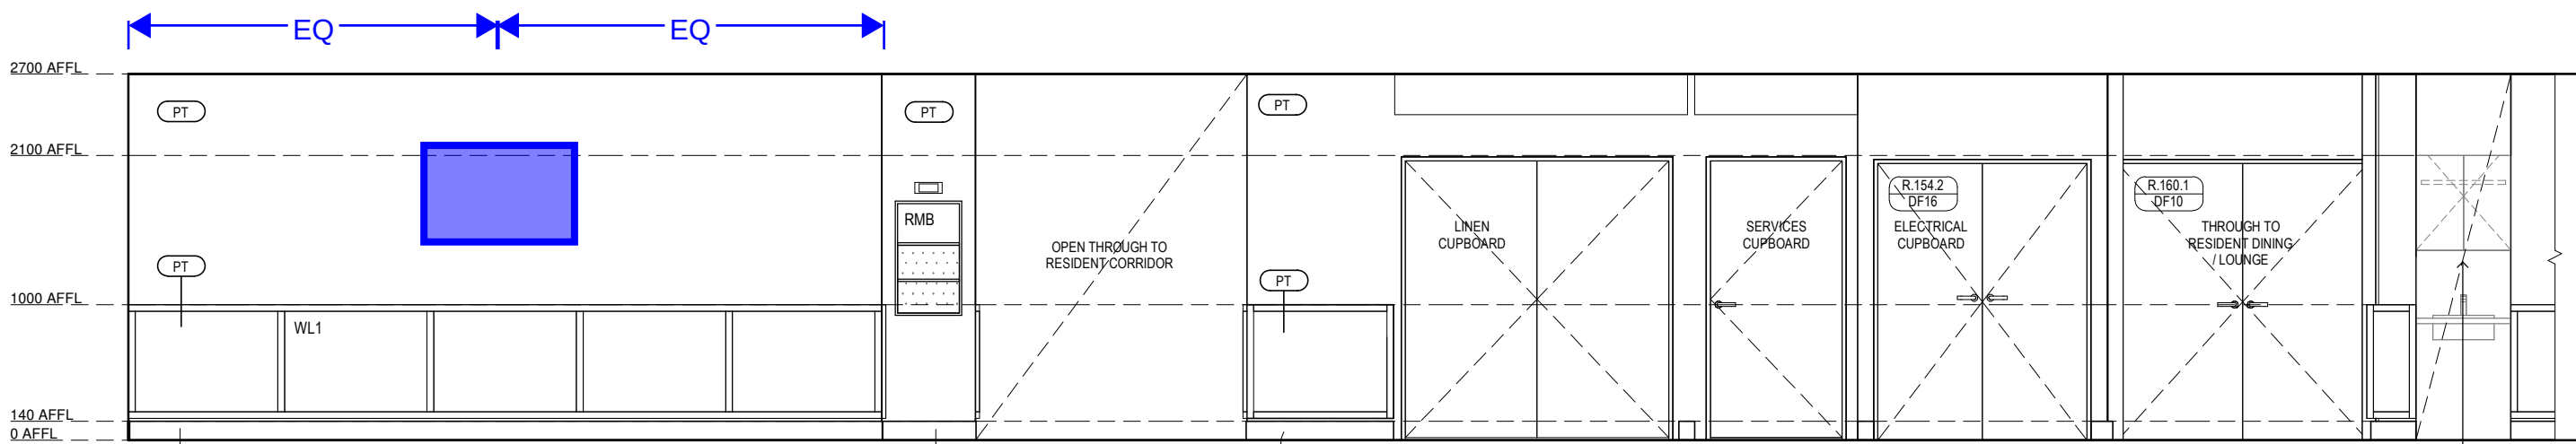

TYPICAL RESIDENT CORRIDOR
ELEVATION 3
Scale 1 : 50

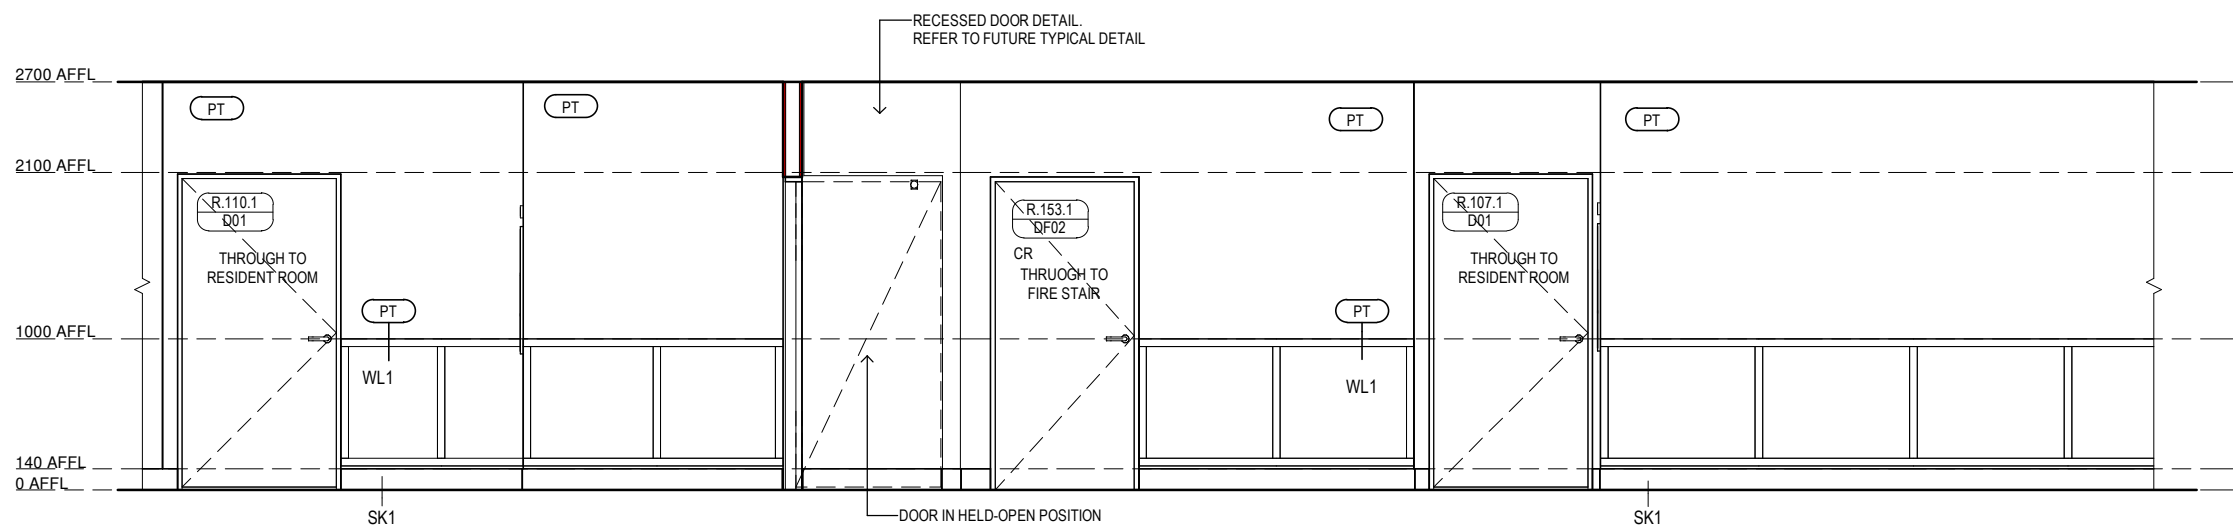

TYPICAL RESIDENT CORRIDOR
ELEVATION 4
Scale 1 : 50

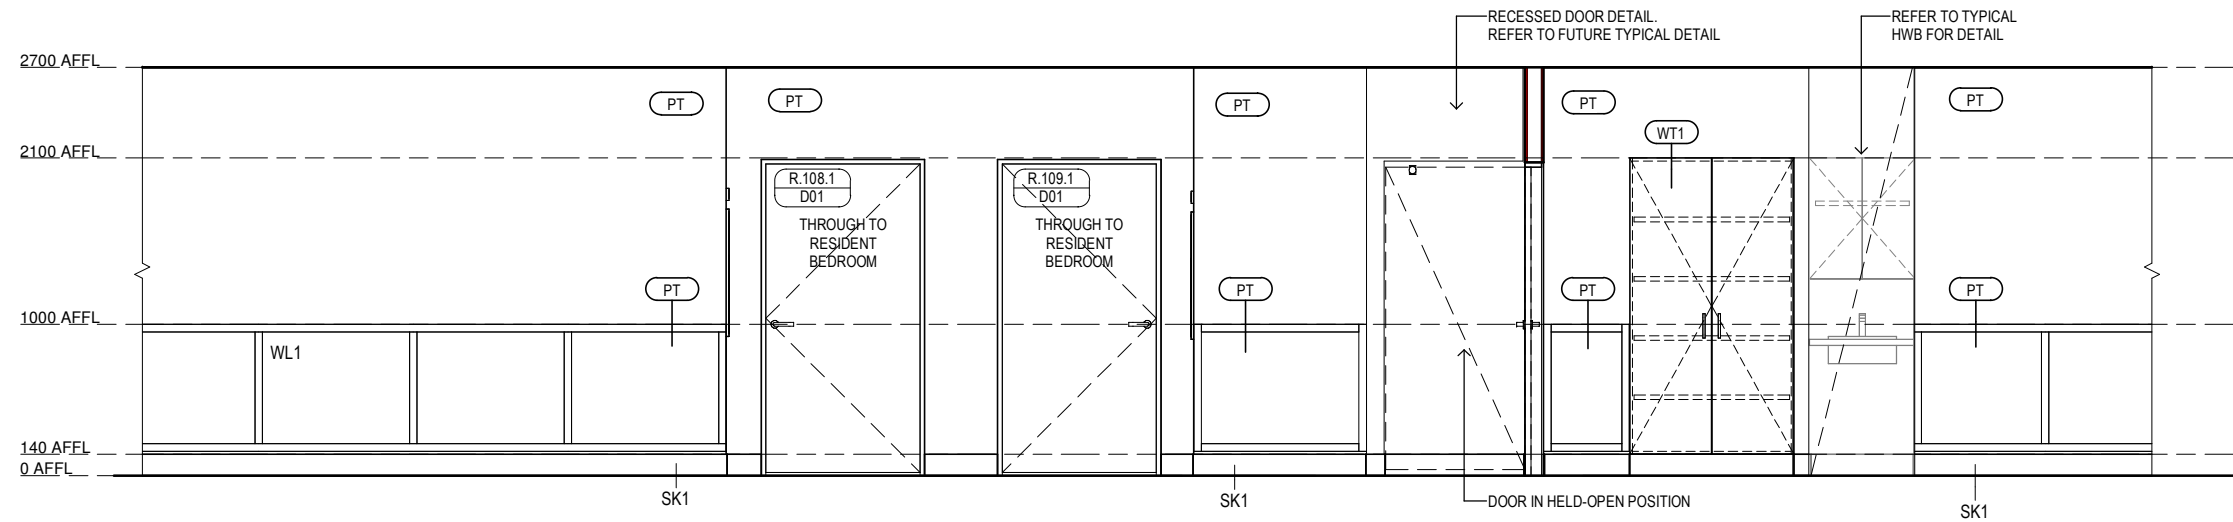

TYPICAL RESIDENT CORRIDOR
ELEVATION 5
Scale 1 : 50

Legend - Internal Elevations

DRAWINGS TO BE READ IN CONJUNCTION WITH ARCHITECTURAL SPECIFICATION & MATERIALS, PRODUCTS & FINISHES SCHEDULE.

PT# PAINT FINISH TO ALL WALLS WITHIN NEW & AFFECTED ROOMS/ AREAS UNLESS OTHERWISE SHOWN

- CSE CONCRETE SEALER
- DPR DOOR PROTECTION
- GD GRAPHIC FILM
- LM LAMINATE
- MI MIRROR
- PBD PINBOARD
- PT PAINT FINISH
- REN RENDER FINISH
- SB SPLASHBACK
- STN STONE
- WB WHITEBOARD
- WP WALL PROTECTION
- WT WALL TILE
- WV WALL VINYL

NOTES:
1. LAMINATE CARCASS FOR ALL VISIBLE OPEN SHELVING, UNLESS OTHERWISE NOTED
2. MELAMINETO ALL INTERNAL CARCASS OF JOINERY, UNLESS OTHERWISE NOTED.

Legend - Floor Finishes

- C CARPET
- CO CONCRETE
- D DECKING
- E EPOXY FINISH
- L LINOLEUM
- M MATTING
- PF PARTICLEBOARD FLOORING
- PU PAVING UNIT - TBC WITH LANDSCAPE
- PW PLYWOOD
- R RUBBER FLOORING
- T TILING
- TF TIMBER FLOORING
- V VINYL

Keynote Legend

- RMB RESIDENT MEMORY BOX - JOINERY
- SK1 SKIRTING - TYPE 1
- WL1 WALL PANNELLING - TYPE 1

PRELIMINARY

Revision/Issue
P1 Preliminary Issue

Date
2025.09.01

Clarke
Hopkins
Clarke

ClarkeHopkinsClarke

Melbourne

L9, Melbourne Connect

700 Swanston Street

Carlton Victoria 3053

Telephone (03) 9419 4340

Email studio@chc.com.au

www.chc.com.au

Sydney

3/78 Campbell Street

Sunny Hills NSW 2010

Telephone (02) 9221 9200

Email studio@chc.com.au

www.chc.com.au

Scale

As indicated @ A1

Date

01/03/2024

Drawn

EL

Architect

EL

Project

Summerset Oakleigh

52 Golf Road, Oakleigh South, VIC
























Drawing

Internal Elevations - RACF Typical Corridor

Drawing No.

230185/A1818

P1

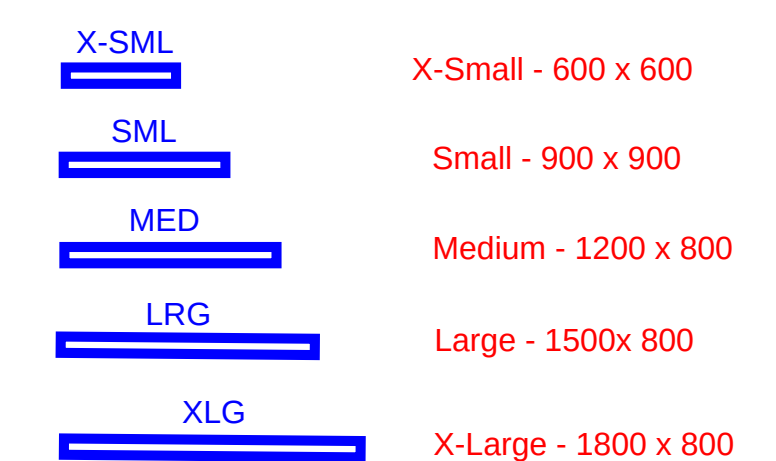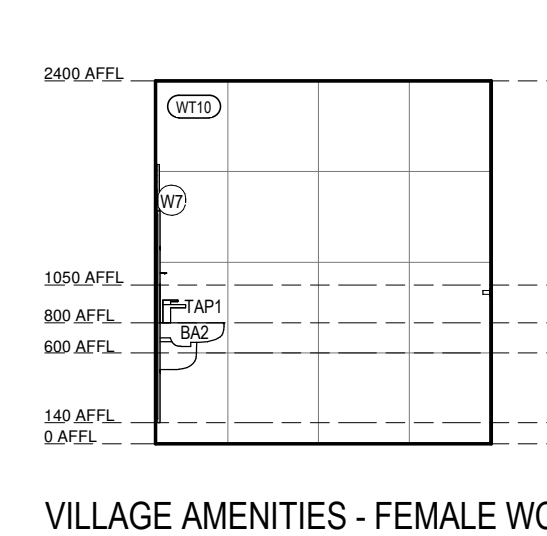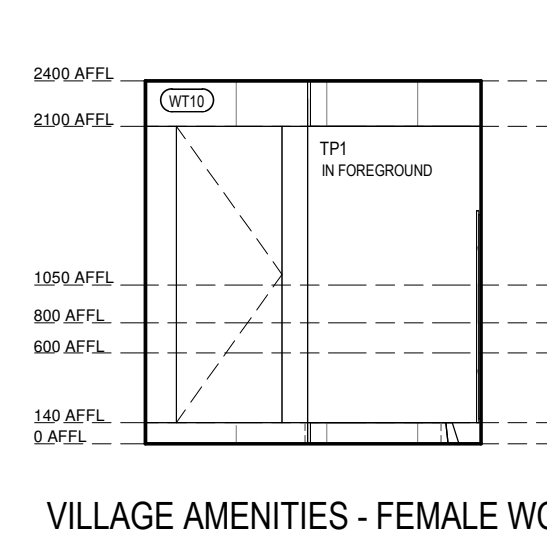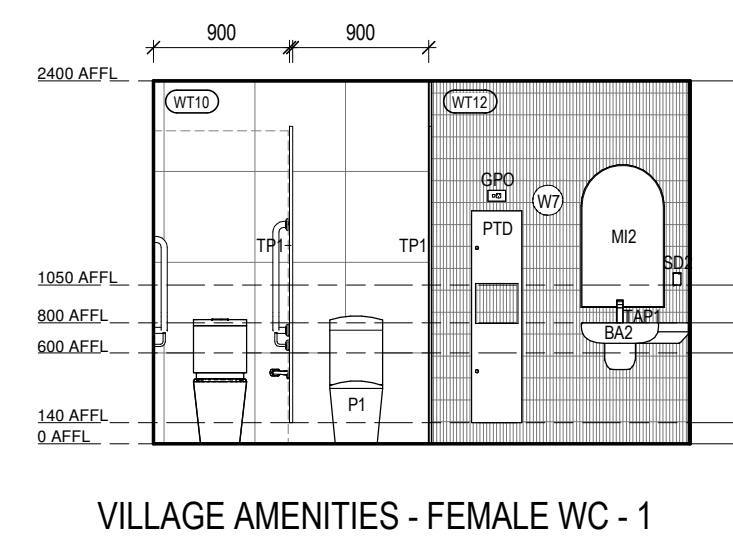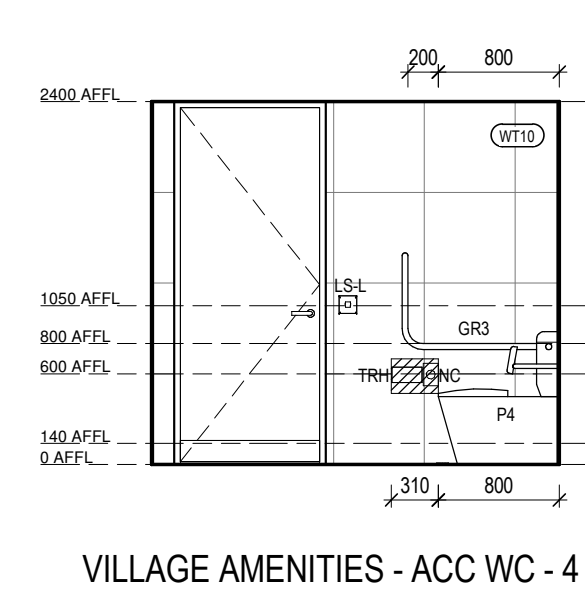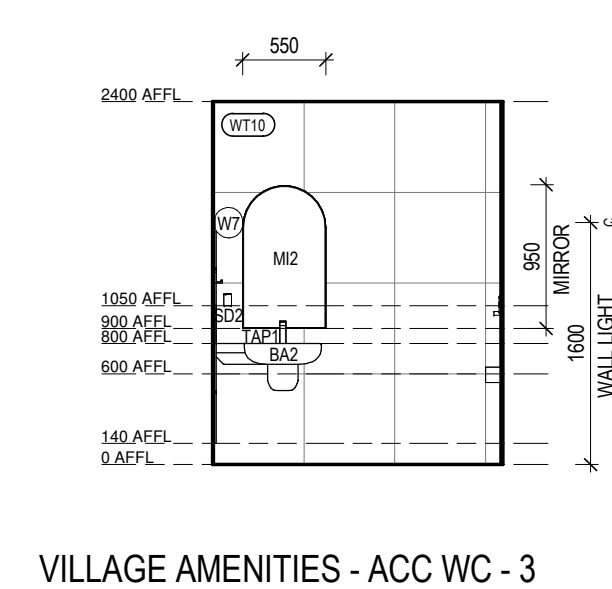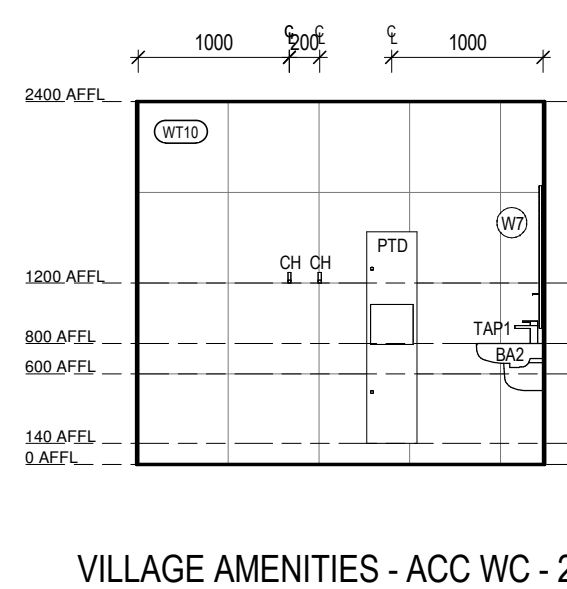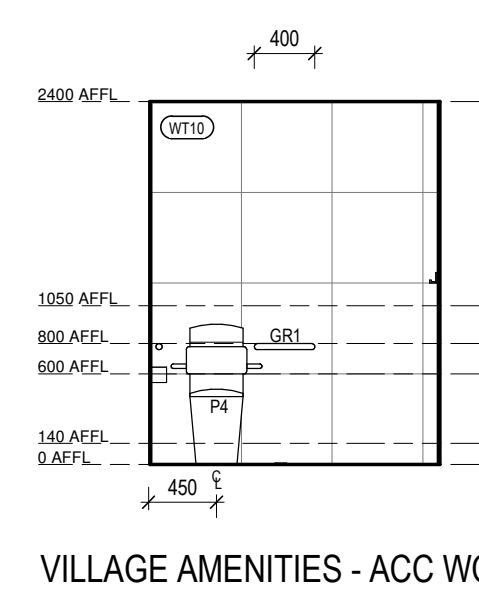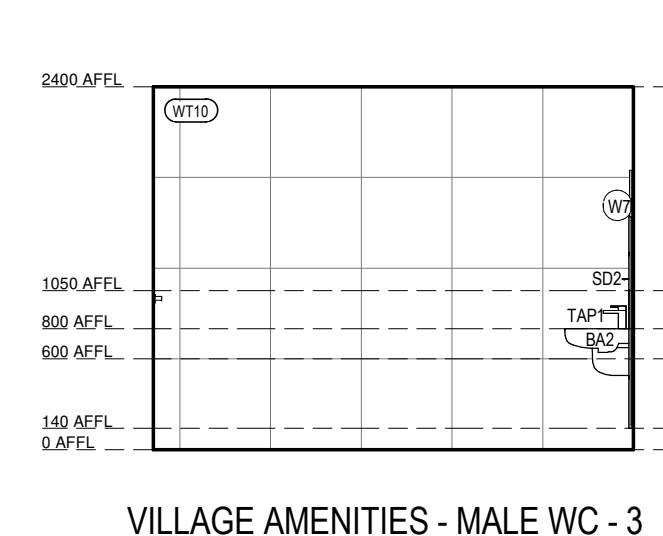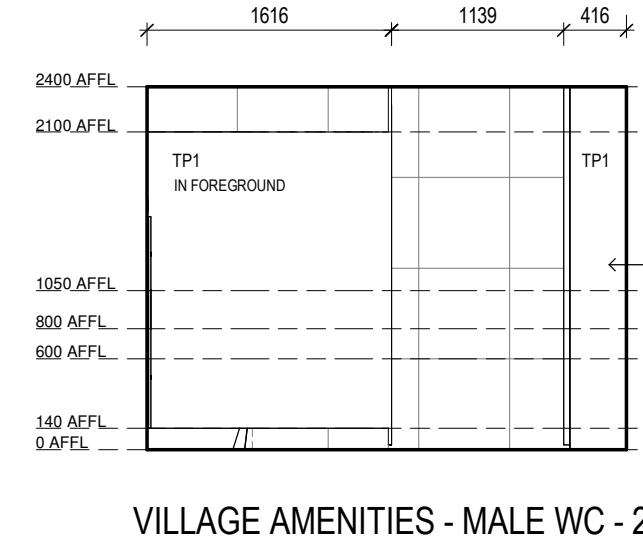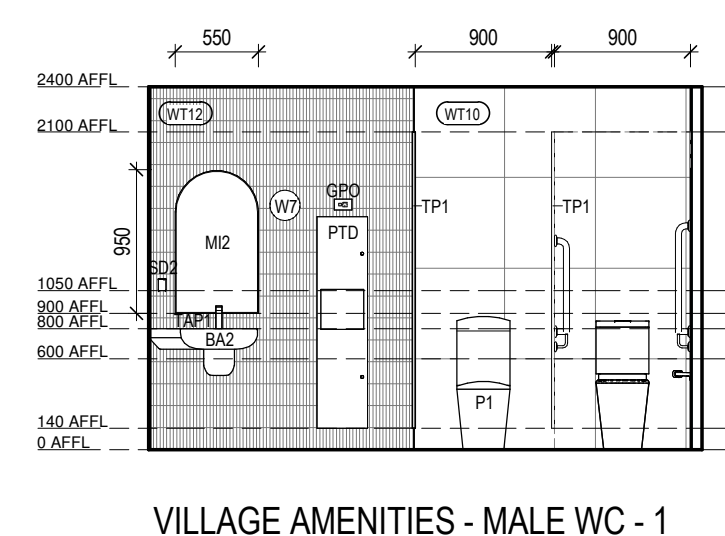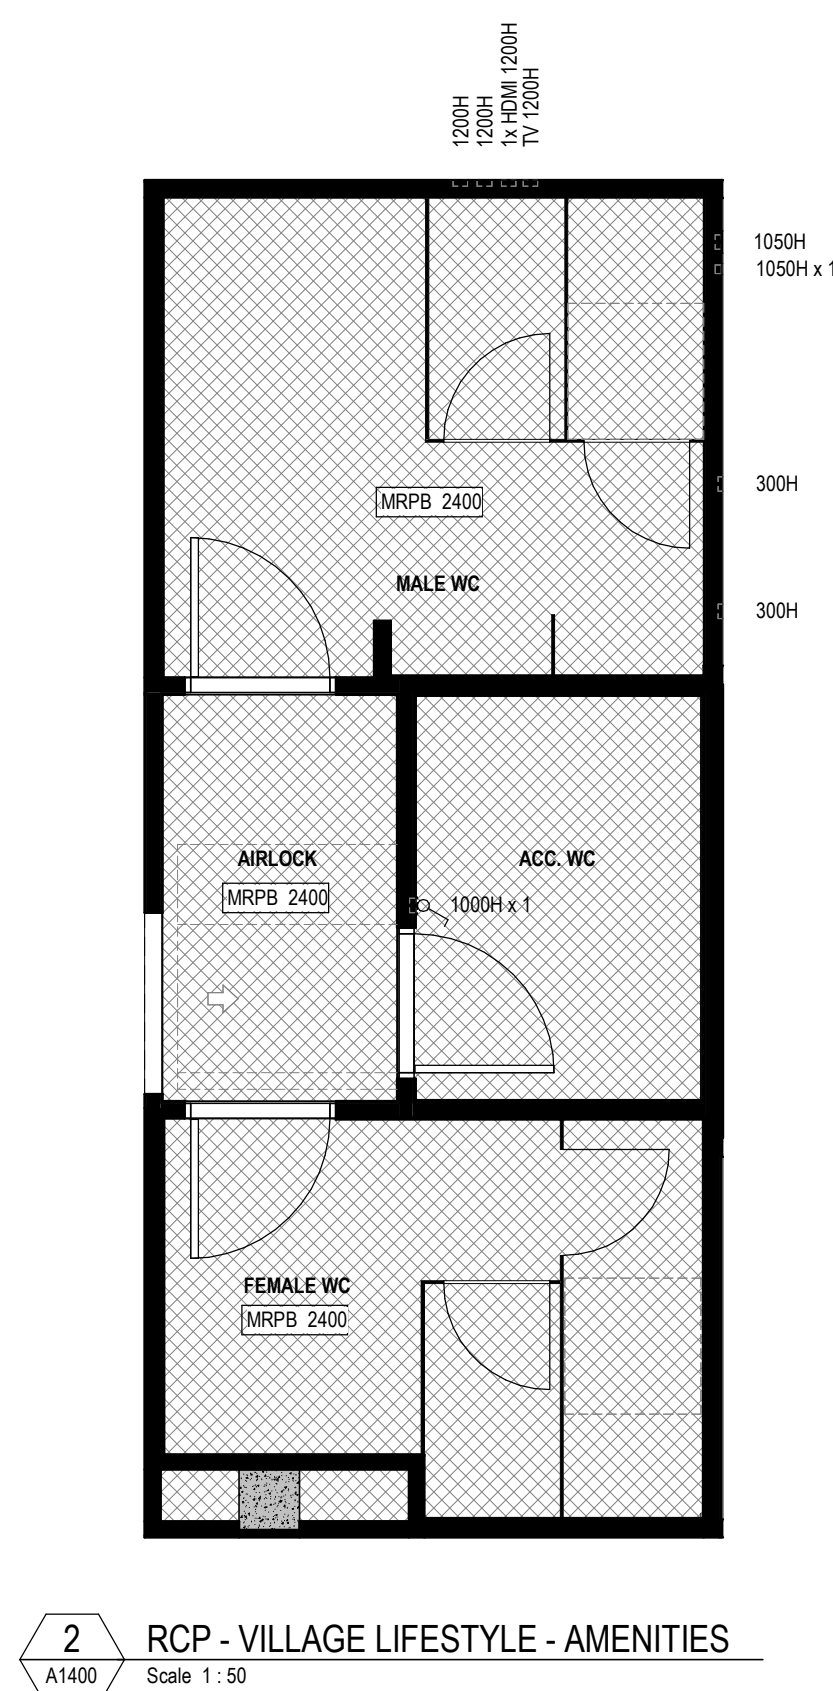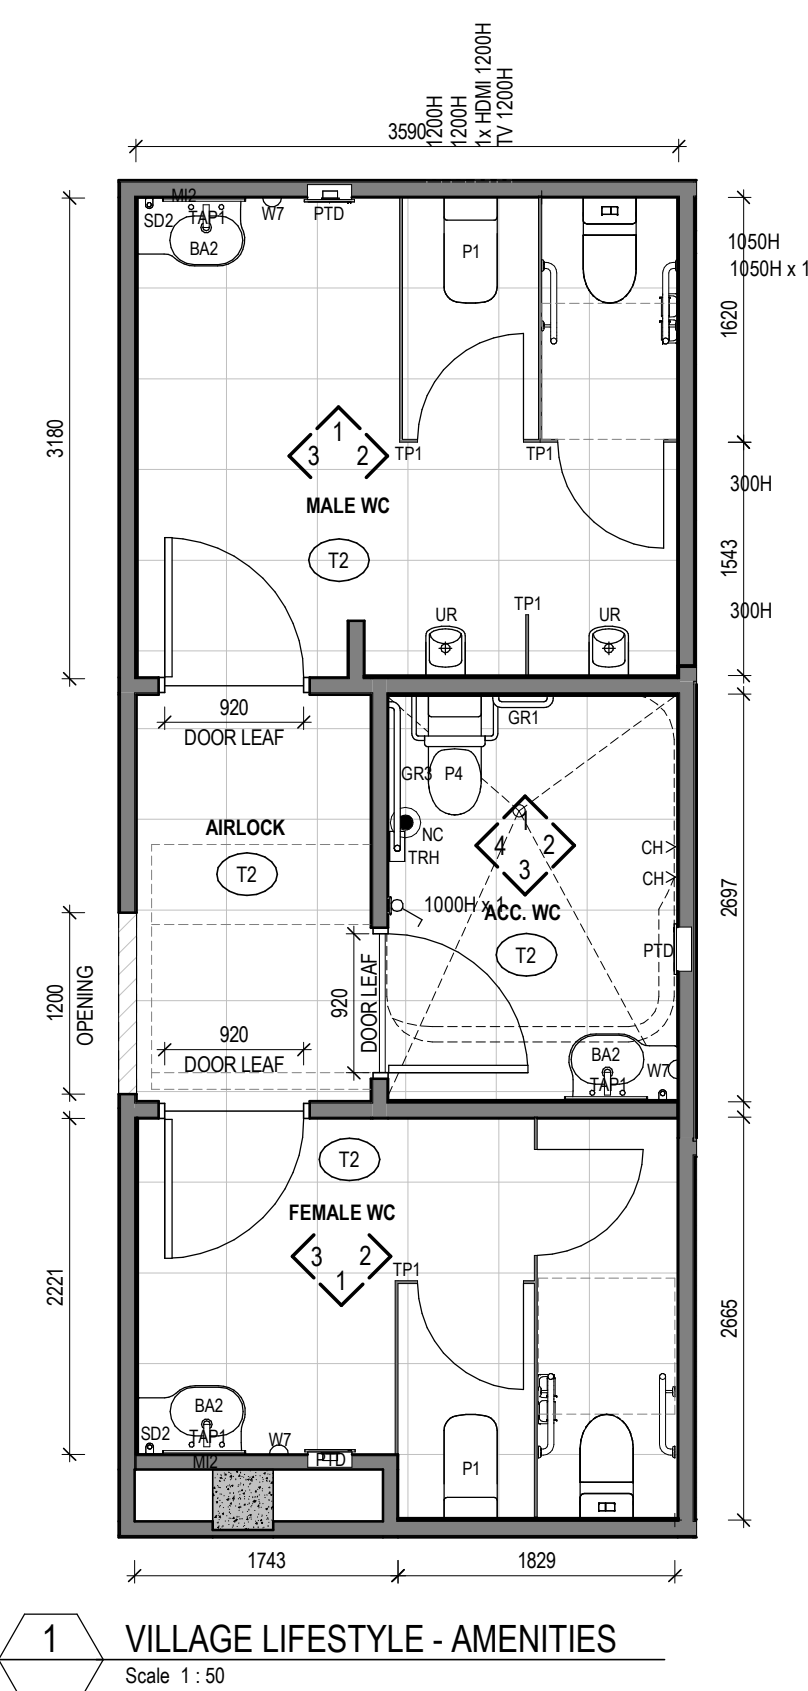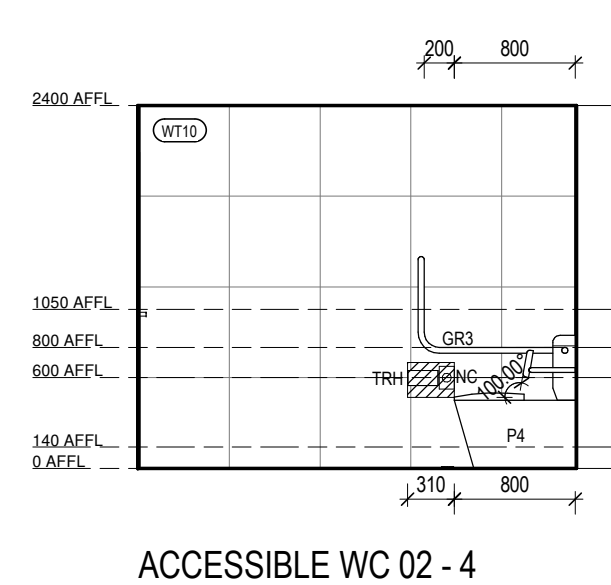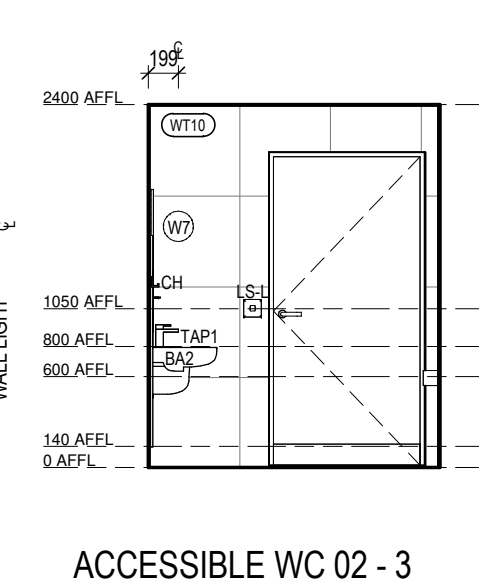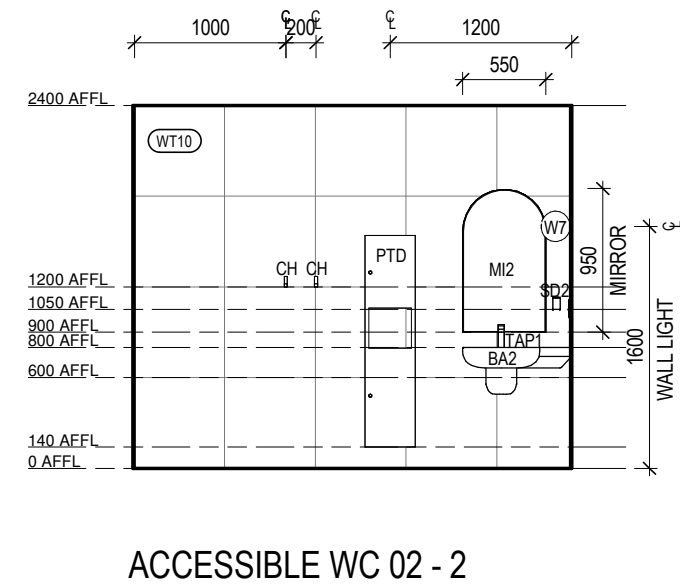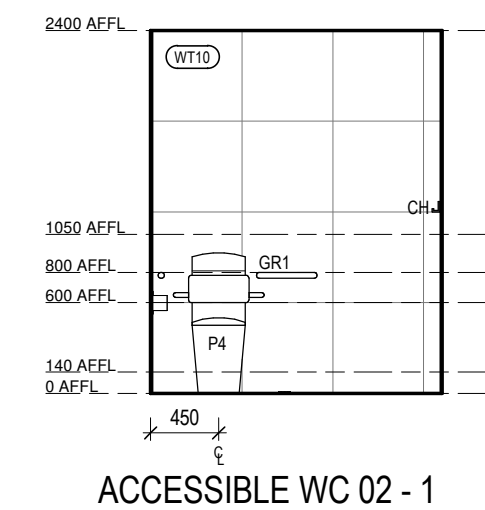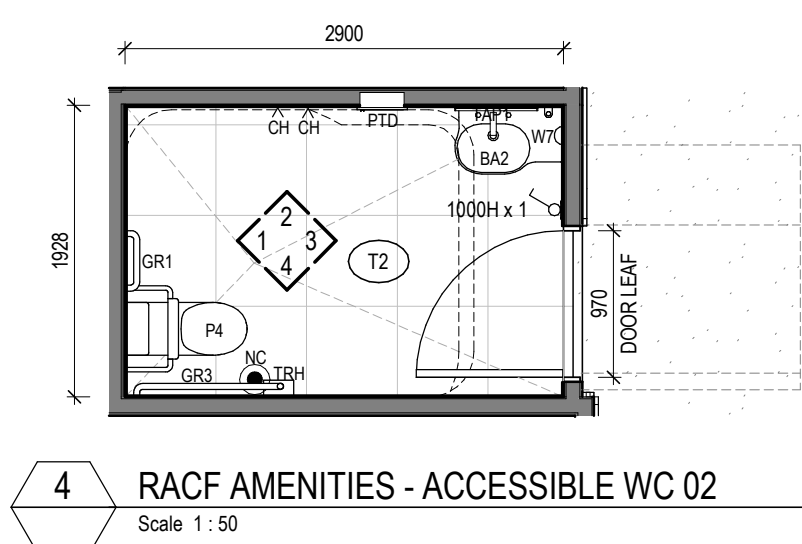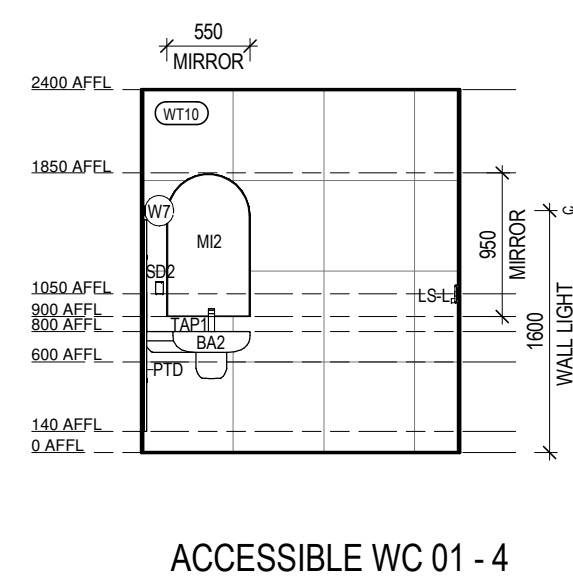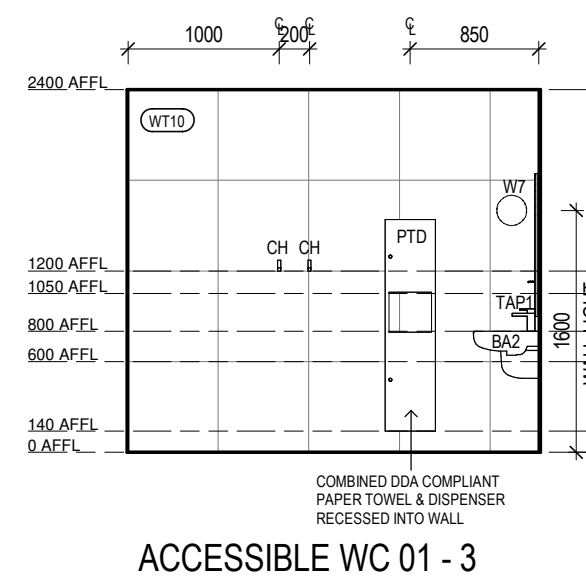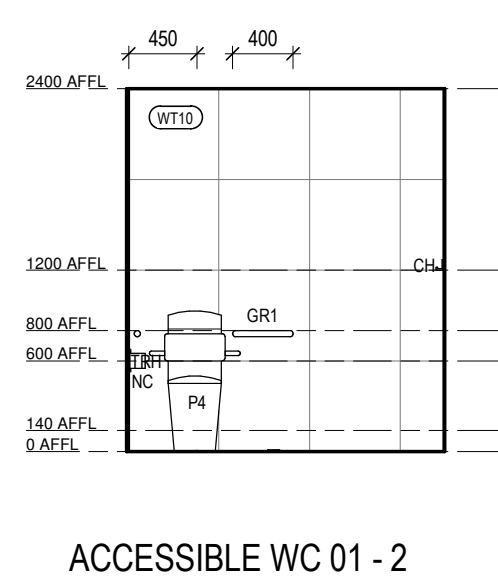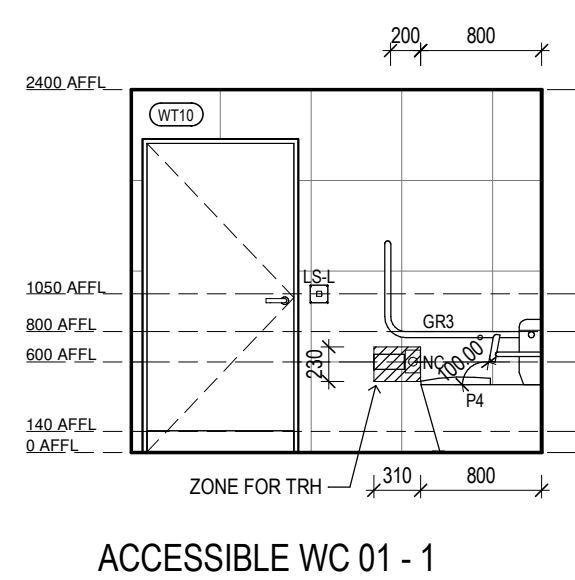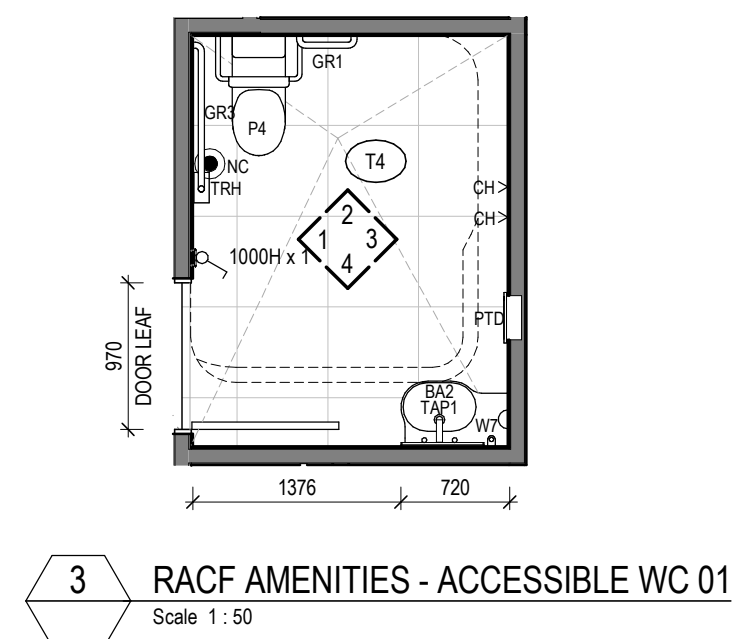

Legend - Internal Elevations

DRAWINGS TO BE READ IN CONJUNCTION WITH ARCHITECTURAL SPECIFICATION & MATERIALS, PRODUCTS & FINISHES SCHEDULE.

PT# PAINT FINISH TO ALL WALLS WITHIN NEW & AFFECTED ROOMS/ AREAS UNLESS OTHERWISE SHOWN

- CSE CONCRETE SEALER
- DPR DOOR PROTECTION
- GD GRAPHIC FILM
- LM LAMINATE
- MI MIRROR
- PBD PINBOARD
- PT PAINT FINISH
- REN RENDER FINISH
- SB SPLASHBACK
- STN STONE
- WB WHITEBOARD
- WP WALL PROTECTION
- WT WALL TILE
- WV WALL VINYL




NOTES:
1. LAMINATE CARCASS FOR ALL VISIBLE OPEN SHELVING, UNLESS OTHERWISE NOTED
2. MELAMINETO ALL INTERNAL CARCASS OF JOINERY, UNLESS OTHERWISE NOTED.

Legend - Floor Finishes

- C CARPET
- CO CONCRETE
- D DECKING
- E EPOXY FINISH
- L LINOLEUM
- M MATTING
- PF PARTICLEBOARD FLOORING
- PU PAVING UNIT - TBC WITH LANDSCAPE
- PW PLYWOOD
- R RUBBER FLOORING
- T TILING
- TF TIMBER FLOORING
- V VINYL



Keynote Legend

- COL COLUMN
- GPOCL POWER OUTLET - CLEANERS
- SK2 SKIRTING - TYPE 2

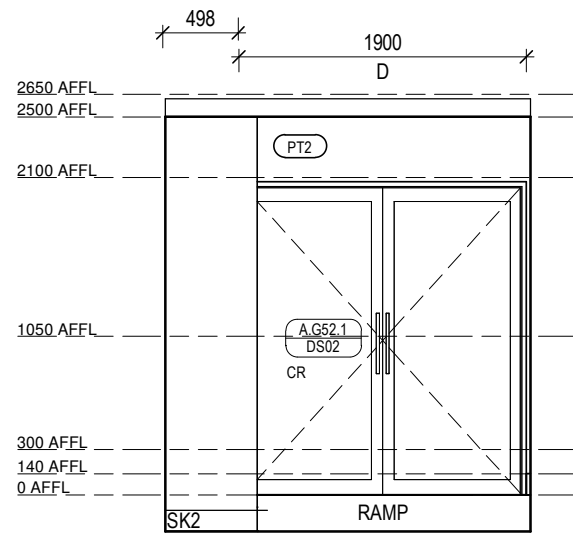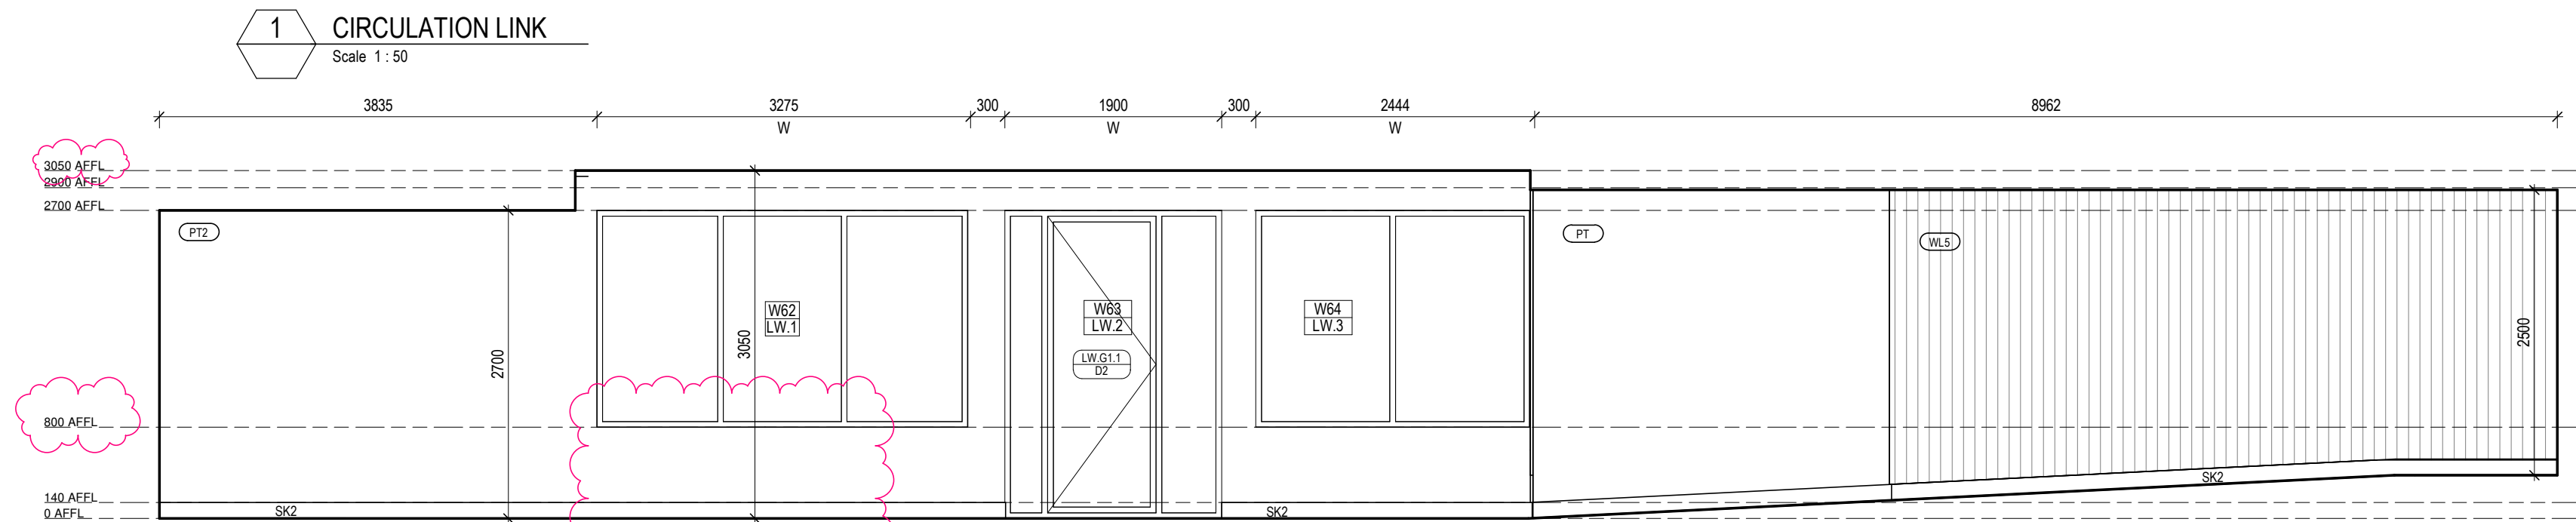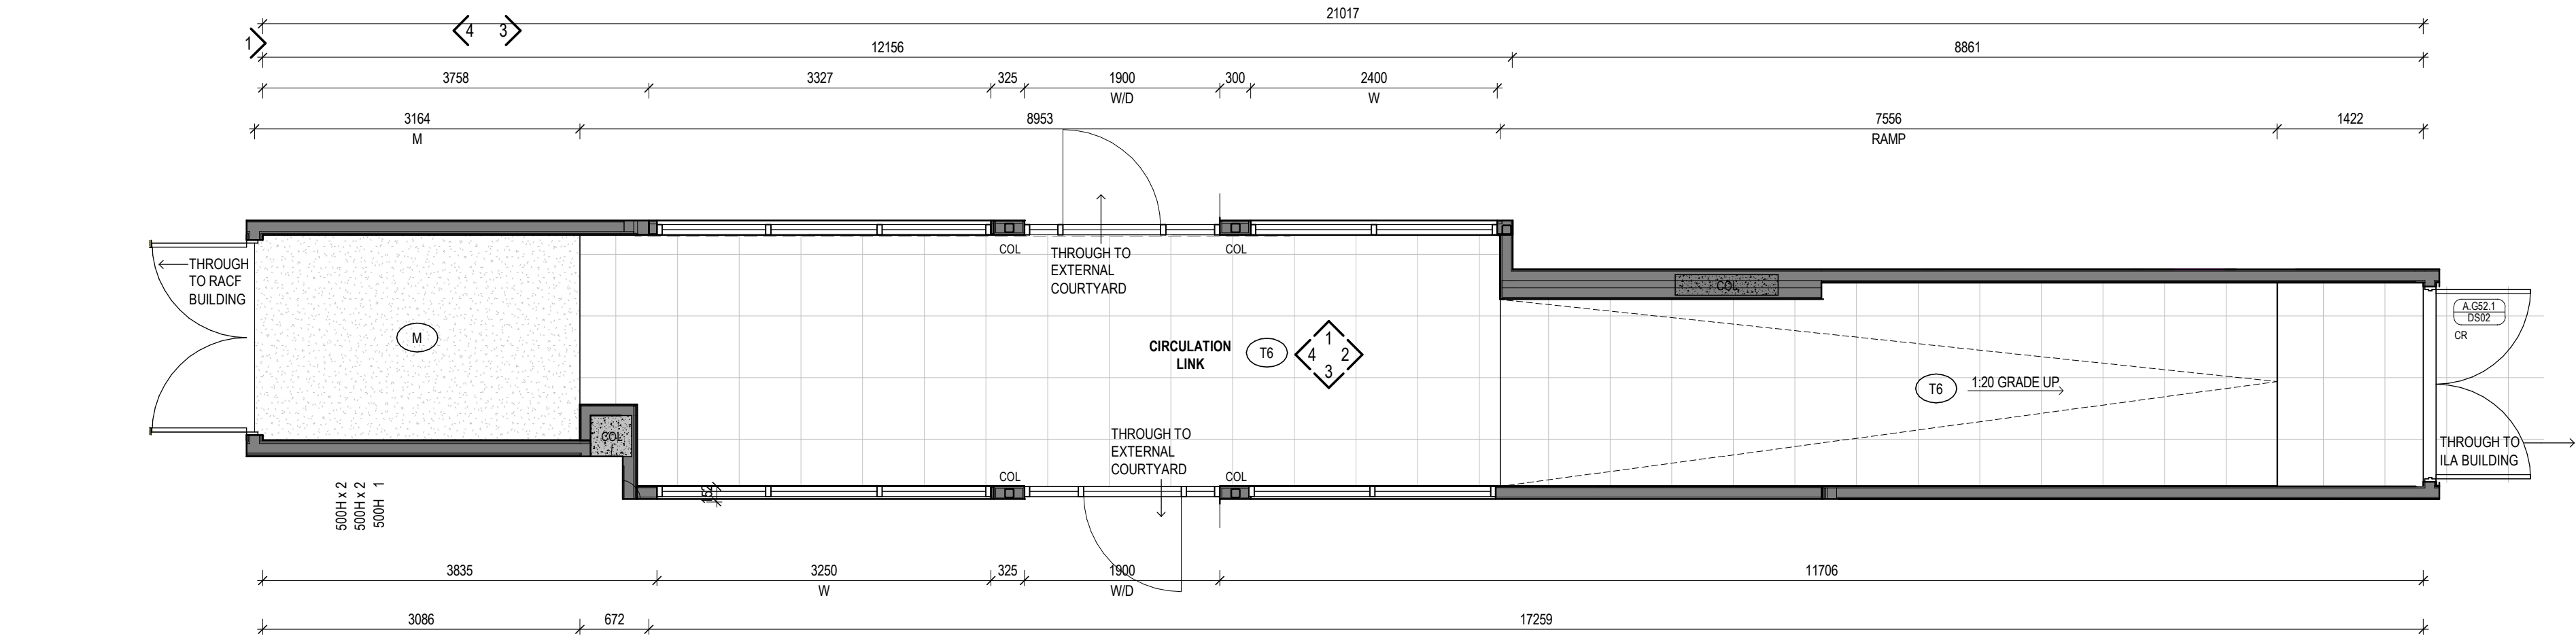

CIRCULATION LINK
ELEVATION 1
Scale 1 : 50

CIRCULATION LINK
ELEVATION 2
Scale 1 : 50

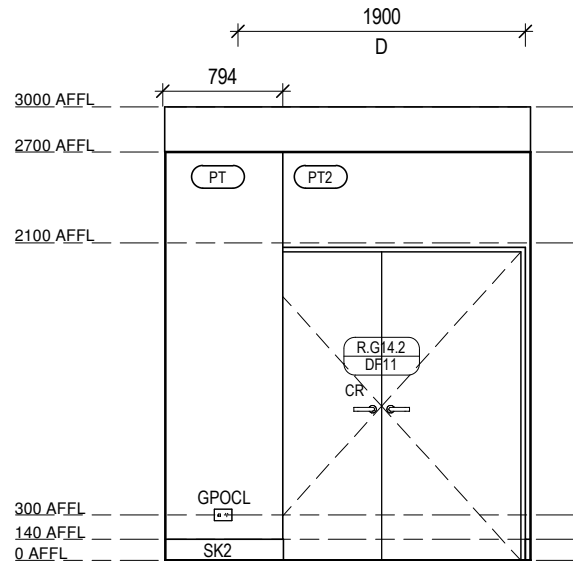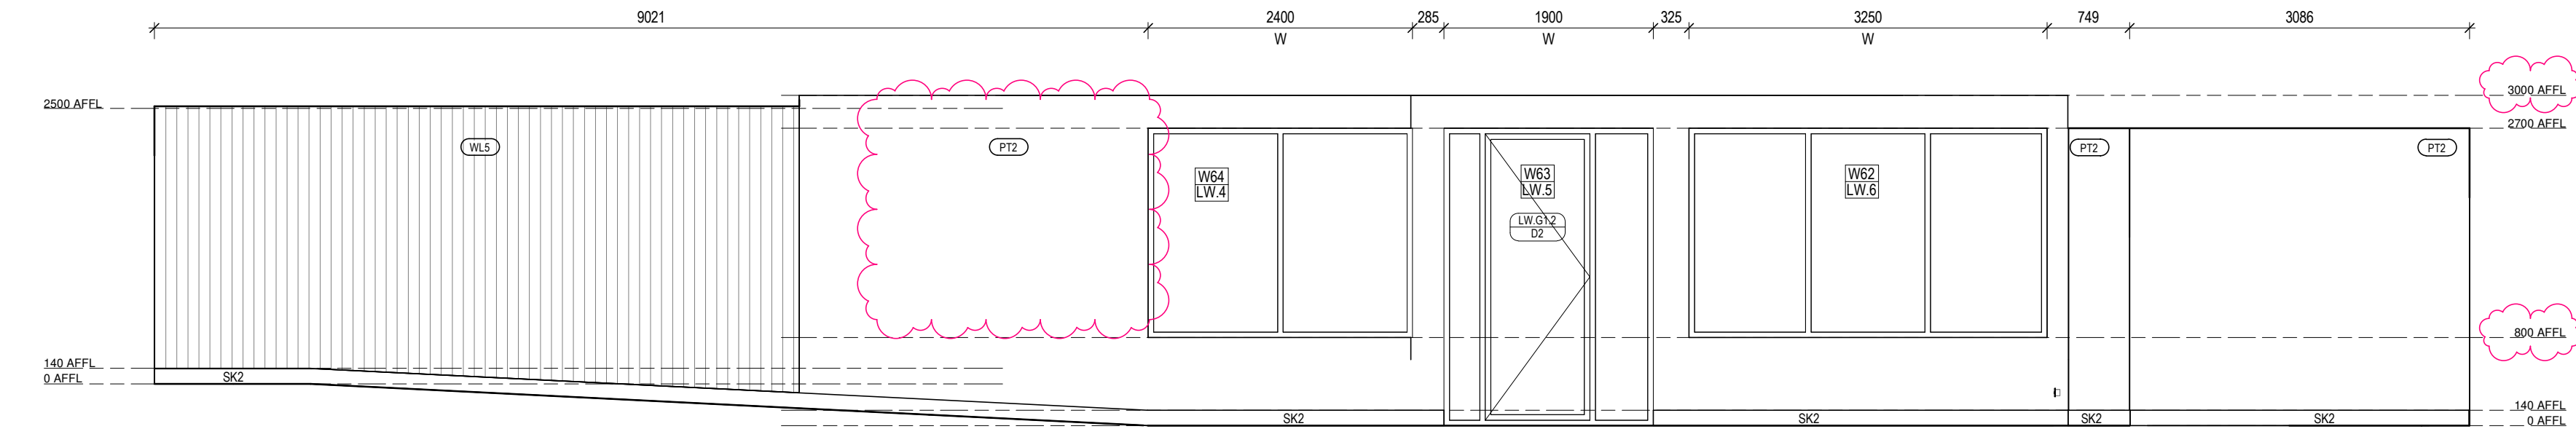

CIRCULATION LINK
ELEVATION 3
Scale 1 : 50

CIRCULATION LINK
ELEVATION 4
Scale 1 : 50

Revision/Issue	Date
P1 WIP Circulation Link	2025.08.27
P2 Linkway Comments/Preliminary Issue	2025.09.04

Clarke
Hopkins
Clarke

ClarkeHopkinsClarke

Melbourne

L9, Melbourne Connect

700 Swanston Street

Carlton Victoria 3053

Telephone (03) 9419 4340

Email studio@chc.com.au

www.chc.com.au

Sydney

3/78 Campbell Street

Sunny Hills NSW 2010

Telephone (02) 9221 9200

Email studio@chc.com.au

www.chc.com.au

Scale	As indicated @ A1
Date	01/03/2024
Drawn	EL
Architect	

Project
Summerset Oakleigh
52 Golf Road, Oakleigh South, VIC


Drawing
Internal Elevations - Circulation Link

Drawing No.


230185/A1850

P2

PRELIMINARY

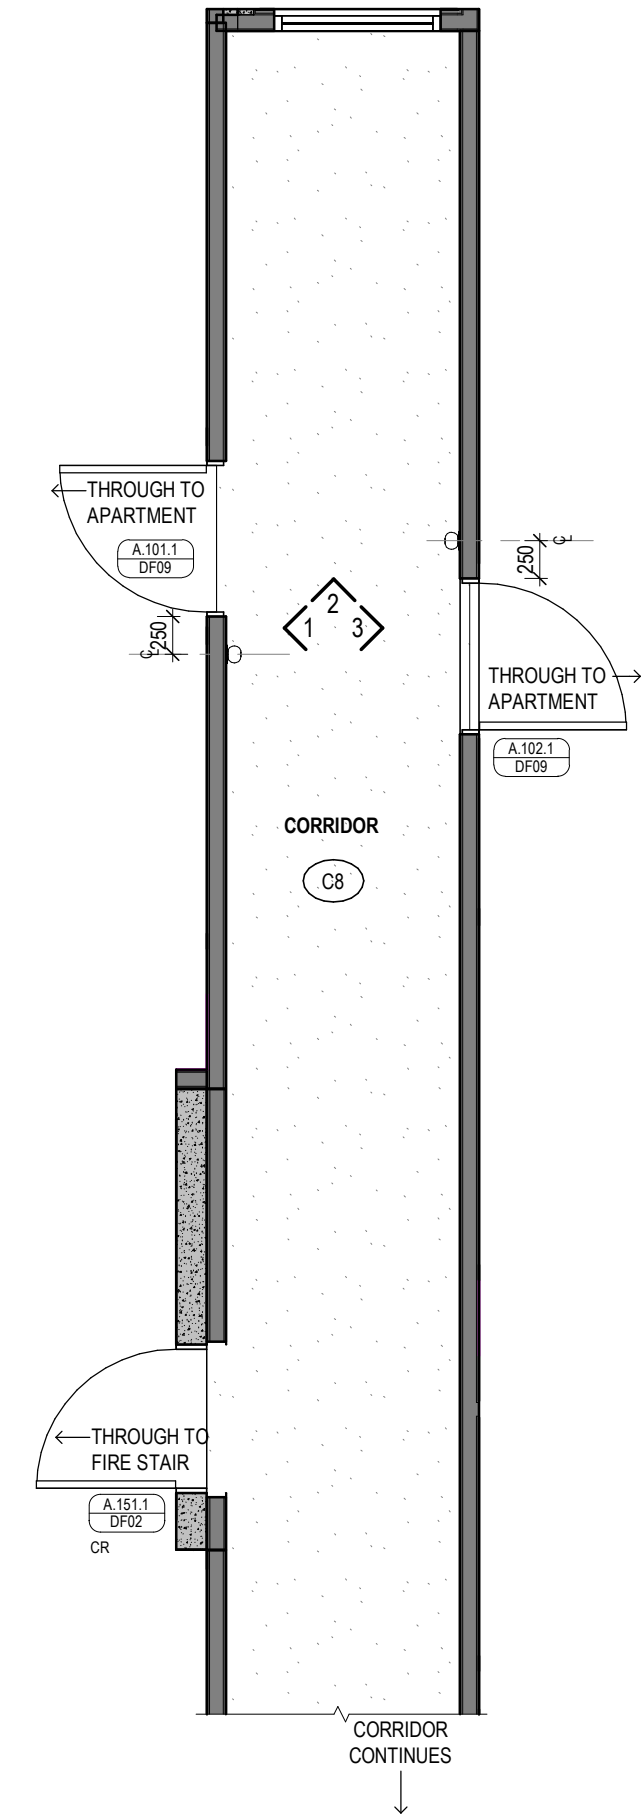


1 ILA - TYPICAL CORRIDOR
Scale 1: 50

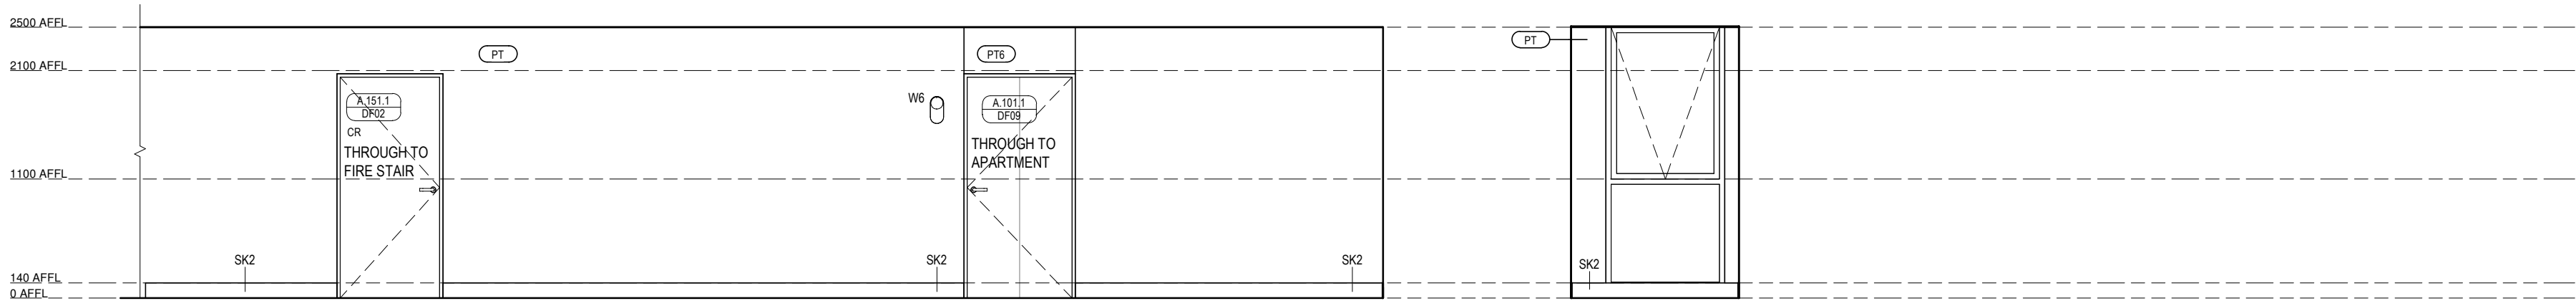

TYPICAL CORRIDOR
ELEVATION 1
Scale 1: 50

TYPICAL CORRIDOR
ELEVATION 2
Scale 1: 50

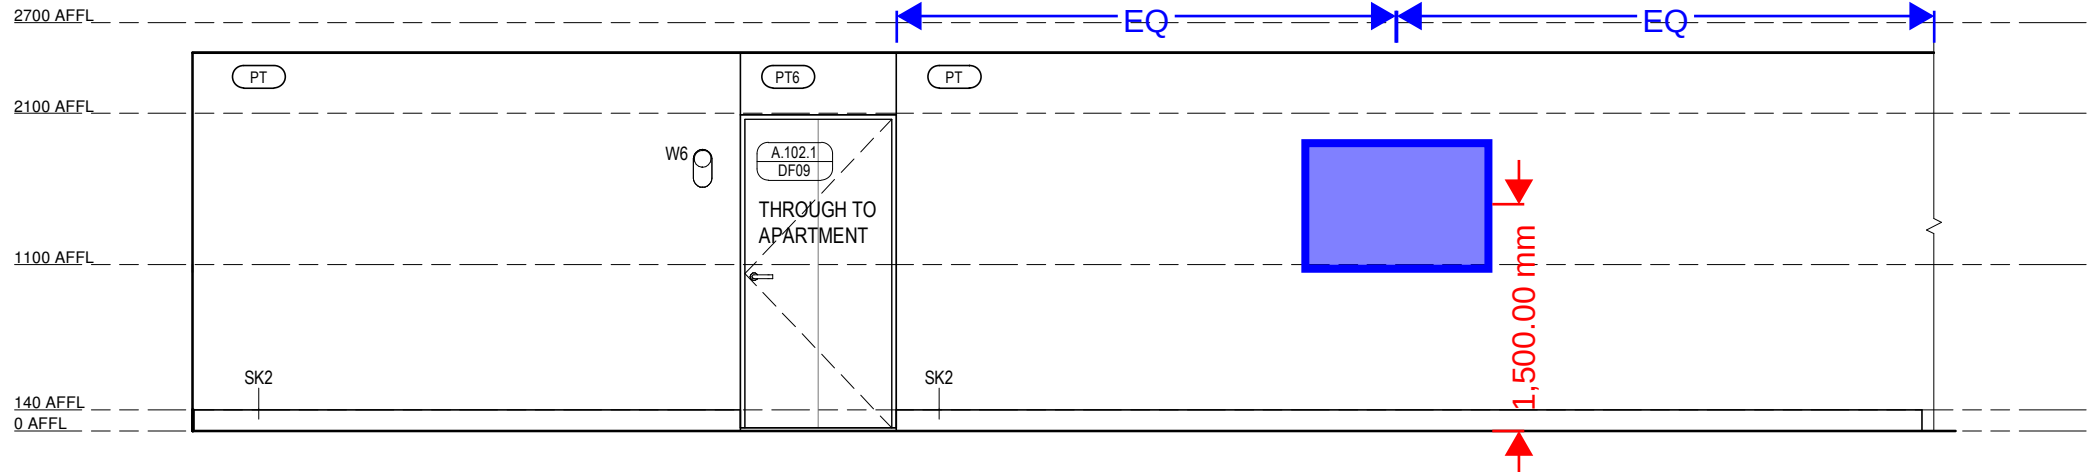

TYPICAL CORRIDOR
ELEVATION 3
Scale 1: 50

Legend - Internal Elevations

DRAWINGS TO BE READ IN CONJUNCTION WITH ARCHITECTURAL SPECIFICATION & MATERIALS, PRODUCTS & FINISHES SCHEDULE.

PT# PAINT FINISH TO ALL WALLS WITHIN NEW & AFFECTED ROOMS/ AREAS UNLESS OTHERWISE SHOWN

- CSE CONCRETE SEALER
- DPR DOOR PROTECTION
- GD GRAPHIC FILM
- LM LAMINATE
- MI MIRROR
- PBD PINBOARD
- PT PAINT FINISH
- REN RENDER FINISH
- SB SPLASHBACK
- STN STONE
- WB WHITEBOARD
- WP WALL PROTECTION
- WT WALL TILE
- WV WALL VINYL

NOTES:
1. LAMINATE CARCASS FOR ALL VISIBLE OPEN SHELVING, UNLESS OTHERWISE NOTED
2. MELAMINE TO ALL INTERNAL CARCASS OF JOINERY, UNLESS OTHERWISE NOTED.

Legend - Floor Finishes

- C CARPET
- CO CONCRETE
- D DECKING
- E EPOXY FINISH
- L LINOLEUM
- M MATTING
- PF PARTICLEBOARD FLOORING
- PU PAVING UNIT - TBC WITH LANDSCAPE
- PW PLYWOOD
- R RUBBER FLOORING
- T TILING
- TF TIMBER FLOORING
- V VINYL

Keynote Legend

- SK2 SKIRTING - TYPE 2
- W6 WALL LIGHT - TYPE 6

Feature Artwork

Standard Artwork

X-SML

X-Small - 600 x 600

SML

Small - 900 x 900

MED

Medium - 1200 x 800

LRG

Large - 1500x 800

XLG

X-Large - 1800 x 800

Revision/Issue
P1 Linkway Comments/Preliminary Issue
Date
2025.09.04

Clarke
Hopkins
Clarke

ClarkeHopkinsClarke
Melbourne
L9, Melbourne Connect
700 Swanston Street
Carlton Victoria 3053
Telephone (03) 9419 4340
Email studio@chc.com.au
www.chc.com.au

Sydney
3/78 Campbell Street
Sunny Hills NSW 2010
Telephone (02) 9221 9200
Email studio@chc.com.au
www.chc.com.au

Scale
Date
Drawn
Architect
As indicated @ A1
01/03/2024
EL
EL

Project
Summerset Oakleigh
52 Golf Road, Oakleigh South, VIC


Drawing
Internal Elevations - Corridors

Drawing No.


230185/A2830

P1


PRELIMINARY

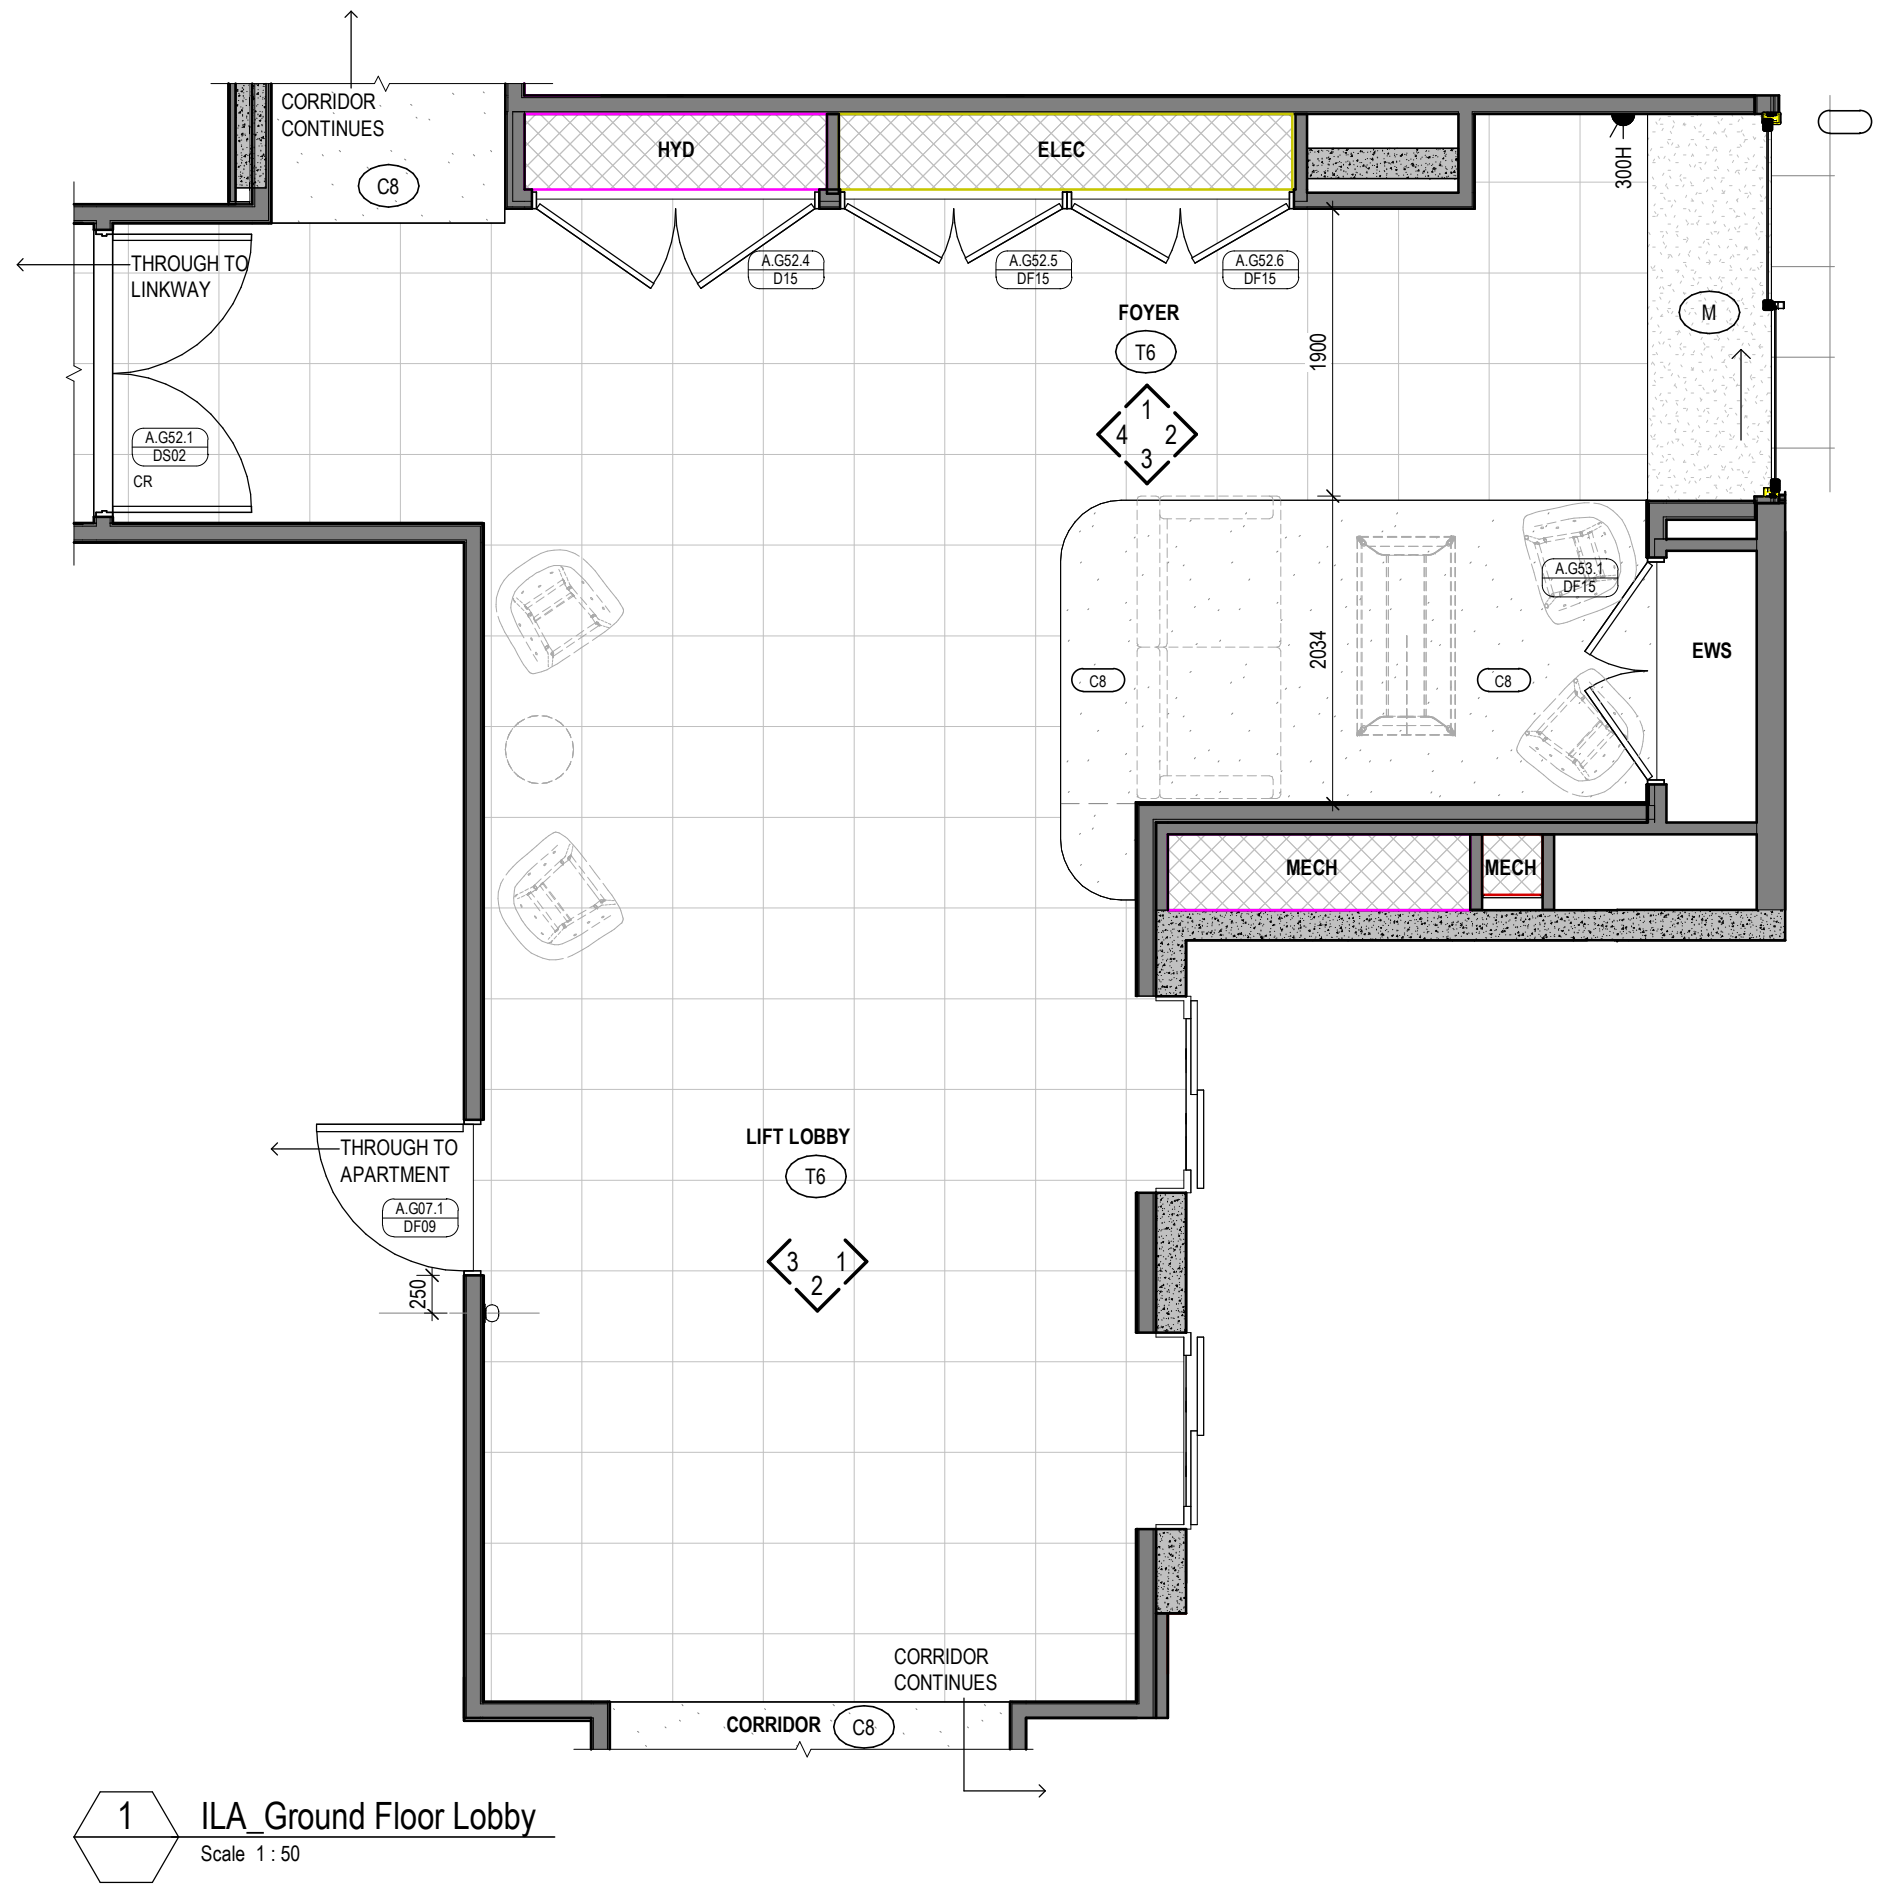


1 ILA Ground Floor Lobby
Scale 1: 50

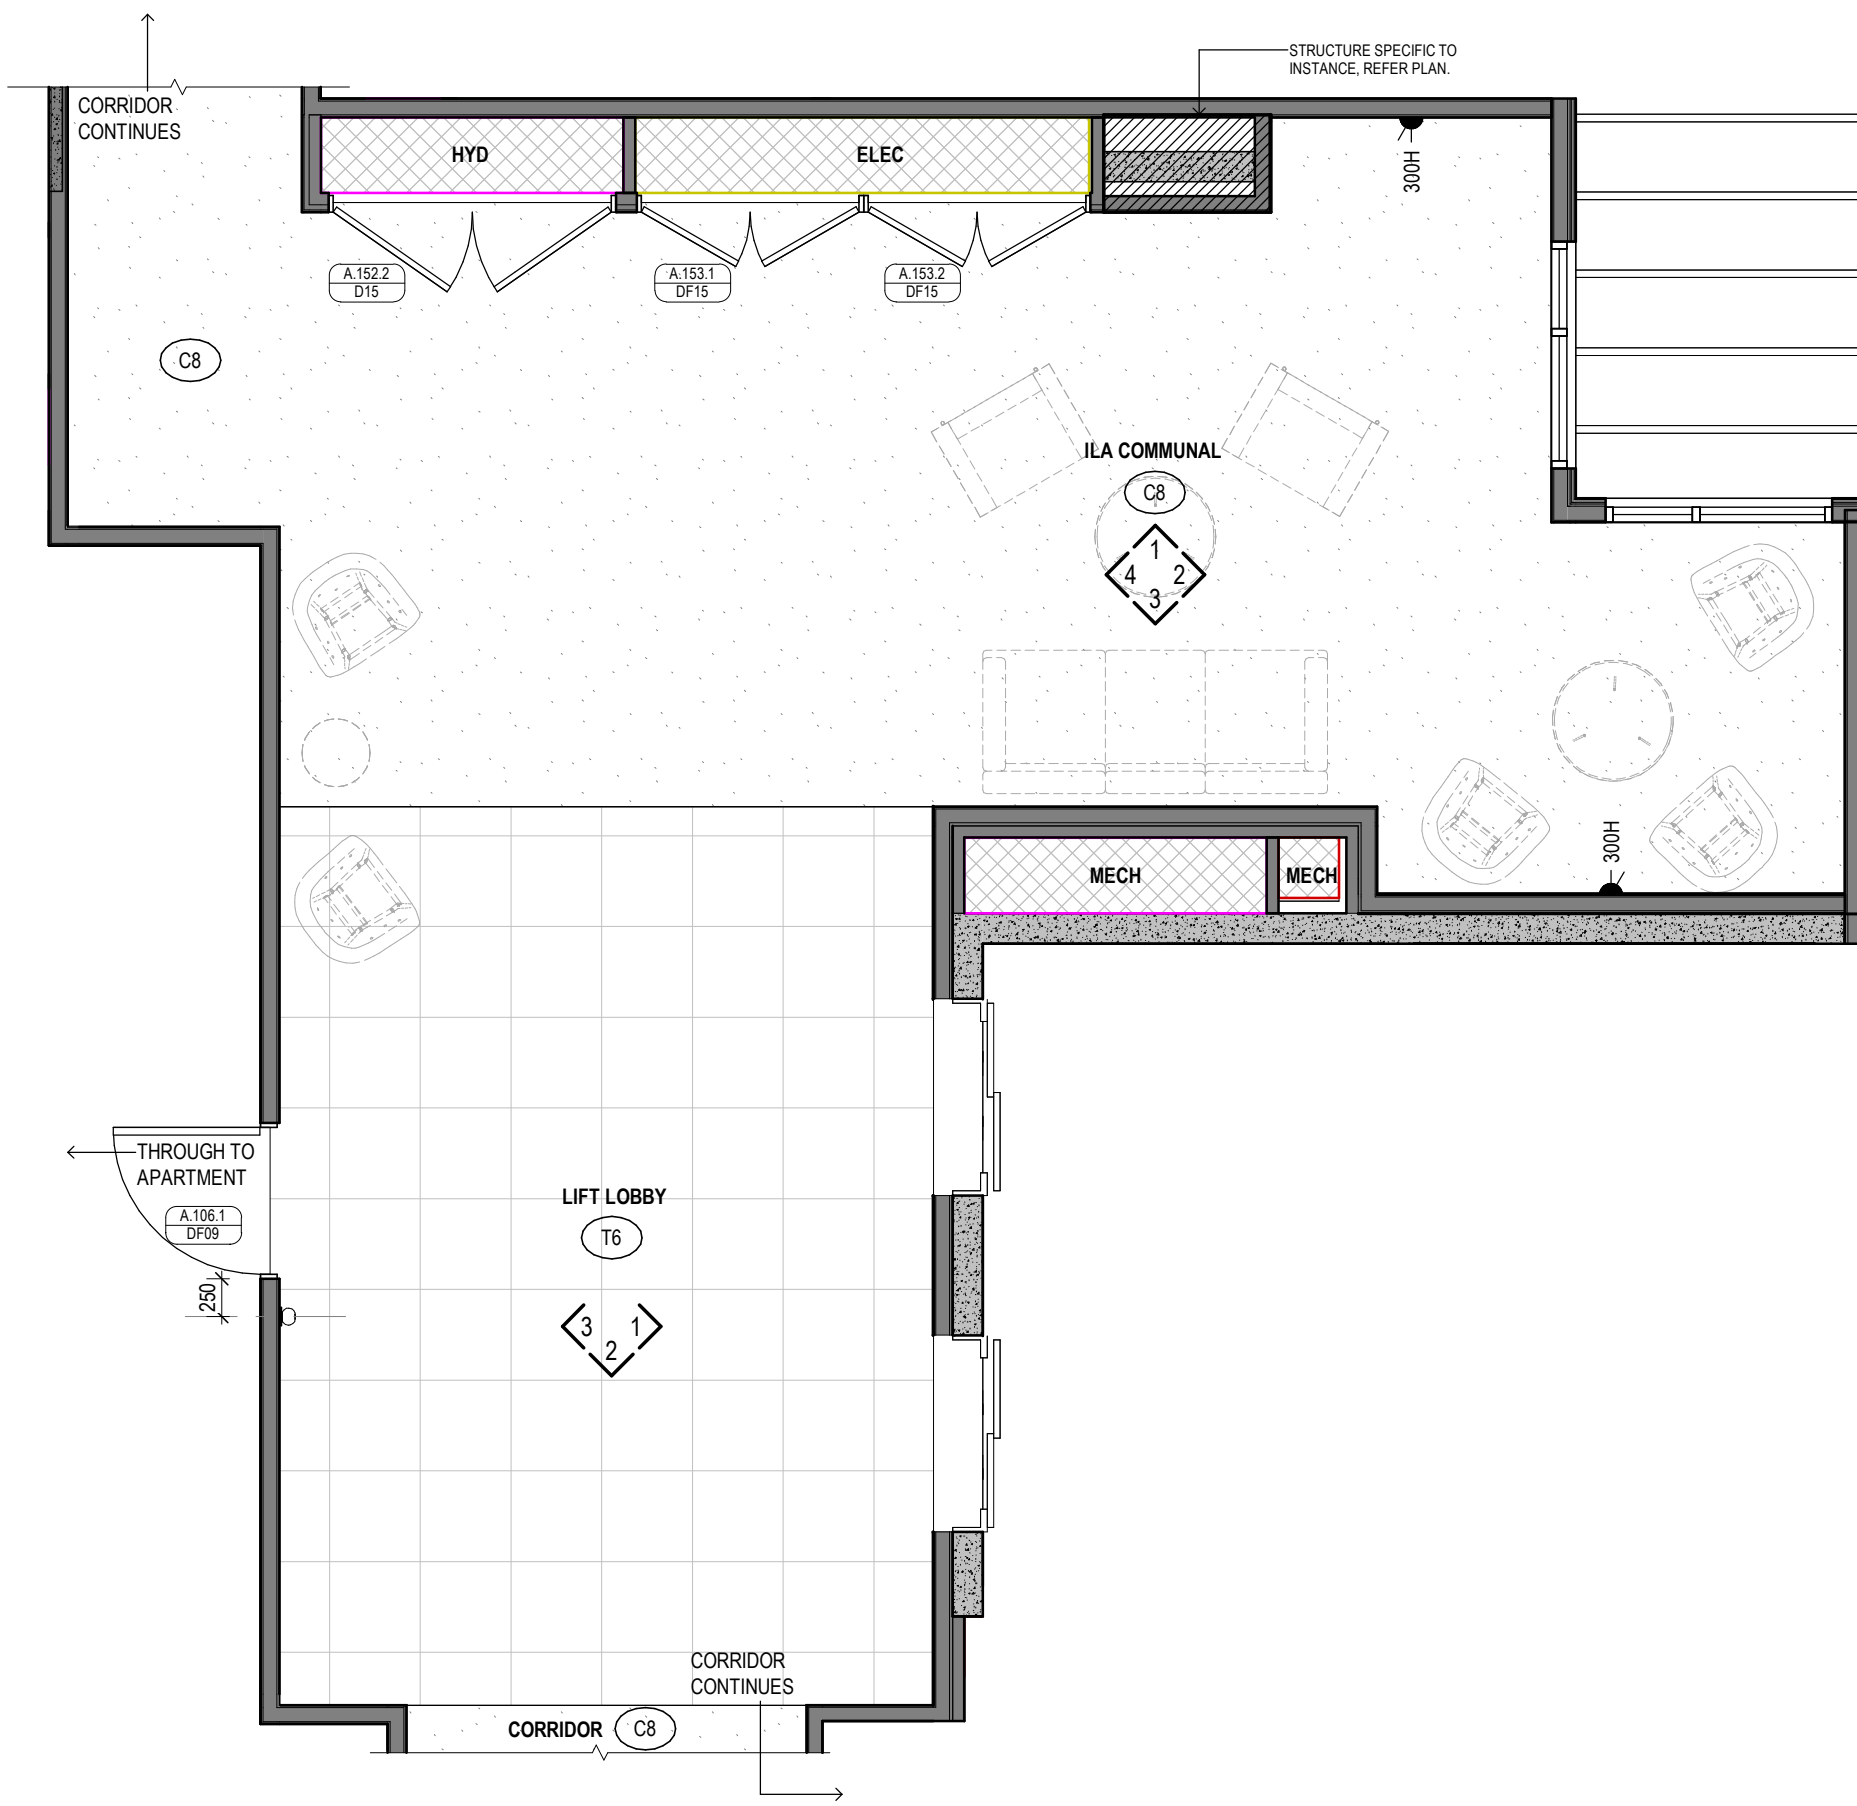


2 ILA L1+2 Lobby and Communal Space
Scale 1: 50

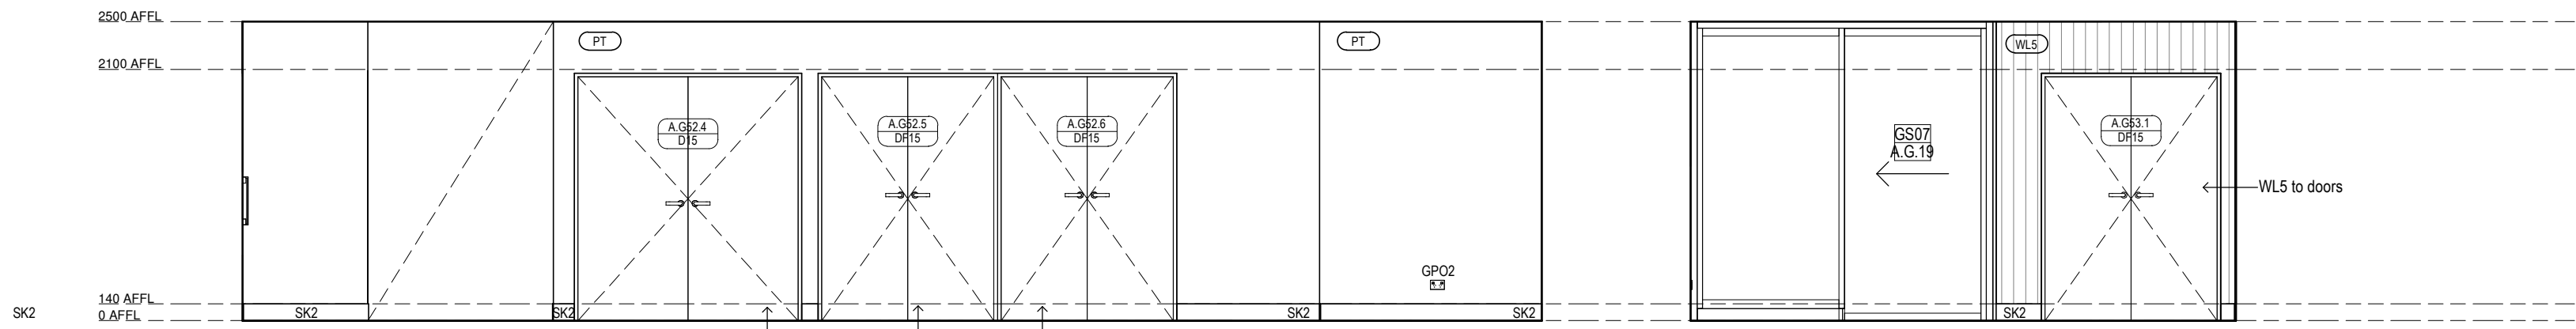


ILA Ground Floor Foyer
ELEVATION 1
Scale 1: 50

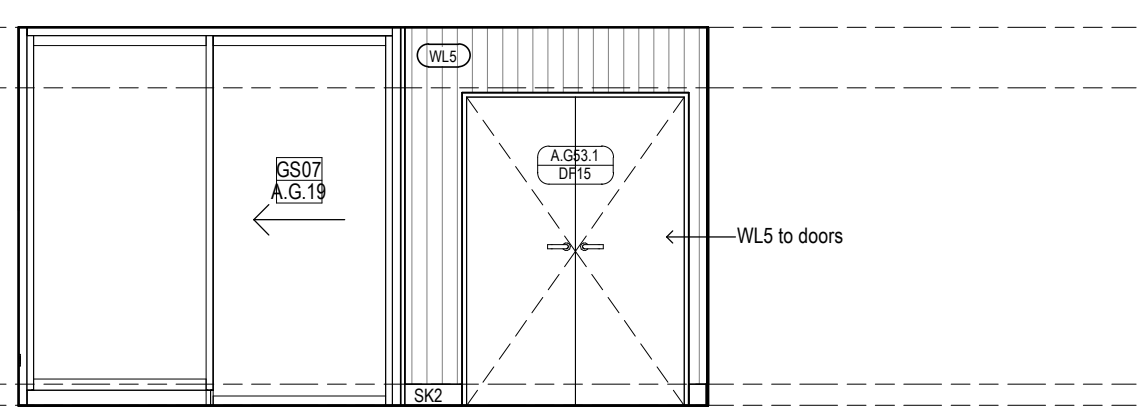


ILA Ground Floor Foyer
ELEVATION 2
Scale 1: 50

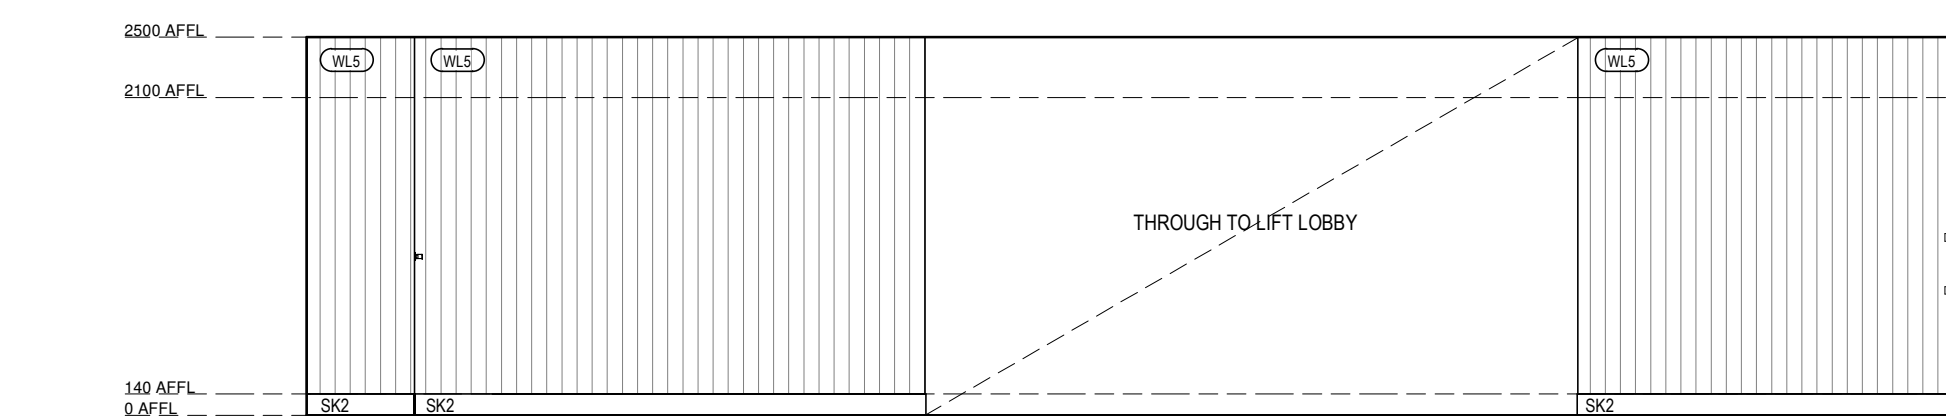

ILA Ground Floor Foyer
ELEVATION 3
Scale 1: 50

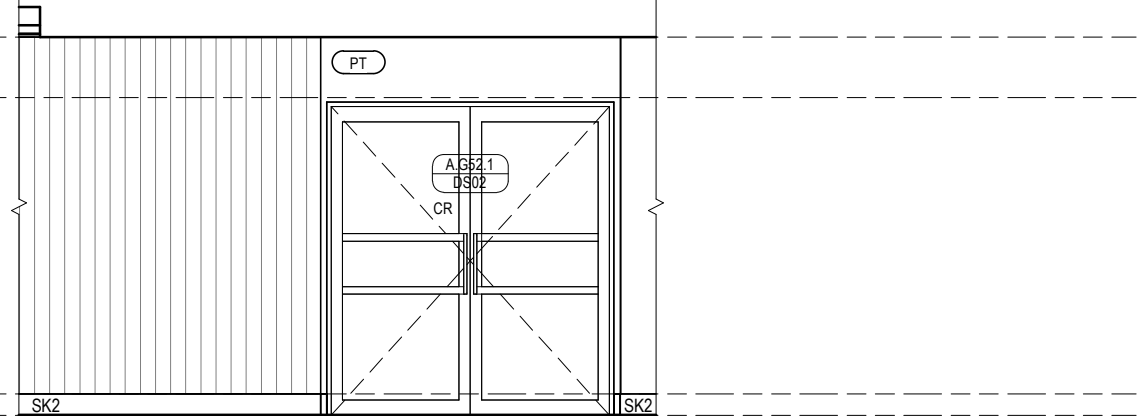


ILA Ground Floor Foyer
ELEVATION 4
Scale 1: 50

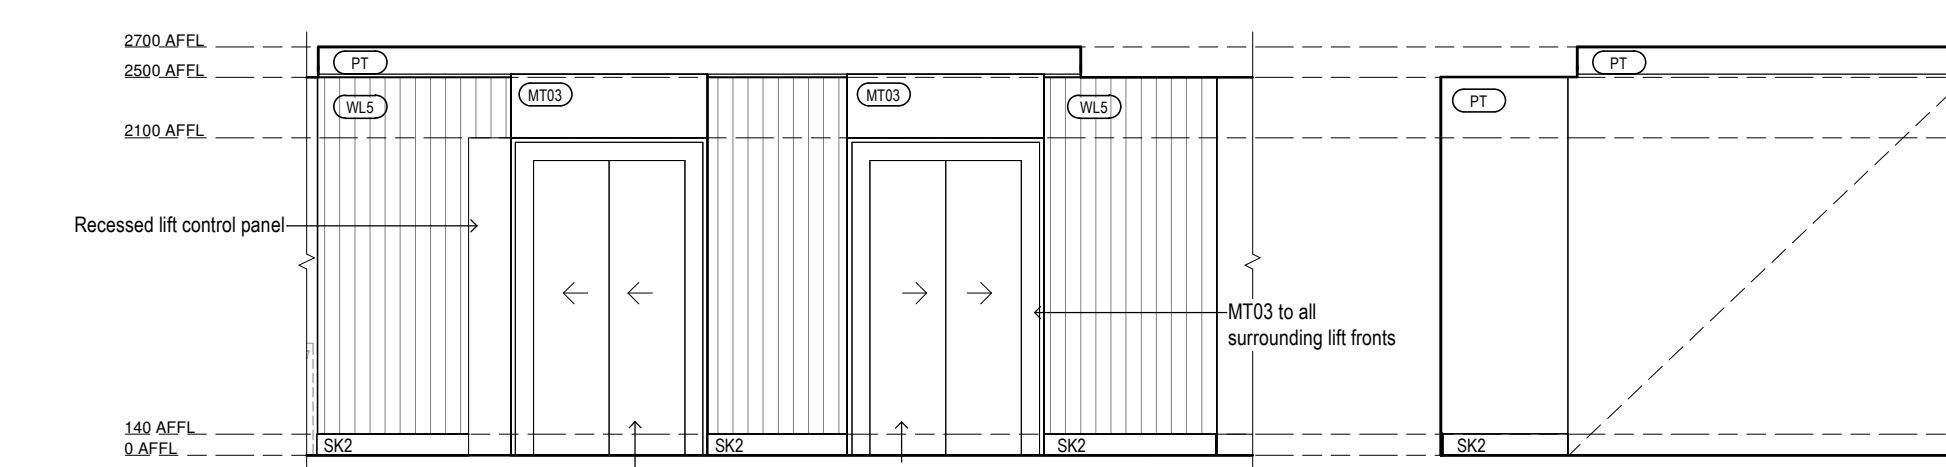


ILA Ground Floor Lift Lobby
ELEVATION 1
Scale 1: 50

ILA Ground Floor Lift Lobby
ELEVATION 2
Scale 1: 50


ILA Ground Floor Lift Lobby
ELEVATION 3
Scale 1: 50

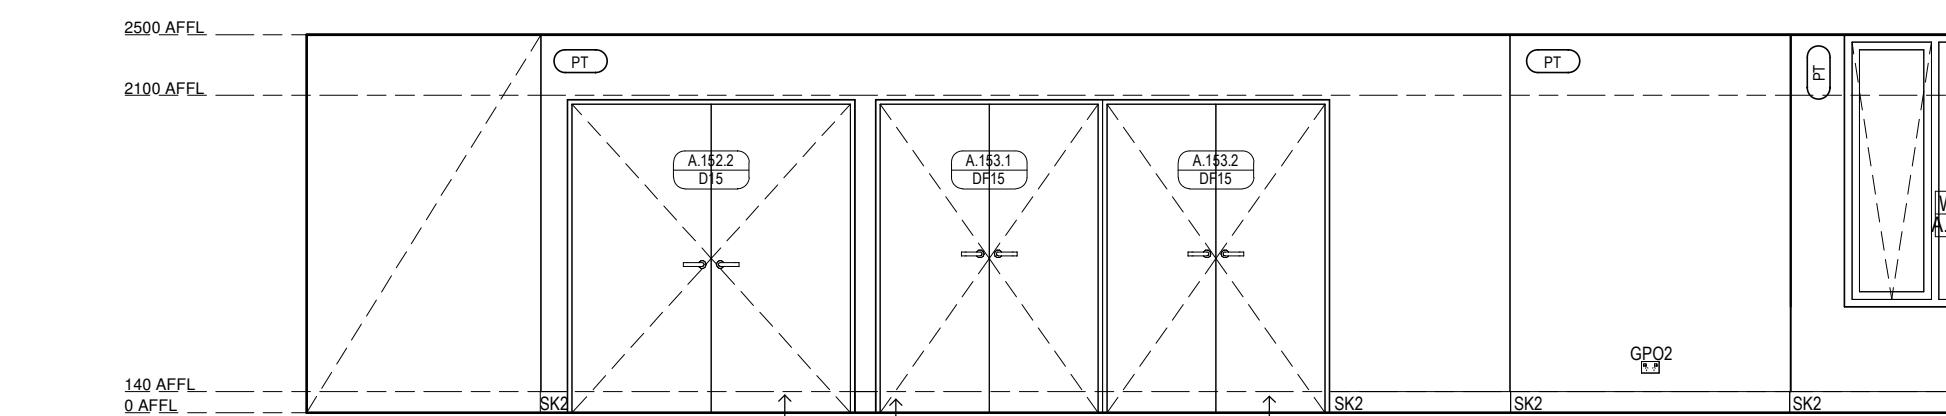

ILA L1+2 Communal Space
ELEVATION 1
Scale 1: 50

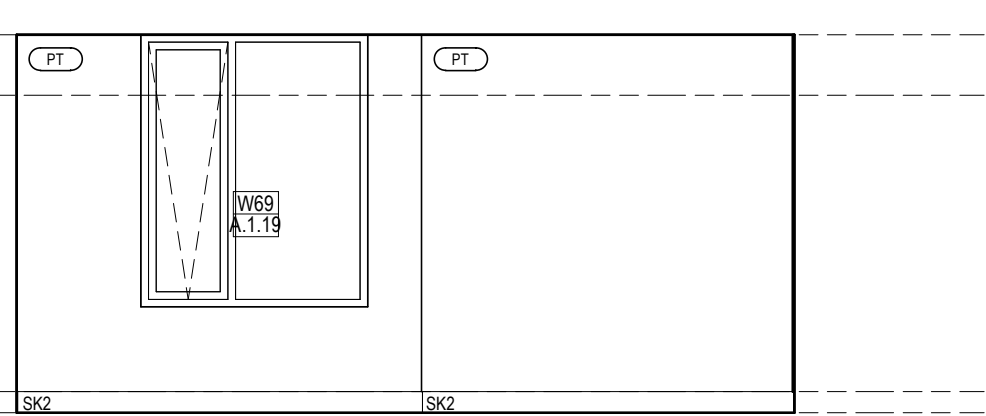


ILA L1+2 Communal Space
ELEVATION 2
Scale 1: 50

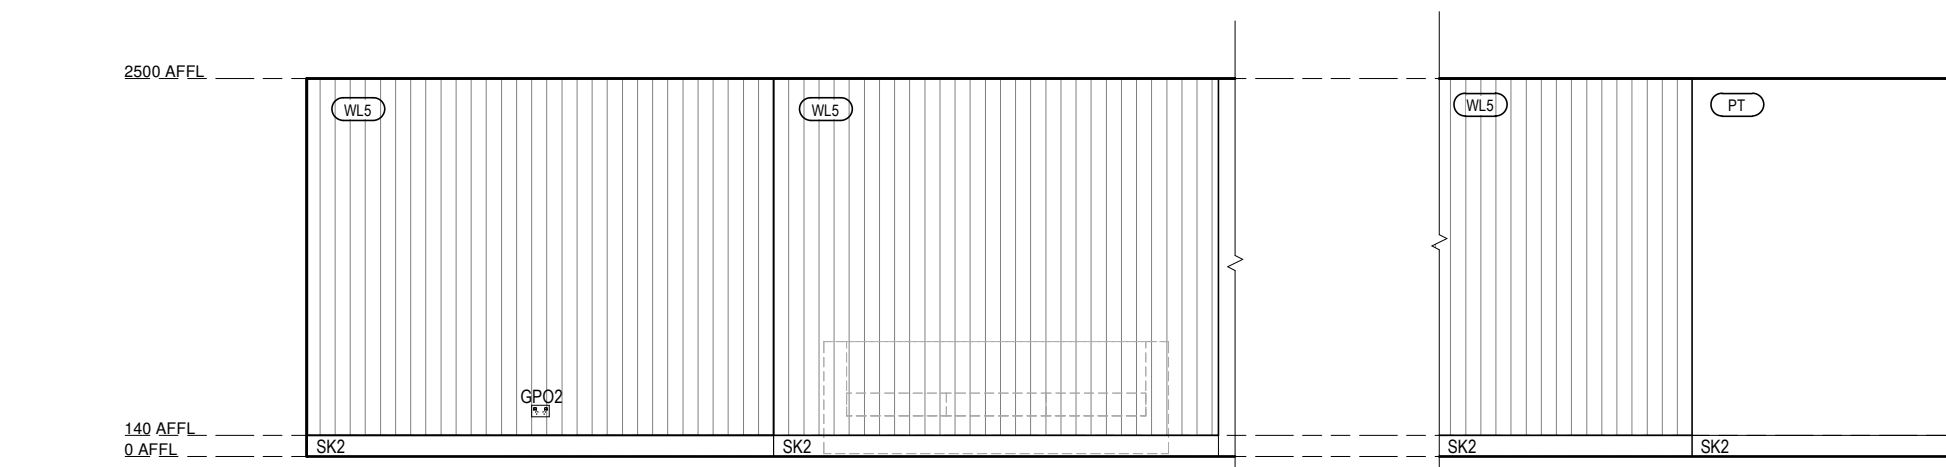


ILA L1+2 Communal Space
ELEVATION 3
Scale 1: 50

ILA L1+2 Communal Space
ELEVATION 4
Scale 1: 50

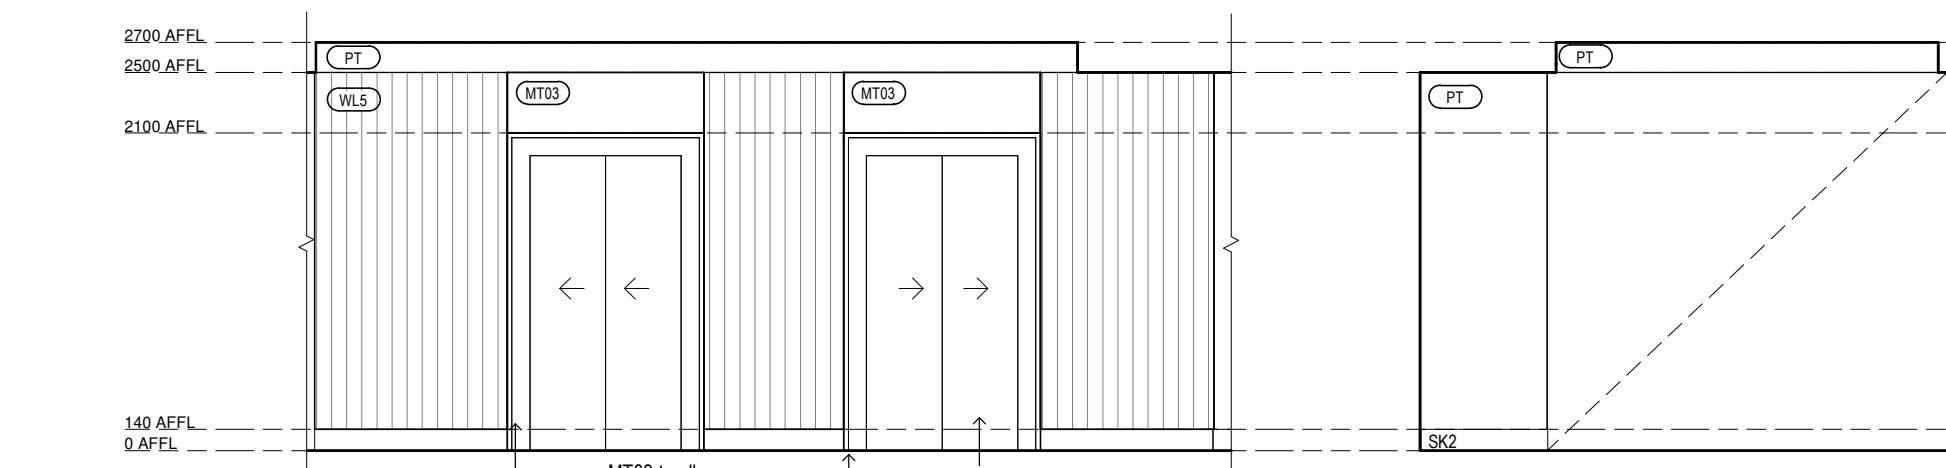

ILA L1+2 Lift Lobby
ELEVATION 1
Scale 1: 50

ILA L1+2 Lift Lobby
ELEVATION 2
Scale 1: 50

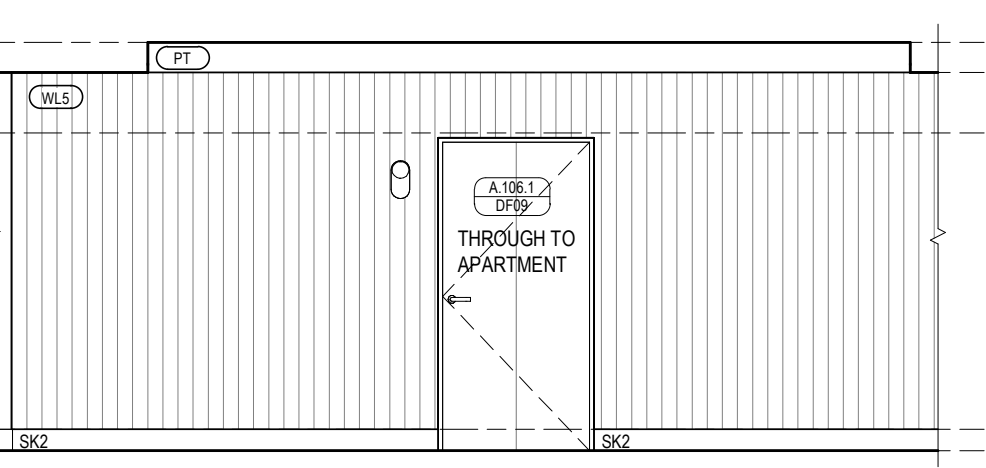

ILA L1+2 Lift Lobby
ELEVATION 3
Scale 1: 50

Legend - Internal Elevations

DRAWINGS TO BE READ IN CONJUNCTION WITH ARCHITECTURAL SPECIFICATION & MATERIALS, PRODUCTS & FINISHES SCHEDULE.
PT# PAINT FINISH TO ALL WALLS WITHIN NEW & AFFECTED ROOMS/ AREAS UNLESS OTHERWISE SHOWN

- CSE CONCRETE SEALER
- DPR DOOR PROTECTION
- GD GRAPHIC FILM
- LM LAMINATE
- MI MIRROR
- PBD PINBOARD
- PT PAINT FINISH
- REN RENDER FINISH
- SB SPLASHBACK
- STN STONE
- WB WHITEBOARD
- WP WALL PROTECTION
- WT WALL TILE
- WV WALL VINYL

NOTES:
1. LAMINATE CARCASS FOR ALL VISIBLE OPEN SHELVING, UNLESS OTHERWISE NOTED
2. MELAMINETO ALL INTERNAL CARCASS OF JOINERY, UNLESS OTHERWISE NOTED.

Legend - Floor Finishes

- C CARPET
- CO CONCRETE
- D DECKING
- E EPOXY FINISH
- L LINOLEUM
- M MATTING
- PF PARTICLEBOARD FLOORING
- PU PAVING UNIT - TBC WITH LANDSCAPE
- PW PLYWOOD
- R RUBBER FLOORING
- T TILING
- TF TIMBER FLOORING
- V VINYL

Keynote Legend

- GP02 POWER OUTLET - DOUBLE
- SK2 SKIRTING - TYPE 2

Feature Artwork

Standard Artwork

- X-SML X-Small - 600 x 600
- SML Small - 900 x 900
- MED Medium - 1200 x 800
- LRG Large - 1500x 800
- XLG X-Large - 1800 x 800

PRELIMINARY

Revision/Issue	Date
P1 Linkway Comments/Preliminary Issue	2025.09.04
P2 Tender Pack Issue	2025.09.05

Clarke Hopkins
architects

ClarkeHopkinsClarke
Melbourne
L9, Melbourne Connect
700 Swanston Street
Carlton Victoria 3053
Telephone (03) 9419 4340
Email studio@chc.com.au
www.chc.com.au

Sydney
3/78 Campbell Street
Sunny Hills NSW 2010
Telephone (02) 9221 9200
Email studio@chc.com.au
www.chc.com.au

Scale	As indicated @ A1
Date	01/03/2024
Drawn	TM
Architect	EL

Project
Summerset Oakleigh
52 Golf Road, Oakleigh South, VIC

Drawing
Internal Elevations - Lobby and Communal Space - Sheet 1

Drawing No.
230185/A2831
P2

General Notes

BUILDER TO VIEW THE SITE DURING THE TENDER PERIOD TO SATISFY THEMSELVES OF THE LATENT SITE CONDITIONS AND FULL EXTENT OF WORK AS REQUIRED TO ALLOW FOR THE COMPLETION OF ALL WORKS AS DETAILED IN ALL DOCUMENTATION.


ALL DOCUMENTS ARE TO BE REVIEWED IN CONJUNCTION WITH RELEVANT CONSULTANTS DRAWINGS AND SPECIFICATIONS.

CONTRACTOR TO USE 92MM STUD FRAMING UNLESS NOTED OTHERWISE. ALL WALL LININGS TO EXTEND TO 150mm ABOVE THE CEILING UNLESS NOTED OTHERWISE. ALL

ALLOW FOR WALL STRENGTHENING BEHIND WALL MOUNTED FIXTURES AND FITTINGS INCLUDING BUT NOT LIMITED TO GRABRAILS, HANDRAILS, EQUIPMENT HOOKS, DRUG SAFES.

Legend - General

- WALL TYPE
- RELATIVE LEVEL
- PROPOSED FINISH LEVEL
- TRAVEL PATH

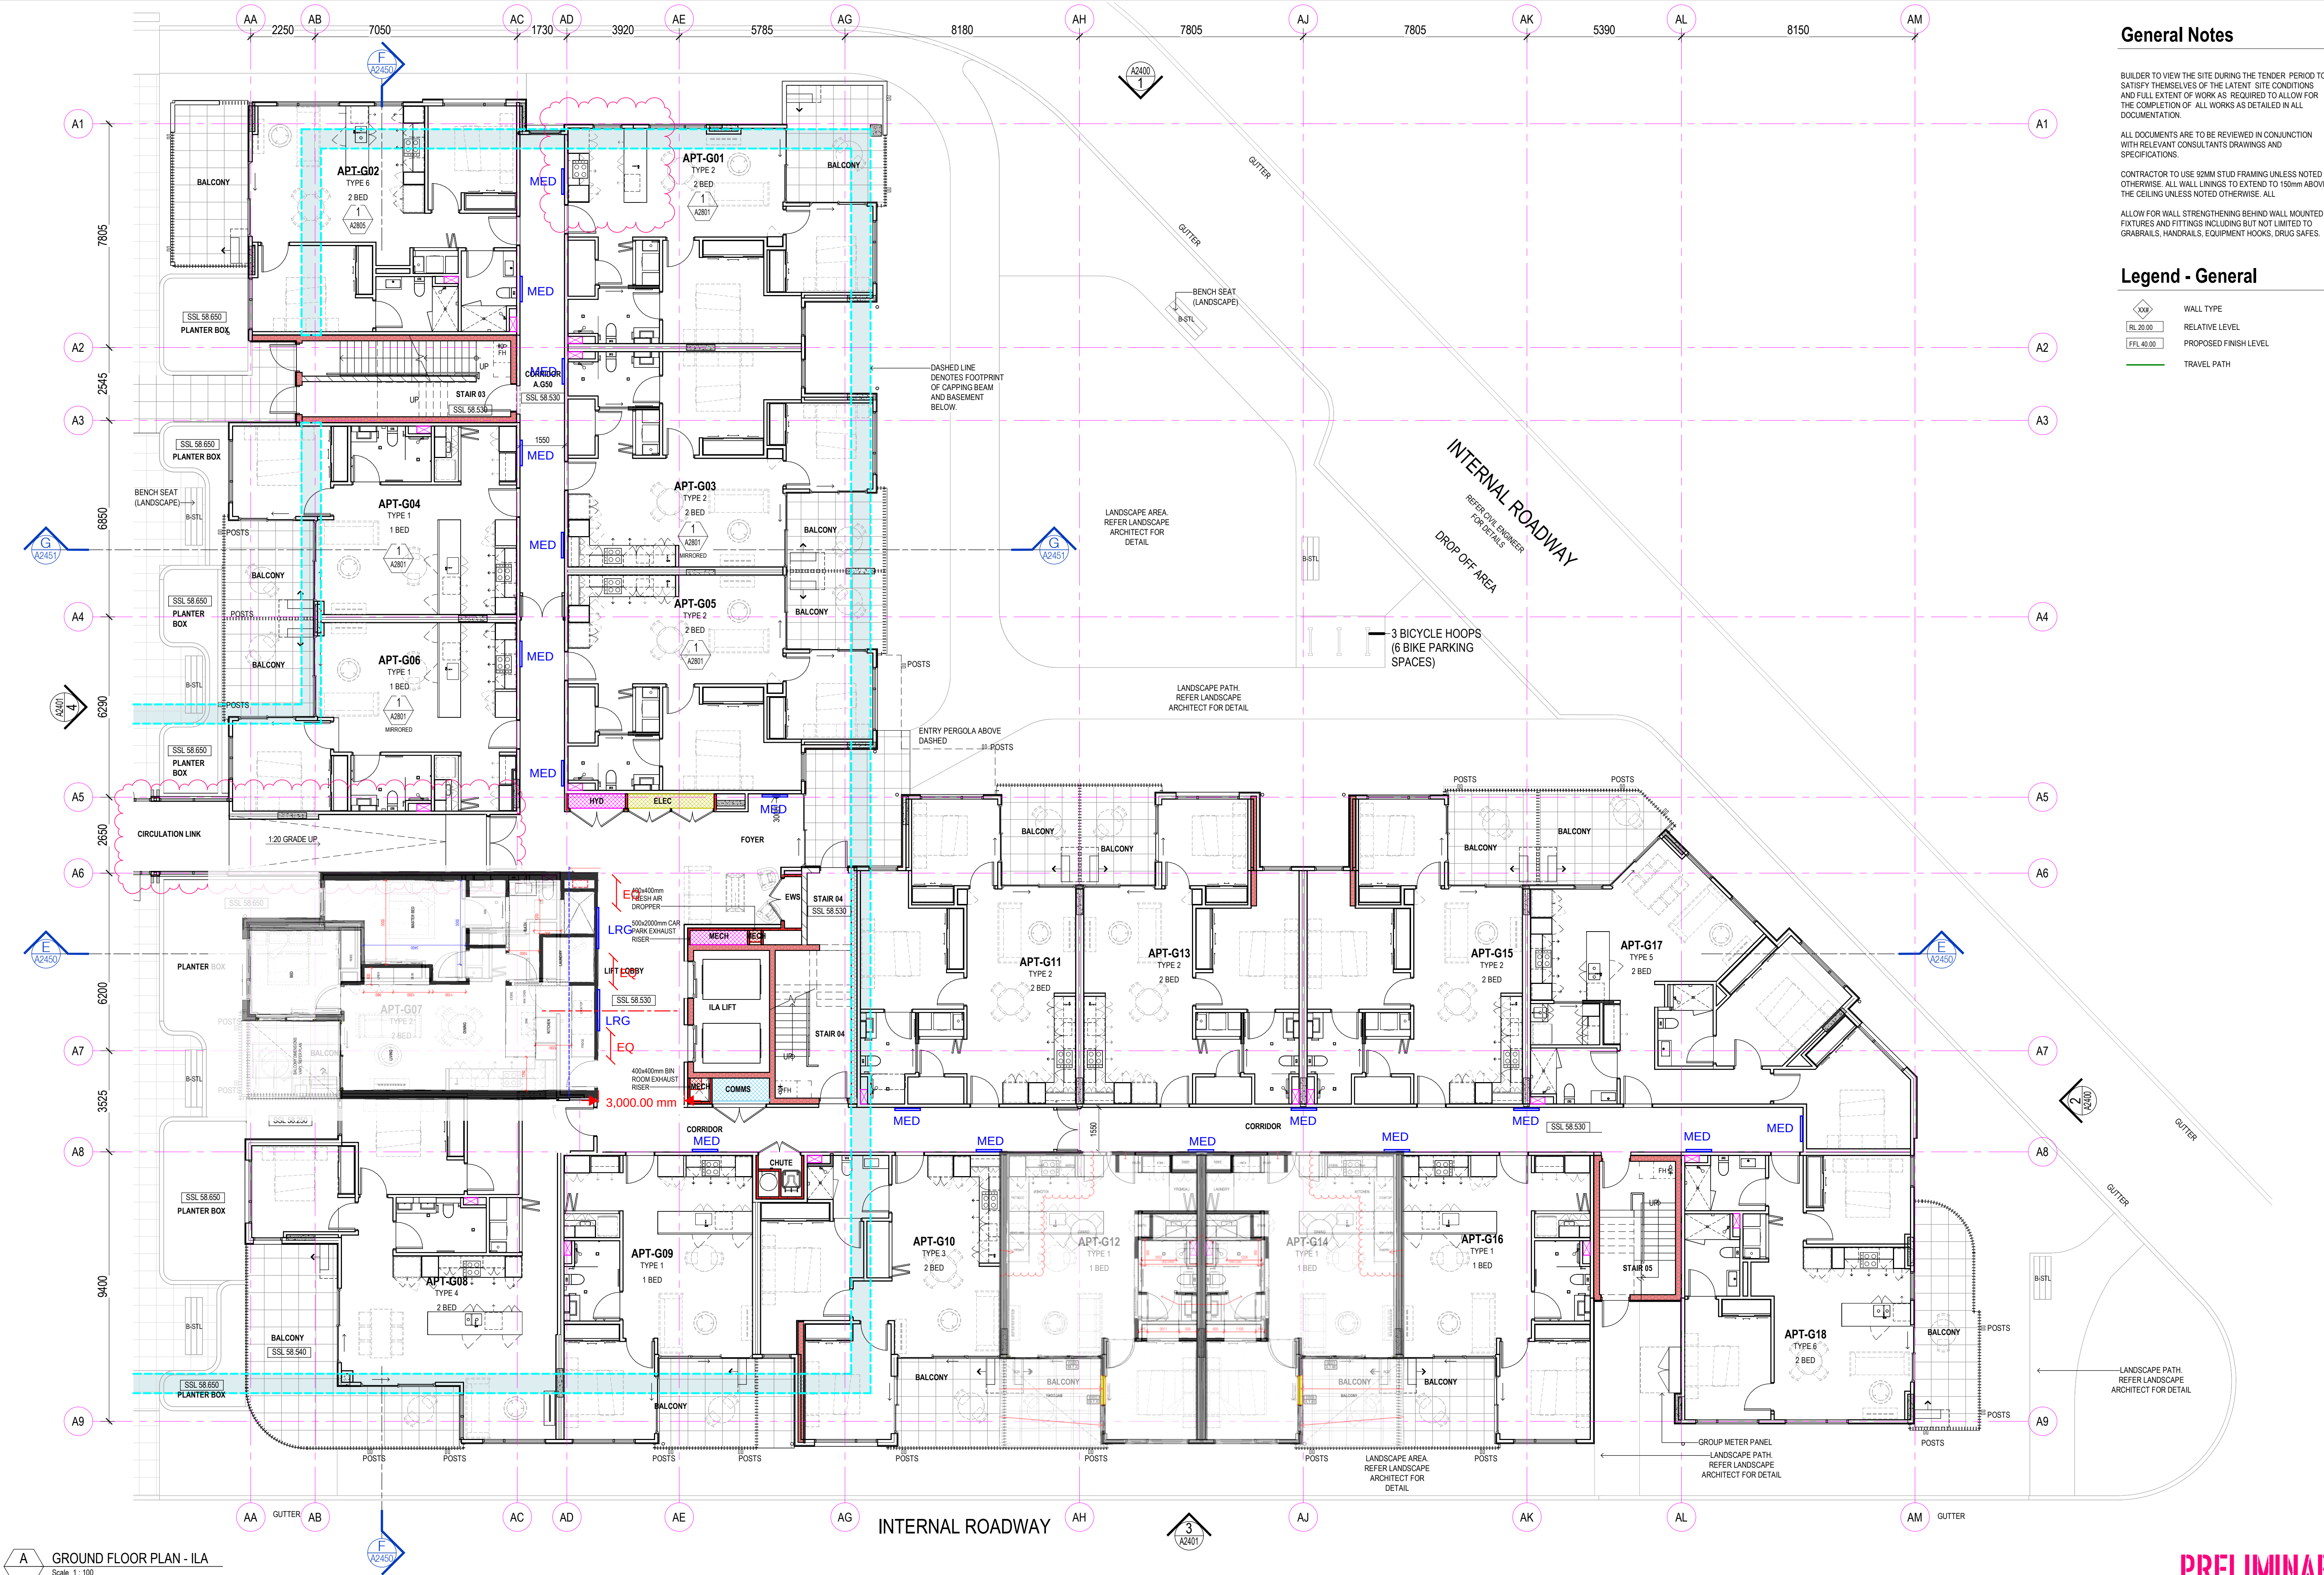

A GROUND FLOOR PLAN - ILA

Scale 1:100

Revision/Issue	Date
P5 Preliminary GA Plan Issue for Co-ordination and Review	2025.07.29
P6 Updated GA Set	2025.08.21
P7 Tender Pack Issue	2025.09.05

**Clarke
Hopkins
Clarke**

ClarkeHopkinsClarke

Melbourne

L3, Melbourne Connect

700 Swanston Street

Carlton Victoria 3053

Telephone (03) 9419 4340

Email studio@chc.com.au

www.chc.com.au

Sydney

3/78 Campbell Street

Sunny Hills NSW 2010

Telephone (02) 9221 9200

Email studio@chc.com.au

www.chc.com.au

Scale	1:100 @ A1
Date	01/03/2024
Drawn	TMAC
Architect	EL



Project
Summerset Oakleigh
52 Golf Road, Oakleigh South, VIC

Drawing
General Arrangement Plan - Ground Floor

Drawing No.
230185/A2200

P7

PRELIMINARY

General Notes

BUILDER TO VIEW THE SITE DURING THE TENDER PERIOD TO SATISFY THEMSELVES OF THE LATENT SITE CONDITIONS AND FULL EXTENT OF WORK AS REQUIRED TO ALLOW FOR THE COMPLETION OF ALL WORKS AS DETAILED IN ALL DOCUMENTATION.


ALL DOCUMENTS ARE TO BE REVIEWED IN CONJUNCTION WITH RELEVANT CONSULTANTS DRAWINGS AND SPECIFICATIONS.

CONTRACTOR TO USE 92MM STUD FRAMING UNLESS NOTED OTHERWISE. ALL WALL LININGS TO EXTEND TO 150mm ABOVE THE CEILING UNLESS NOTED OTHERWISE. ALL

ALLOW FOR WALL STRENGTHENING BEHIND WALL MOUNTED FIXTURES AND FITTINGS INCLUDING BUT NOT LIMITED TO GRABRAILS, HANDRAILS, EQUIPMENT HOOKS, DRUG SAFES.

Legend - General

- WALL TYPE
- RELATIVE LEVEL
- PROPOSED FINISH LEVEL
- TRAVEL PATH

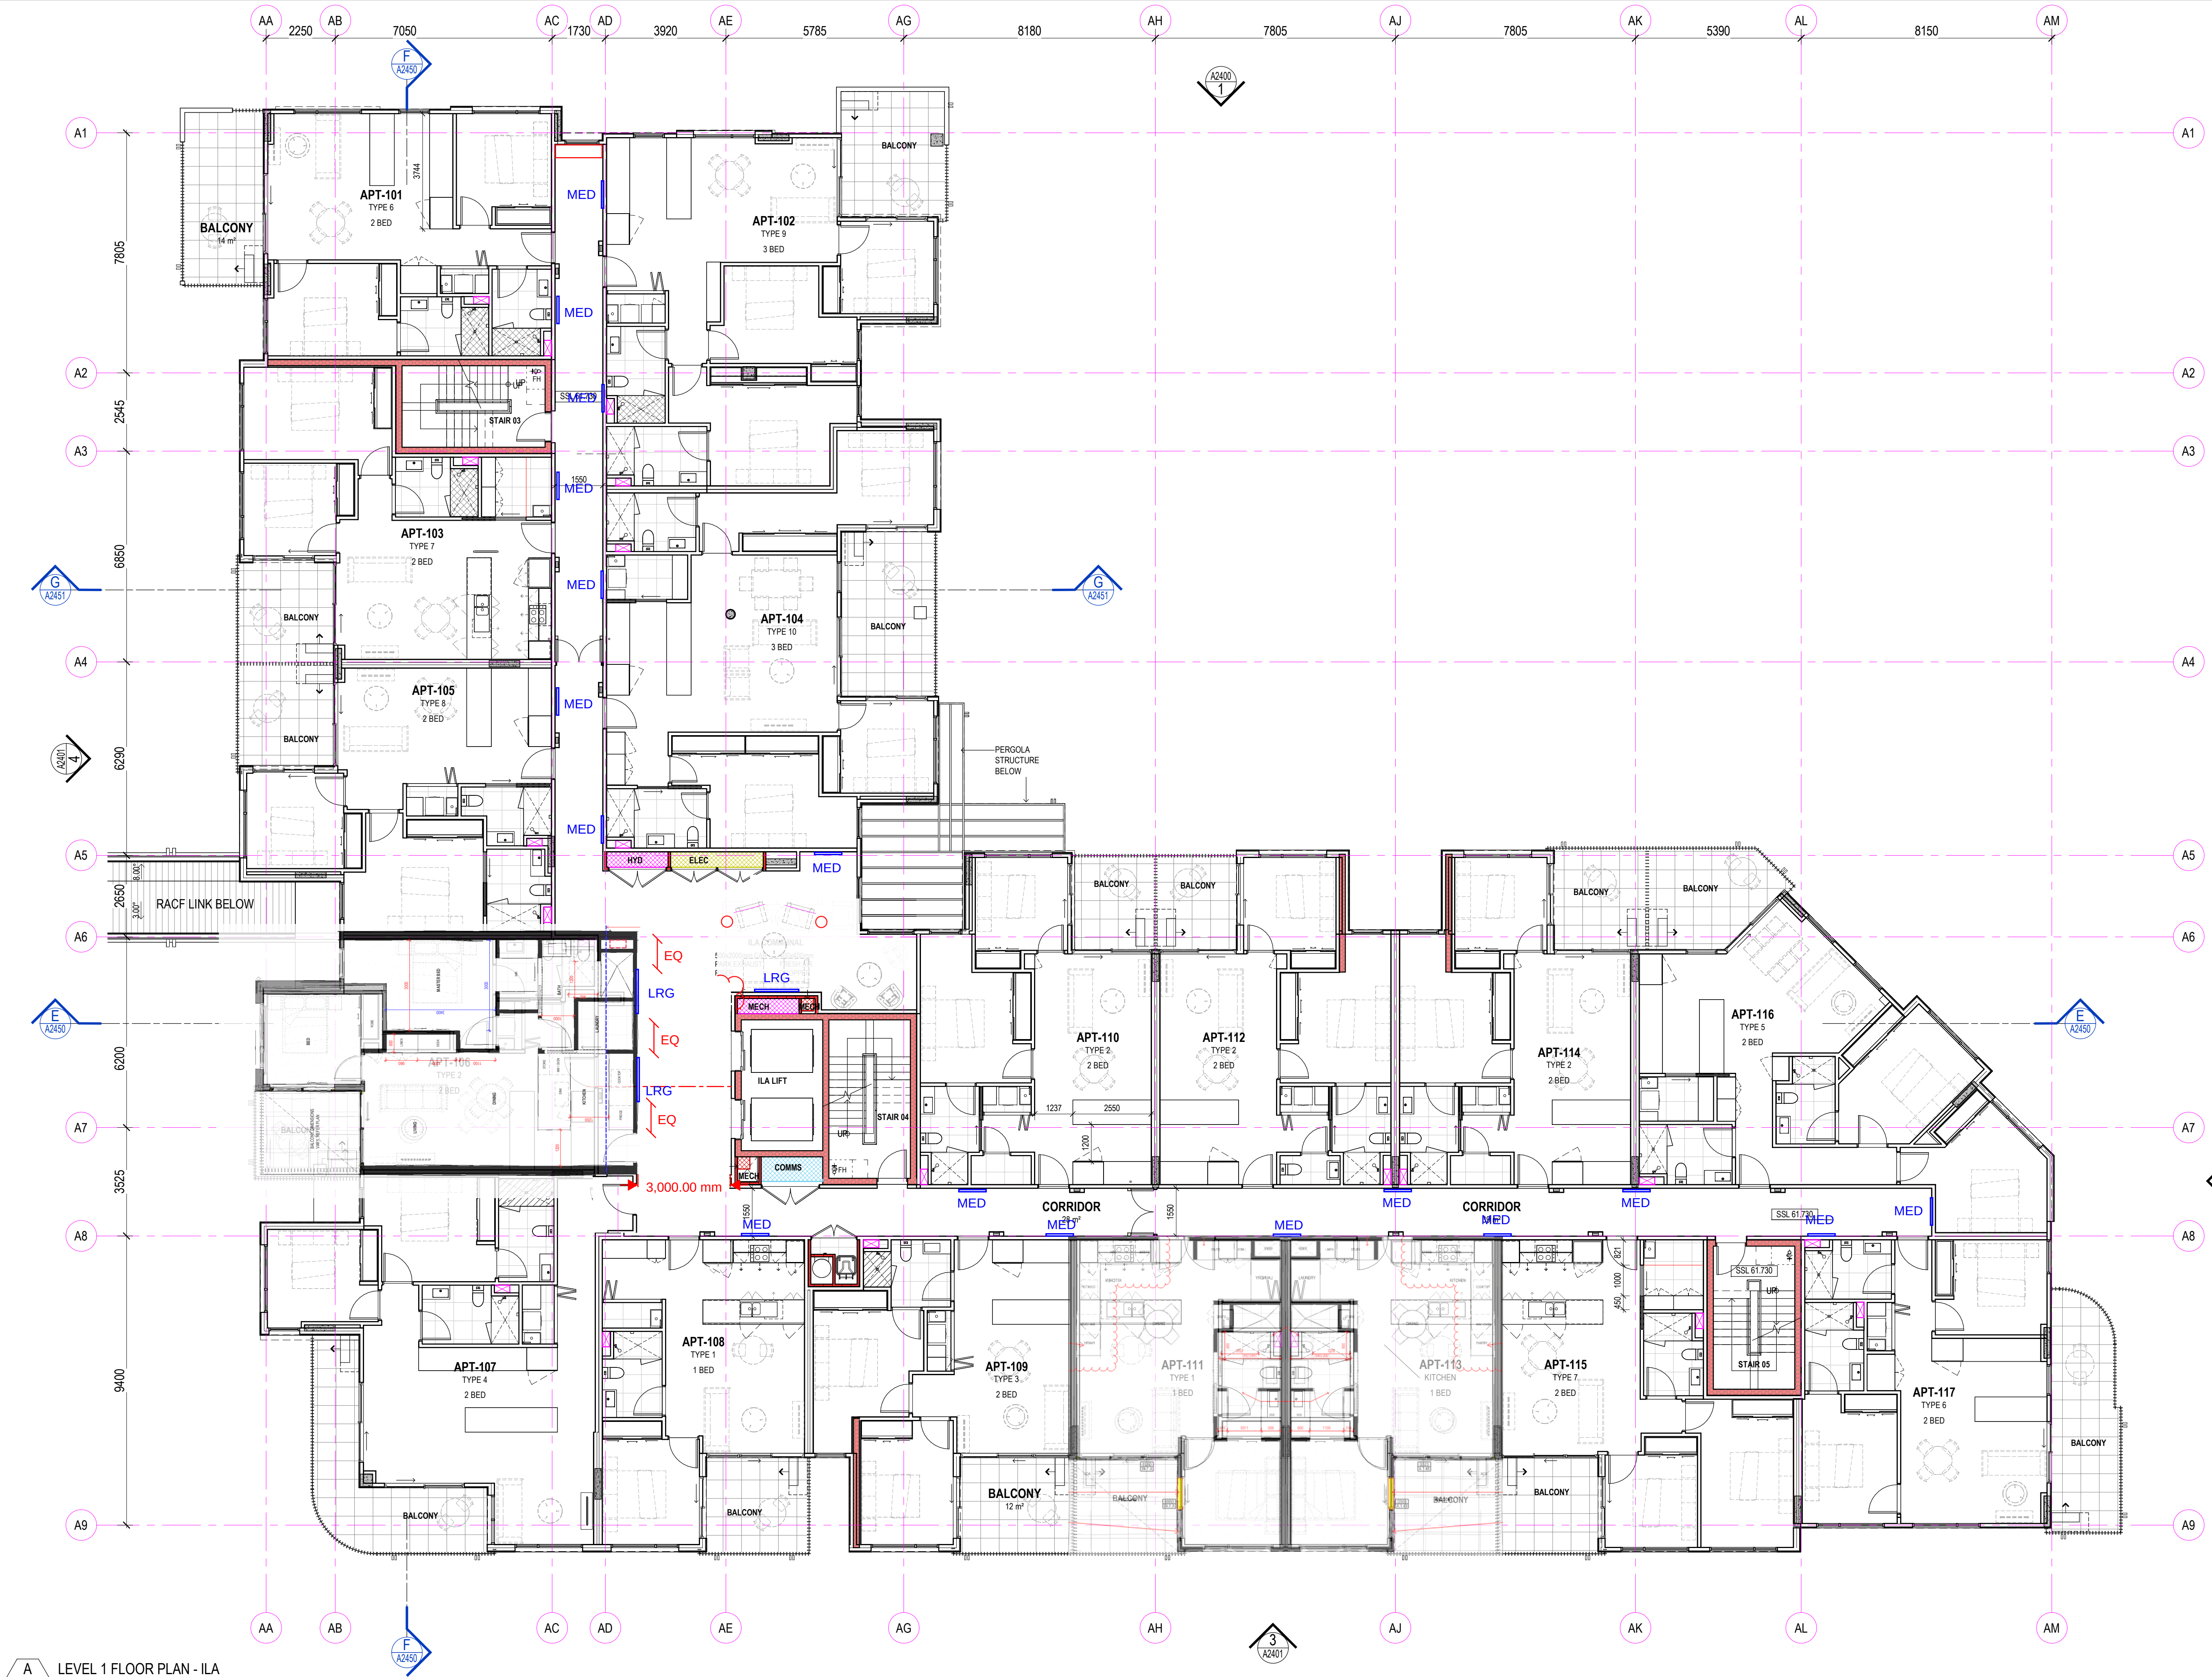

A LEVEL 1 FLOOR PLAN - ILA
Scale 1:100

Revision/Issue	Date
P4 RACF & ILA WIP Consultant Coordination & Review	2025.06.24
P5 Preliminary GA Plan Issue for Co-ordination and Review	2025.07.29
P6 Updated GA Set	2025.08.21

Clarke
Hopkins
Clarke

ClarkeHopkinsClarke
Melbourne
L9, Melbourne Connect
700 Swanston Street
Carlton Victoria 3053
Telephone (03) 9419 4340
Email studio@chc.com.au
www.chc.com.au

Sydney
3/78 Campbell Street
Sunny Hills NSW 2010
Telephone (02) 9221 9200
Email studio@chc.com.au
www.chc.com.au

Scale	1:100 @ A1
Date	01/03/2024
Drawn	TMAC
Architect	EL



Project
Summerset Oakleigh
52 Golf Road, Oakleigh South, VIC

Drawing
General Arrangement Plan - First Floor

Drawing No.
230185/A2201

PRELIMINARY

General Notes

BUILDER TO VIEW THE SITE DURING THE TENDER PERIOD TO SATISFY THEMSELVES OF THE LATENT SITE CONDITIONS AND FULL EXTENT OF WORK AS REQUIRED TO ALLOW FOR THE COMPLETION OF ALL WORKS AS DETAILED IN ALL DOCUMENTATION.


ALL DOCUMENTS ARE TO BE REVIEWED IN CONJUNCTION WITH RELEVANT CONSULTANTS DRAWINGS AND SPECIFICATIONS.

CONTRACTOR TO USE 92MM STUD FRAMING UNLESS NOTED OTHERWISE. ALL WALL LININGS TO EXTEND TO 150mm ABOVE THE CEILING UNLESS NOTED OTHERWISE. ALL

ALLOW FOR WALL STRENGTHENING BEHIND WALL MOUNTED FIXTURES AND FITTINGS INCLUDING BUT NOT LIMITED TO GRABRAILS, HANDRAILS, EQUIPMENT HOOKS, DRUG SAFES.

Legend - General

- WALL TYPE
- RELATIVE LEVEL
- PROPOSED FINISH LEVEL
- TRAVEL PATH

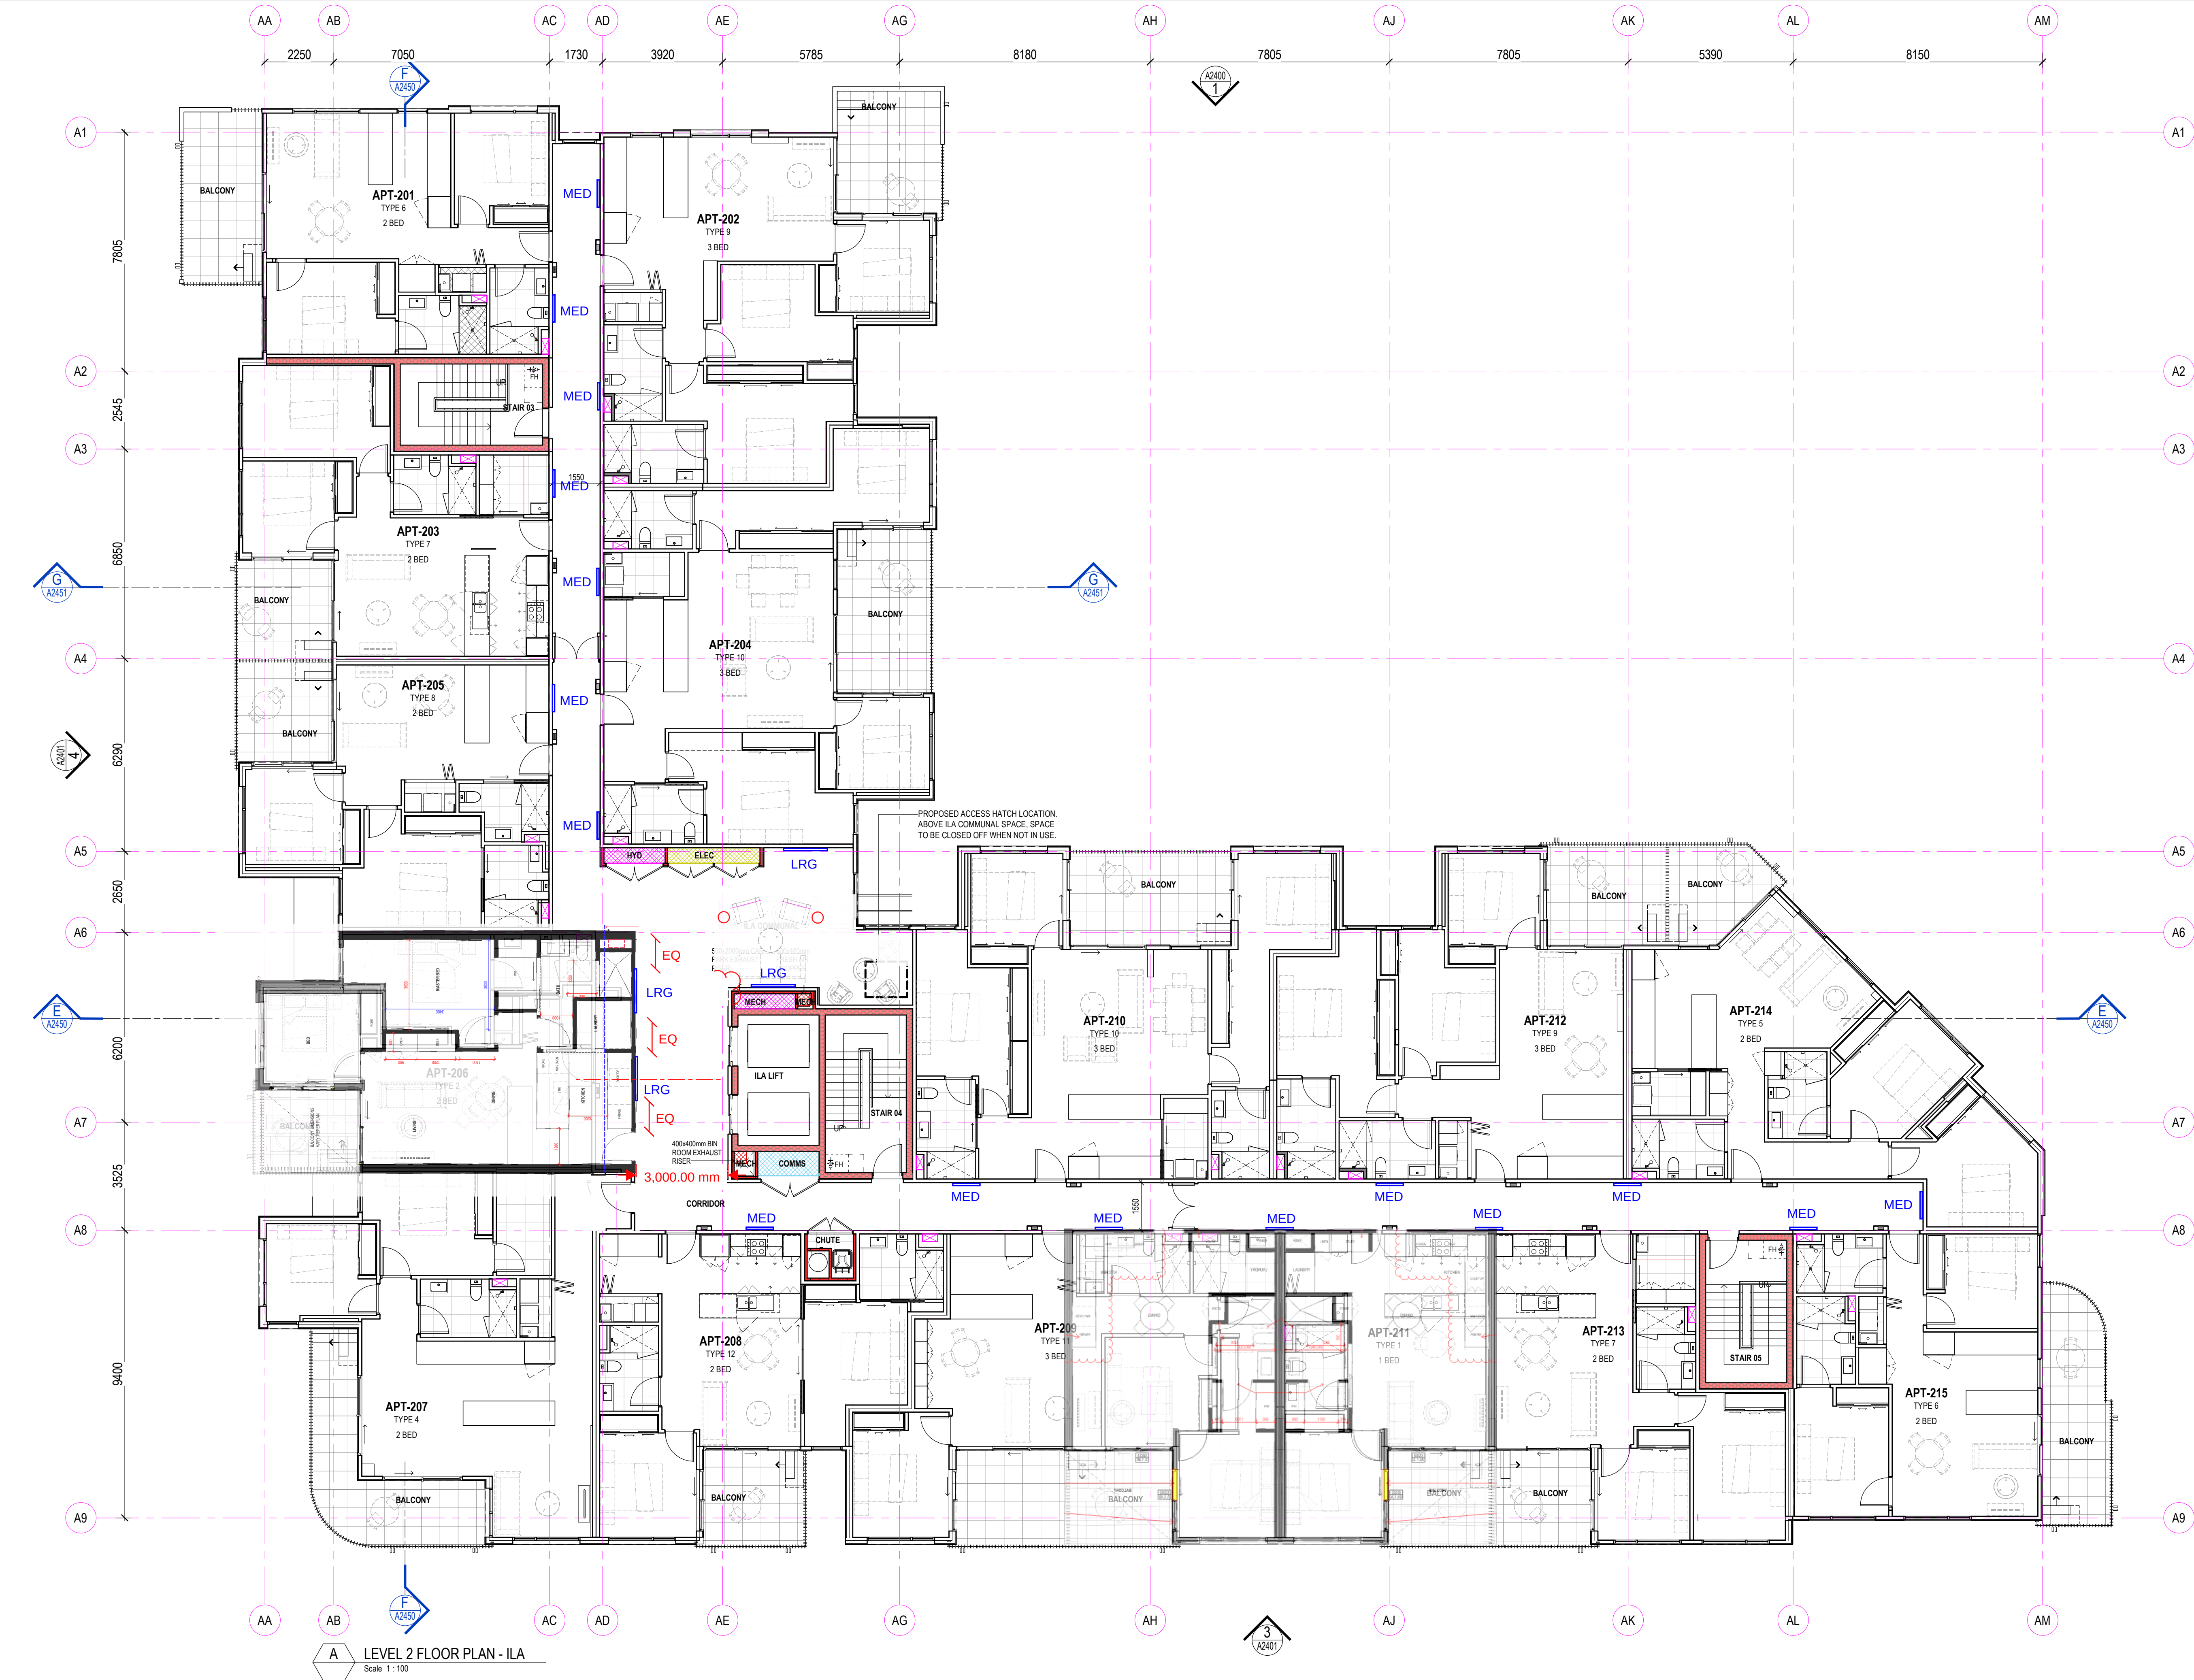

Revision/Issue

P4 RACF & ILA WIP Consultant Coordination & Review

Date

2025.06.24

Revision/Issue

P5 Preliminary GA Plan Issue for Co-ordination and Review

Date

2025.07.29

Revision/Issue

P6 Updated GA Set

Date

2025.08.21

ClarkeHopkinsClarke

Melbourne

700 Melbourne Connect

700 Swanston Street

Carlton Victoria 3053

Telephone (03) 9419 4340

Email studio@chc.com.au

www.chc.com.au

Sydney

3/78 Campbell Street

Sunny Hills NSW 2010

Telephone (02) 9221 9200

Email studio@chc.com.au

www.chc.com.au

Scale

1 : 100 @ A1

Date

01/03/2024

Drawn

Architect

Project

Summerset Oakleigh

52 Golf Road, Oakleigh South, VIC

Drawing

General Arrangement Plan- Second Floor

Drawing No.

230185/A2202

P6

PRELIMINARY