




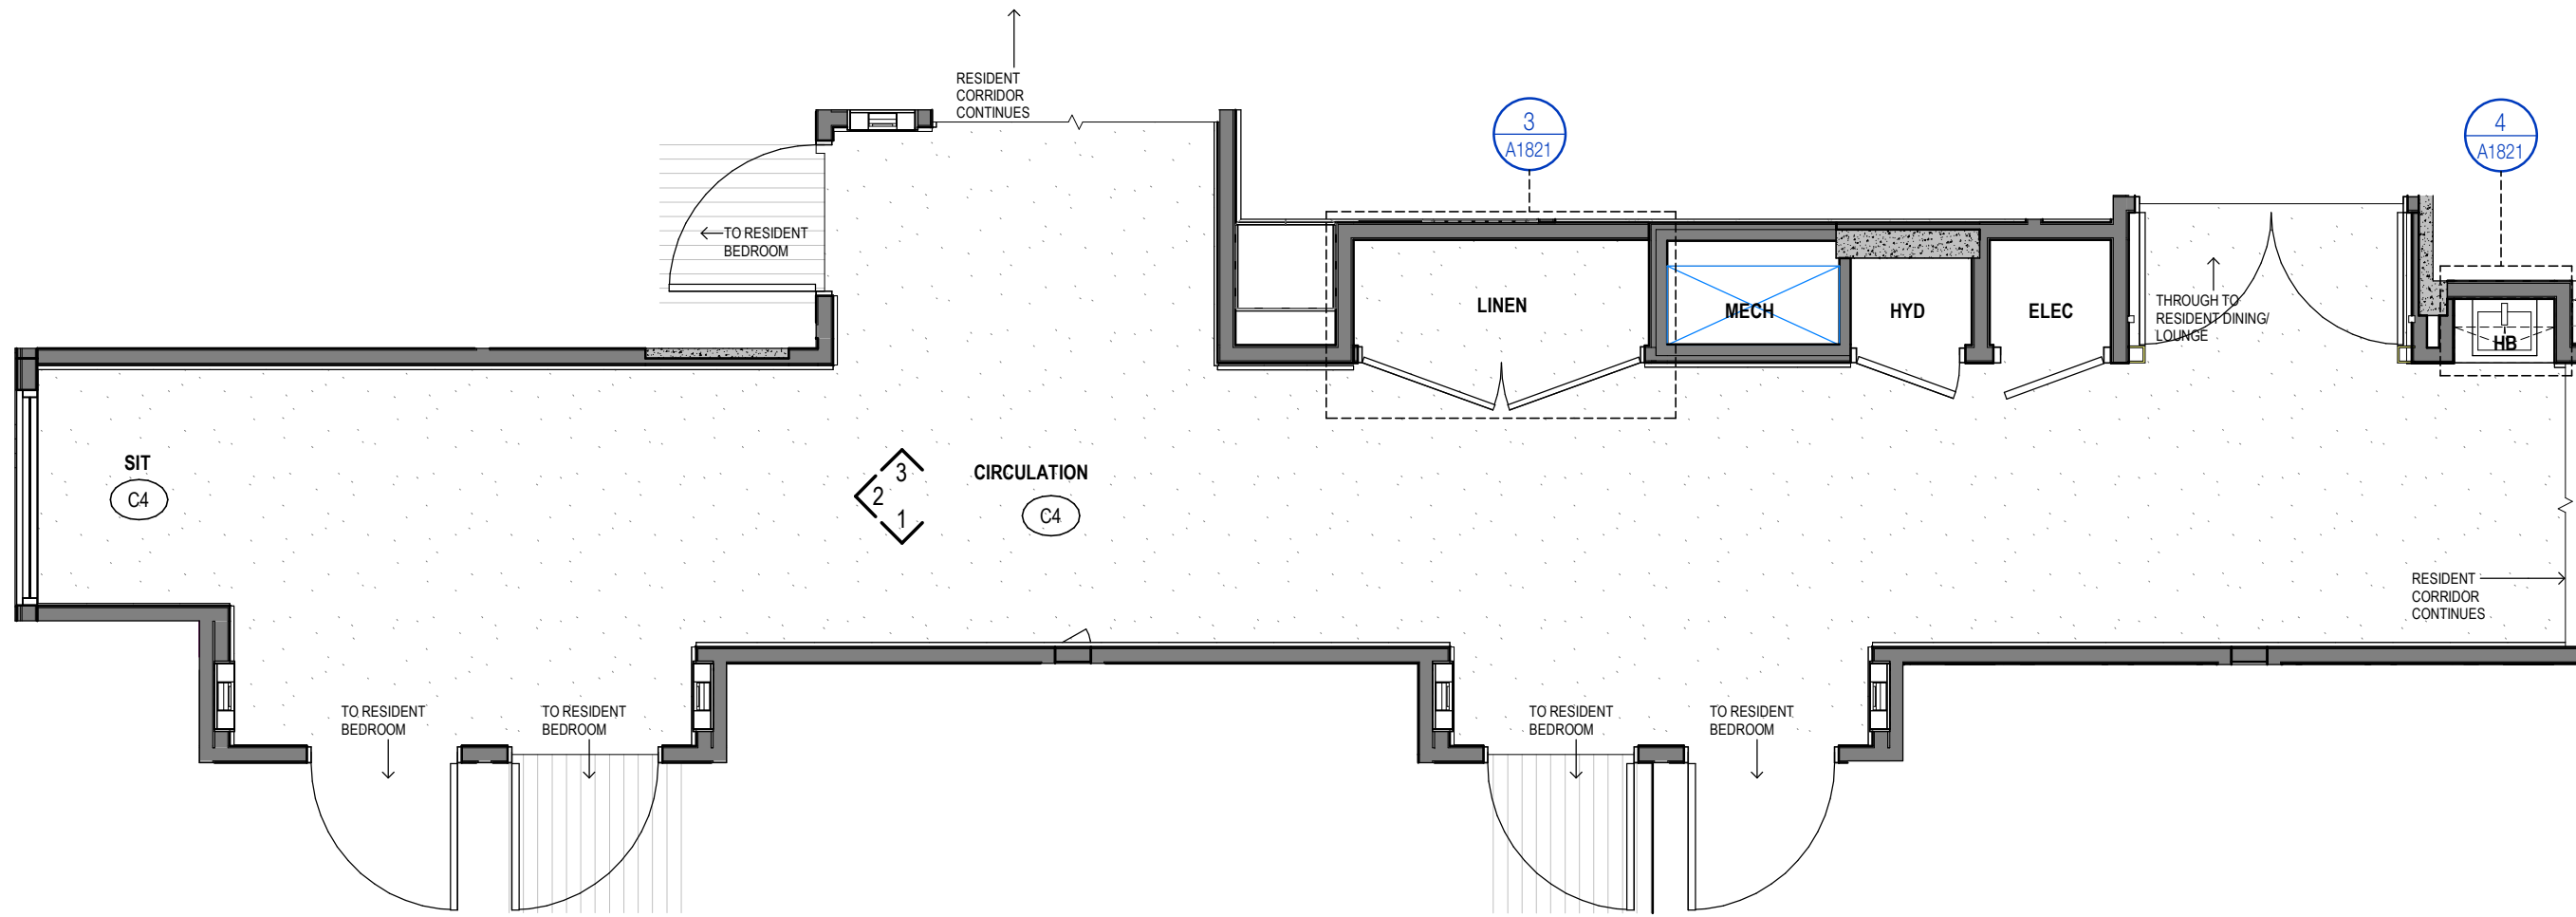


1 TYPICAL RACF CORRIDOR - INSTANCE 1
Scale 1 : 50

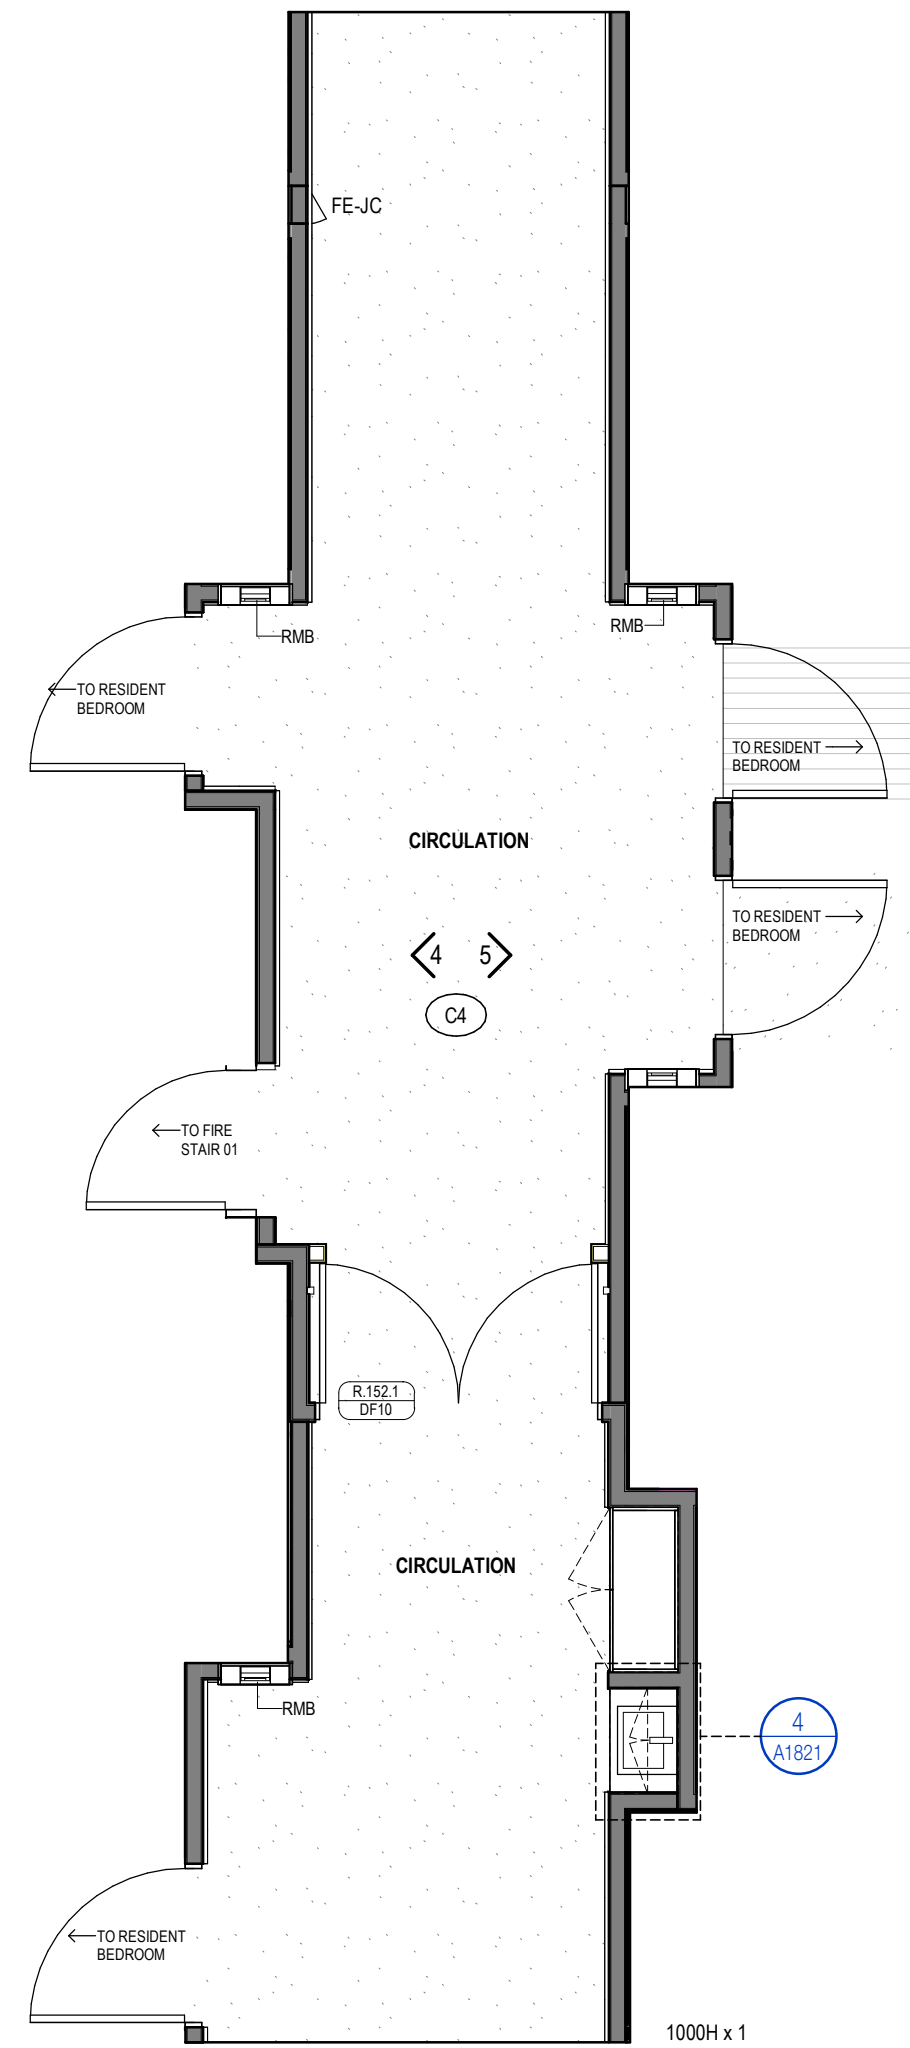


2 TYPICAL RACF CORRIDOR - INSTANCE 2
Scale 1 : 50

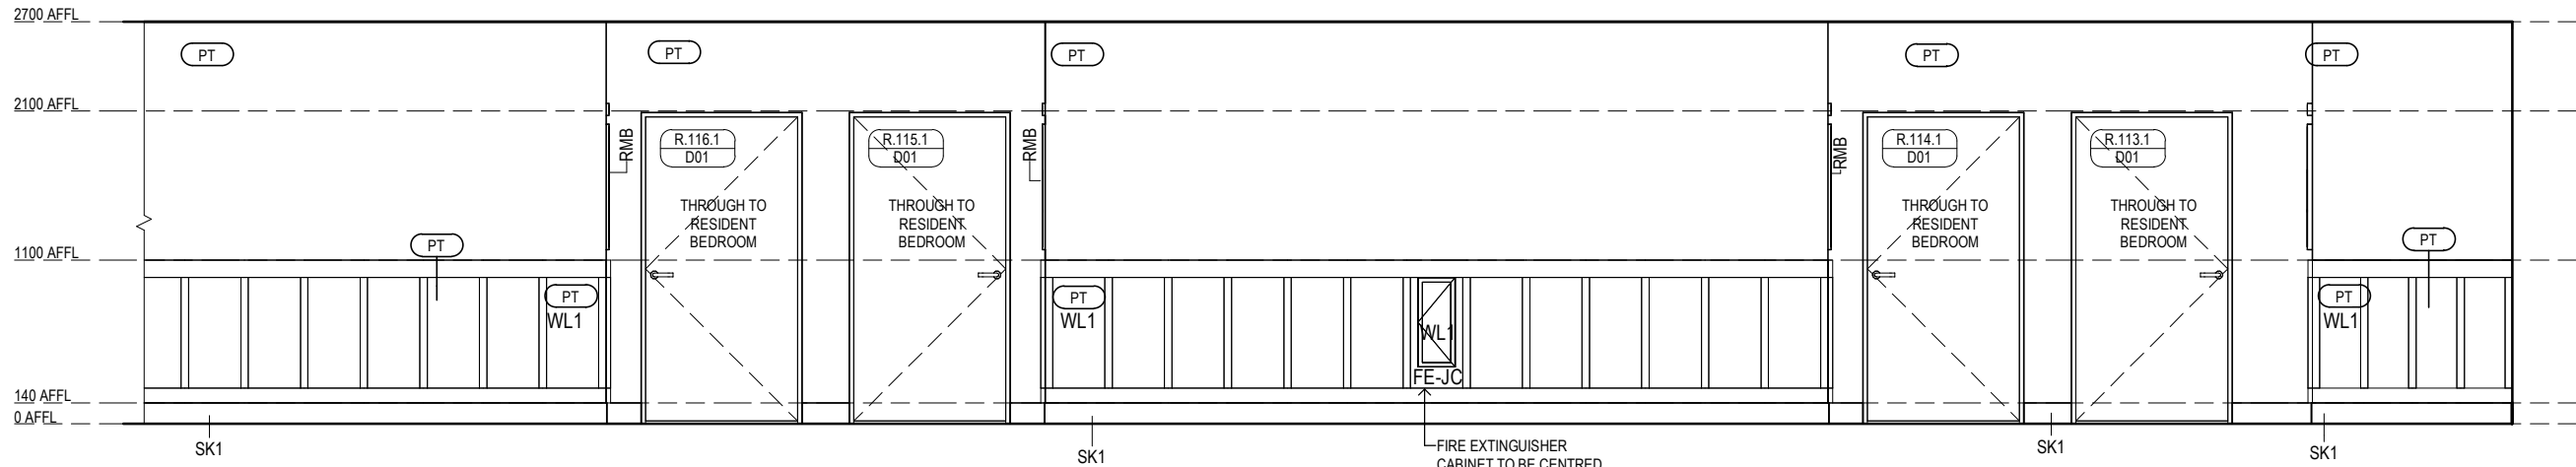


TYPICAL RESIDENT CORRIDOR
ELEVATION 1
Scale 1 : 50

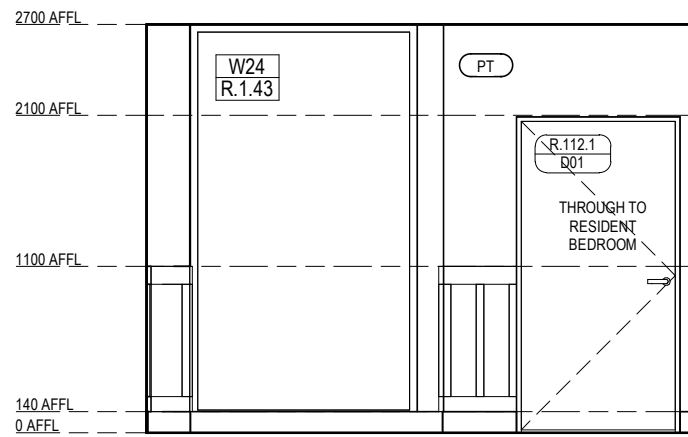


TYPICAL RESIDENT CORRIDOR
ELEVATION 2
Scale 1 : 50

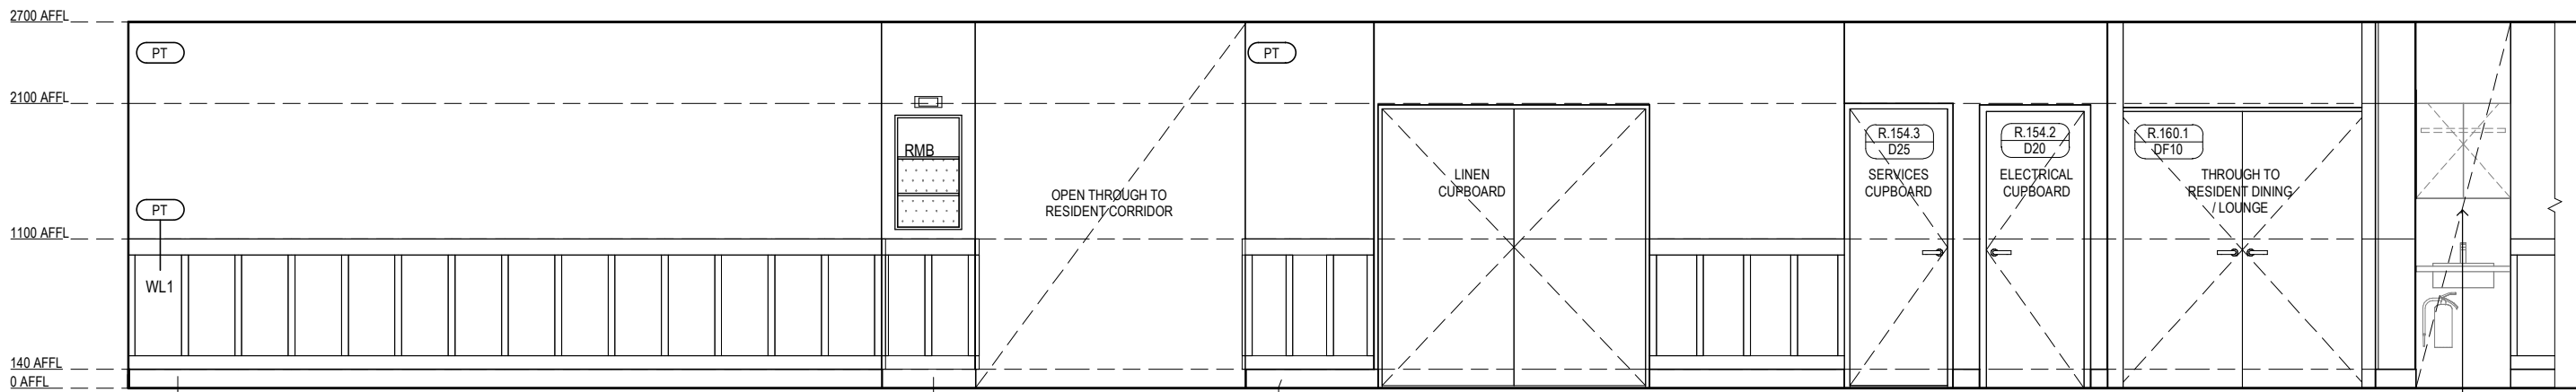

TYPICAL RESIDENT CORRIDOR
ELEVATION 3
Scale 1 : 50

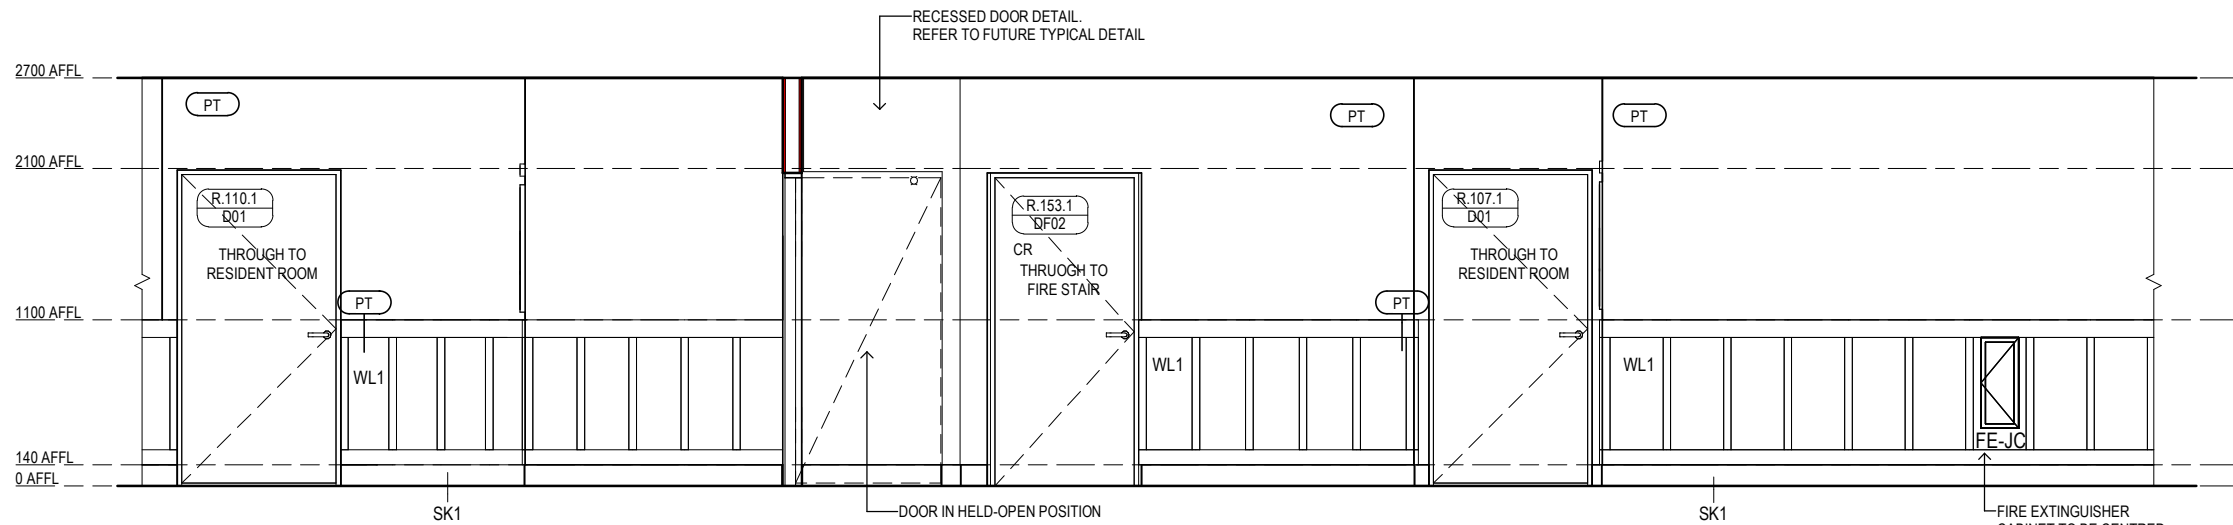

TYPICAL RESIDENT CORRIDOR
ELEVATION 4
Scale 1 : 50

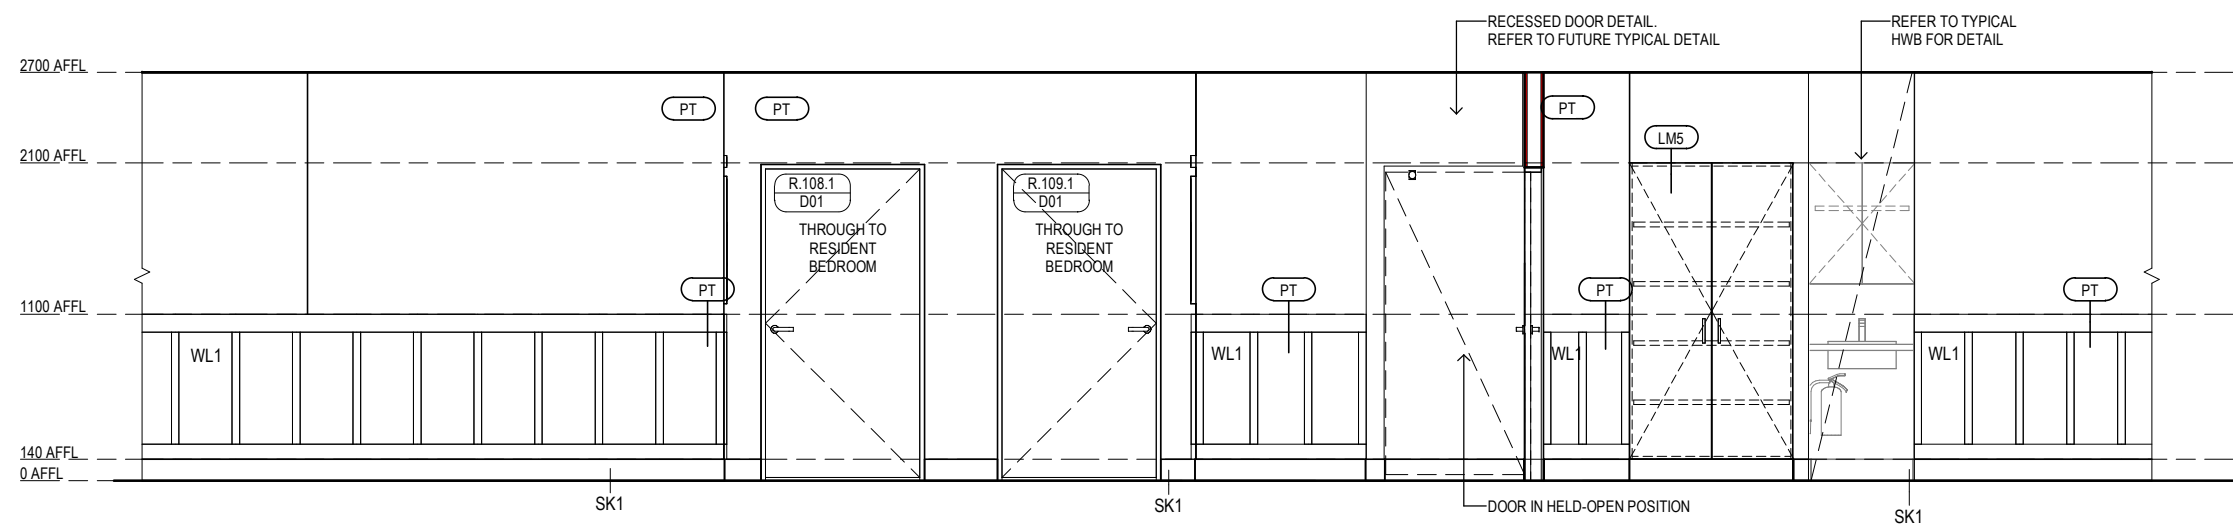

TYPICAL RESIDENT CORRIDOR
ELEVATION 5
Scale 1 : 50

Legend - Internal Elevations

DRAWINGS TO BE READ IN CONJUNCTION WITH ARCHITECTURAL SPECIFICATION & MATERIALS, PRODUCTS & FINISHES SCHEDULE.

PT# PAINT FINISH TO ALL WALLS WITHIN NEW & AFFECTED ROOMS/ AREAS UNLESS OTHERWISE SHOWN

- CSE CONCRETE SEALER
- DPR DOOR PROTECTION
- GD GRAPHIC FILM
- LM LAMINATE
- MI MIRROR
- PBD PINBOARD
- PT PAINT FINISH
- REN RENDER FINISH
- SB SPLASHBACK
- ST STONE
- WB WHITEBOARD
- WP WALL PROTECTION
- WT WALL TILE
- WV WALL VINYL
- UPH UPHOLSTERY

NOTES:
1. LAMINATE CARCASS FOR ALL VISIBLE OPEN SHELVING, UNLESS OTHERWISE NOTED
2. MELAMINE TO ALL INTERNAL CARCASS OF JOINERY, UNLESS OTHERWISE NOTED.

--- PROVIDE NOGGINGS FOR FUTURE USE

Legend - Floor Finishes

- C CARPET
- CO CONCRETE
- E EPOXY FINISH
- L LINOLEUM
- M MATTING
- FU PAVING UNIT - TBC WITH LANDSCAPE
- R RUBBER FLOORING
- T TILING
- TF TIMBER FLOORING
- V VINYL
- LVT LUXURY VINYL TILE PLANK

--- PROTECTION RAILS OR CRASH RAILS - REFER TO MATERIAL SCHEDULE FOR DETAILS

--- WL1- REFER TO MATERIAL SCHEDULE FOR DETAILS

--- WL2- REFER TO MATERIAL SCHEDULE FOR DETAILS

NOTE:
FALLS TO ALL FLOOR WASTES IN ACCORDANCE WITH AS 3740.

Keynote Legend

- FE-JC FIRE EXTINGUISHER IN JOINERY CUPBOARD
- RMB RESIDENT MEMORY BOX - JOINERY
- SK1 SKIRTING - TYPE 1
- WL1 WALL PANELING - TYPE 1



FOR CONSTRUCTION

Revision/Issue	Date
P1 Preliminary Issue	2025.09.01
P2 ISSUE FOR CONTRACT	2025.10.10
C1 ISSUE FOR CONSTRUCTION - INTERIORS	2026.03.30

Clarke
Hopkins
Clarke

ClarkeHopkinsClarke

Melbourne | Wurundjeri
L3, Melbourne Connect
700 Swanston Street
Carlton VIC 3063
Telephone (03) 9419 4340
Email studio@chc.com.au
www.chc.com.au

Sydney | Gadigal Country
Suite 3, Ground Floor
91 Campbell Street
Surry Hills NSW 2010
Telephone (02) 9221 9200
Email studio@chc.com.au
www.chc.com.au

Scale	As indicated @ A1
Date	01/03/2024
Drawn	EL
Architect	EL

Project
Summerset Oakleigh
52 Golf Road, Oakleigh South, VIC

Drawing
Internal Elevations - RACF Typical Corridor

Drawing No.
230185/A1818
C1

General Notes

BUILDER TO VIEW THE SITE DURING THE TENDER PERIOD TO SATISFY THEMSELVES OF THE LATENT SITE CONDITIONS AND FULL EXTENT OF WORK AS REQUIRED TO ALLOW FOR THE COMPLETION OF ALL WORKS AS DETAILED IN ALL DOCUMENTATION.

ALL DOCUMENTS ARE TO BE REVIEWED IN CONJUNCTION WITH RELEVANT CONSULTANTS DRAWINGS AND SPECIFICATIONS.

CONTRACTOR TO USE 92MM METAL STUD FRAMING UNLESS NOTED OTHERWISE. REFER TO ACOUSTIC REPORT AND FIRE/SMOKE COMPARTMENT PLANS FOR WALLS THAT EXTEND TO UNDERSIDE OF SLAB AND ROOF SHEETING.

ALLOW FOR WALL STRENGTHENING BEHIND WALL MOUNTED FIXTURES AND FITTINGS INCLUDING BUT NOT LIMITED TO GRABRAILS, HANDRAILS, EQUIPMENT HOOKS, DRUG SAFES.

ALL FIRE, SMOKE, ACOUSTIC WALLS, CORRIDOR WALLS TO BEDROOMS AND APARTMENTS ARE FULL HEIGHT TO UNDERSIDE OF SLAB OR SHEET METAL ROOF.

IMPACT RESISTANT PLASTERBOARD TO BE INSTALLED FROM 0 AFFL TO 1200 AFFL (TYPICALLY TO ALL STORES AND CORRIDORS)
ONLY CORRIDORS WITHOUT DADO PANELS REQUIRE IMPACT RESISTANT PLASTERBOARD


ALLOW FOR FURRING CHANNELS AND LINING TO ALL CONCRETE COLUMNS. LINING TO MATCH WITH LINING OF ASSOCIATED ROOM.

Legend - General

	WALL TYPE - REFER TO WALL SET-OUT PLANS & WALL TYPES SHEET FOR DETAILS
	RELATIVE LEVEL
	PROPOSED FINISH LEVEL

ABBREVIATIONS

BAL1	BALUSTRADE - TYPE 1
BAL2	BALUSTRADE - TYPE 2
BAL3	BALUSTRADE - TYPE 3
COL	COLUMN
COLS	STEEL COLUMN
DPI	DOWNPIPE - TYPE 1
EG1	EAVES GUTTER - TYPE 1
FE	FIRE EXTINGUISHER
FE-JC	FIRE EXTINGUISHER IN JOINERY CUPBOARD
FH	FIRE HYDRANT
FLA	FLASHING
FW3	FLOOR WASTE - TYPE 3
FW4	FLOOR WASTE - TYPE 4
RHYD	HYDRAULIC RISER

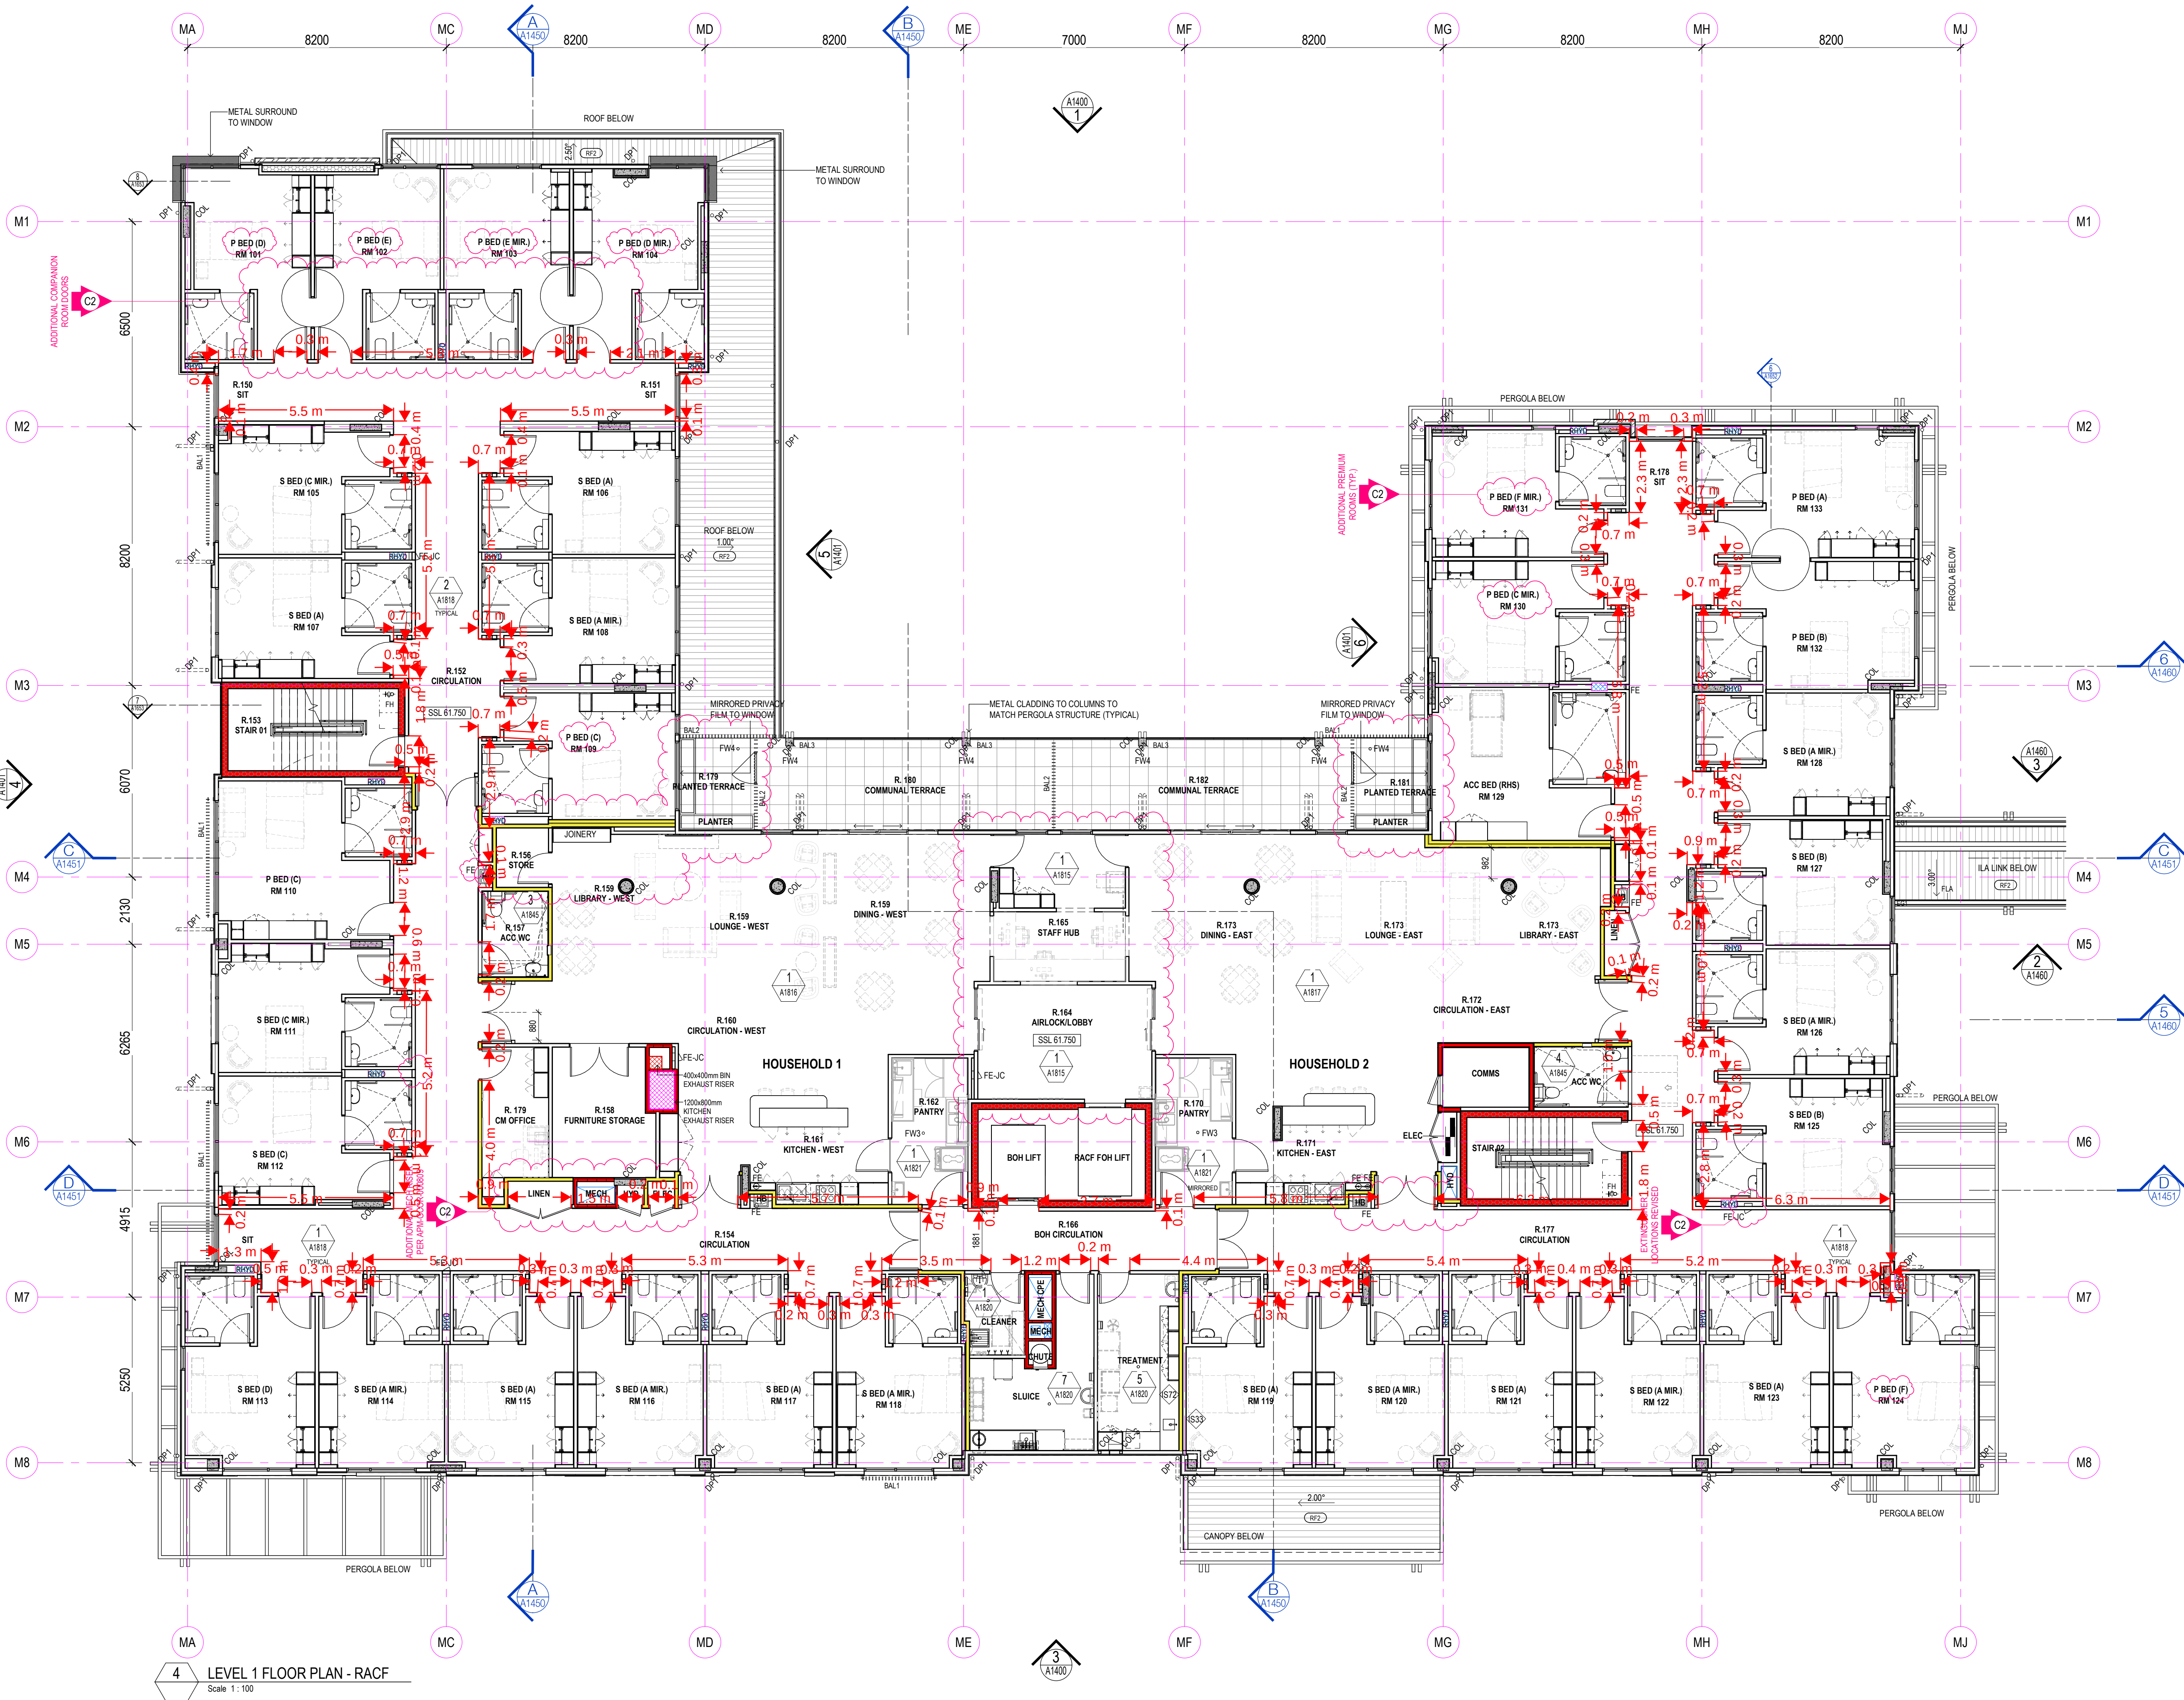

Revision/Issue	Date
P7 Consolidated Set-to-date / SMG Comments	2025.08.15
P8 Tender Pack - Doors and Windows	2025.09.15
P9 ISSUE FOR CONTRACT	2025.10.10
C1 ISSUE FOR CONSTRUCTION	2025.12.19
C2 ISSUE FOR CONSTRUCTION	2026.03.24

Clarke
Hopkins
Clarke

ClarkeHopkinsClarke
Melbourne | Wurundjeri
Melbourne Connect
700 Swanston Street
Carlton VIC 3063
Telephone (03) 9419 4340
Email studio@chc.com.au
www.chc.com.au

Sydney | Gadigal Country
Suite 3, Ground Floor
91 Campbell Street
Surry Hills NSW 2010
Telephone (02) 9221 9200
Email studio@chc.com.au
www.chc.com.au

Scale	1:100 @ A1
Date	01/03/2024
Drawn	TM/NS
Architect	EL



Project
Summerset Oakleigh
52 Golf Road, Oakleigh South, VIC

Drawing
General Arrangement Plan - First Floor

Drawing No.
230185/A1203

C2

FOR CONSTRUCTION

General Notes

BUILDER TO VIEW THE SITE DURING THE TENDER PERIOD TO SATISFY THEMSELVES OF THE LATENT SITE CONDITIONS AND FULL EXTENT OF WORK AS REQUIRED TO ALLOW FOR THE COMPLETION OF ALL WORKS AS DETAILED IN ALL DOCUMENTATION.

ALL DOCUMENTS ARE TO BE REVIEWED IN CONJUNCTION WITH RELEVANT CONSULTANTS DRAWINGS AND SPECIFICATIONS.

CONTRACTOR TO USE 92MM METAL STUD FRAMING UNLESS NOTED OTHERWISE. REFER TO ACOUSTIC REPORT AND FIRE/SMOKE COMPARTMENT PLANS FOR WALLS THAT EXTEND TO UNDERSIDE OF SLAB AND ROOF SHEETING.

ALLOW FOR WALL STRENGTHENING BEHIND WALL MOUNTED FIXTURES AND FITTINGS INCLUDING BUT NOT LIMITED TO GRABRAILS, HANDRAILS, EQUIPMENT HOOKS, DRUG SAFES.

ALL FIRE, SMOKE, ACOUSTIC WALLS, CORRIDOR WALLS TO BEDROOMS AND APARTMENTS ARE FULL HEIGHT TO UNDERSIDE OF SLAB OR SHEET METAL ROOF.

IMPACT RESISTANT PLASTERBOARD TO BE INSTALLED FROM 0 AFFL TO 1200 AFFL (TYPICALLY TO ALL STORES AND CORRIDORS)
ONLY CORRIDORS WITHOUT DADO PANELS REQUIRE IMPACT RESISTANT PLASTERBOARD


ALLOW FOR FURRING CHANNELS AND LINING TO ALL CONCRETE COLUMNS. LINING TO MATCH WITH LINING OF ASSOCIATED ROOM.

Legend - General

	WALL TYPE - REFER TO WALL SET-OUT PLANS & WALL TYPES SHEET FOR DETAILS
	RELATIVE LEVEL
	PROPOSED FINISH LEVEL

ABBREVIATIONS

BAL1	BALUSTRADE - TYPE 1
BAL2	BALUSTRADE - TYPE 2
BAL3	BALUSTRADE - TYPE 3
COL	COLUMN
COL-S	STEEL COLUMN
DP1	DOWNPIPE - TYPE 1
FE	FIRE EXTINGUISHER
FE-JC	FIRE EXTINGUISHER IN JOINERY CUPBOARD
FH	FIRE HYDRANT
FW3	FLOOR WASTE - TYPE 3
FW4	FLOOR WASTE - TYPE 4
RHYD	HYDRAULIC RISER

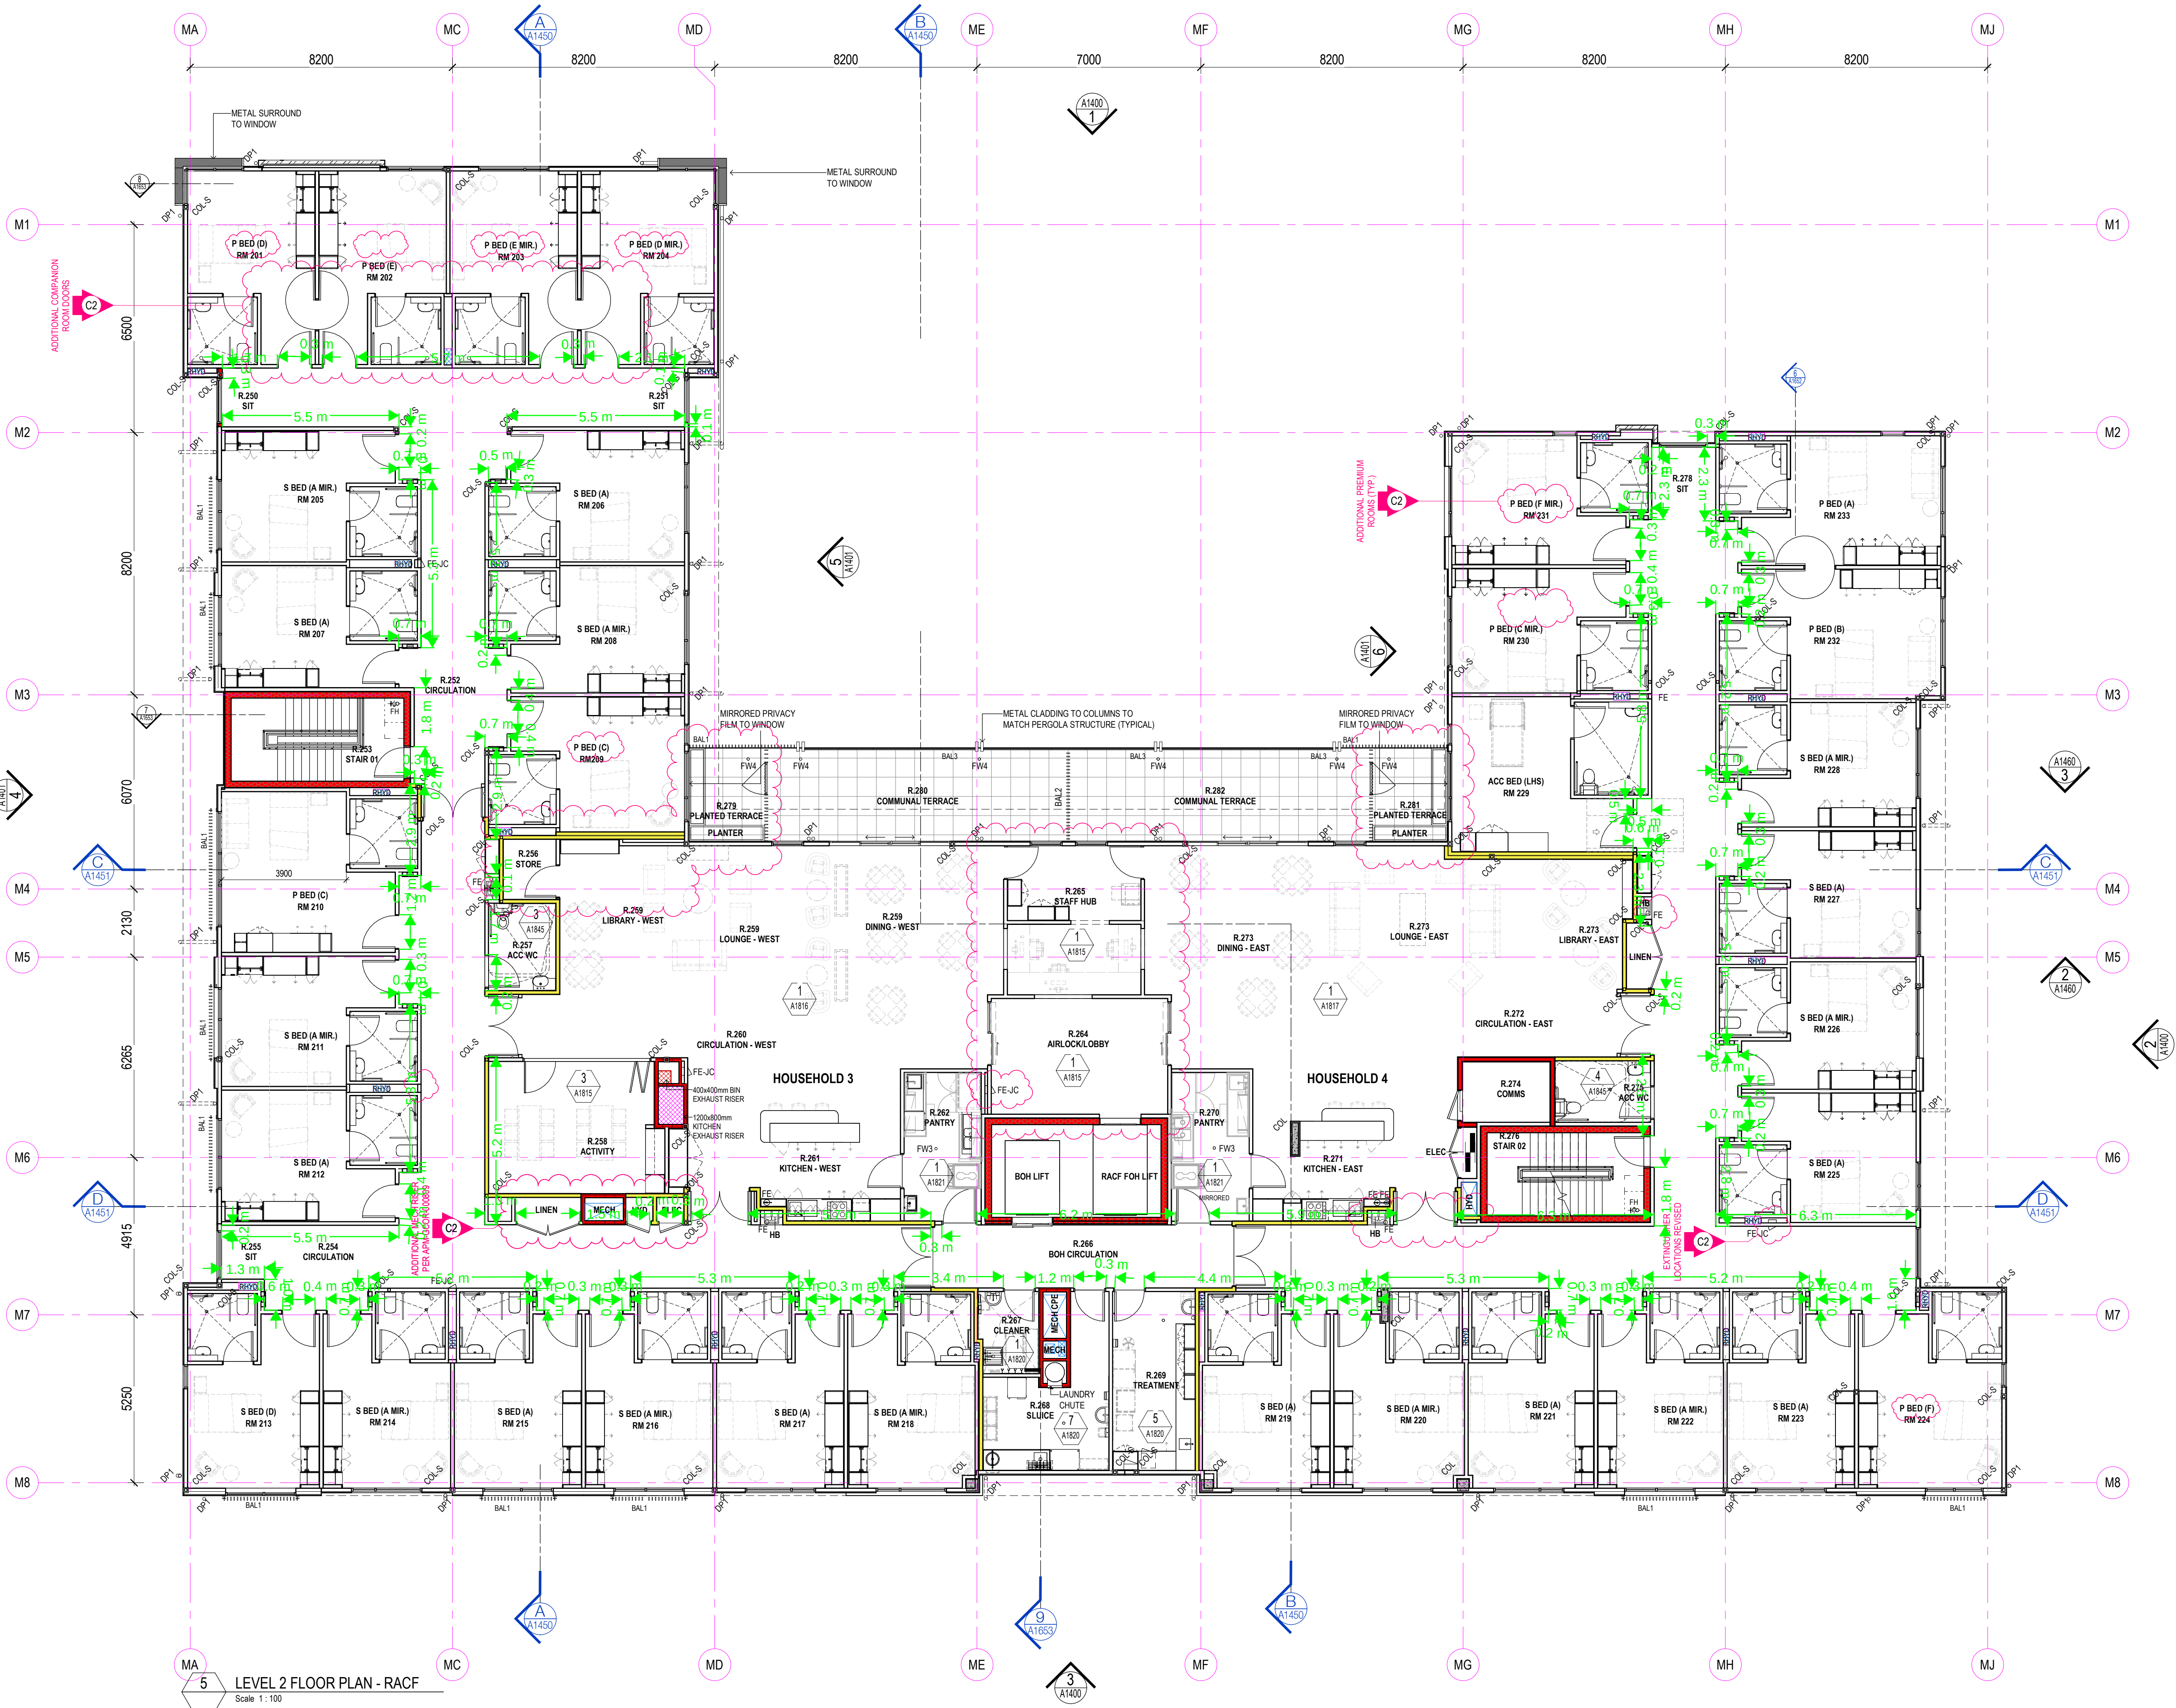

DRAWINGS TO BE READ IN CONJUNCTION WITH ARCHITECTURAL SPECIFICATION & MATERIALS, PRODUCTS & FINISHES SCHEDULE.

CSE	CONCRETE SEALER
DPR	DOOR PROTECTION
GD	GRAPHIC FILM
LM	LAMINATE
MI	MIRROR
PBD	PINBOARD
PT	PAINT FINISH
REN	RENDER FINISH
SB	SPLASHBACK
ST	STONE
WB	WHITEBOARD
WP	WALL PROTECTION
WT	WALL TILE
WV	WALL VINYL
UPH	UPHOLSTERY

— — — — PROVIDE NOGGINGS FOR FUTURE USE

C	CARPET
CO	CONCRETE
E	EPOXY FINISH
L	LINOLEUM
M	MATTING
PU	PAVING UNIT - TBC WITH LANDSCAPE
R	RUBBER FLOORING
T	TILING
TF	TIMBER FLOORING
V	VINYL
LVT	LUXURY VINYL TILE PLANK

WL1- REFER TO MATERIAL SCHEDULE FOR DETAIL

--- WL2 - REFER TO MATERIAL SCHEDULE FOR DETAIL

FALLS TO ALL FLOOR WASTES IN ACCORDANCE WITH AS 3740

TVWM	TV WALL MOUNTED BRACKET - GROUP 2
TVMB	TV WALL SCREEN 35 INCH - GROUP 3
AVC	AIR CONDITIONING - CONTROL
AVCU	AIR CONDITIONING UNIT
BJC	BUILDING - JOINERY TYPE
DATA	DATA
DO	DOOR STOP
DO1	SHEER CURTAINS
ESPT	ELECTRICITY - SINGLE
ESPD	ELECTRICITY - DOUBLE
ESPD2	ELECTRICITY - DOUBLE - LARGE PLATE
ESPD2	ELECTRICITY - DOUBLE - LARGE PLATE LIGHT - REFERR TO ELECTRICAL ENGINEER SPECIFICATION
FLZ	LIGHT SWITCH -
FLZ1	LIGHT SWITCH - LARGE PLATE
MD	MOTION DETECTOR
NC	NURSE CALL
PLH	PATIENT LIFTING HOIST
PS	PROTECTION RAIL
SK	SKIRTING
SMD	SMOKE DETECTOR
SPR	SPRINKLER
TV	TELEVISION COAXIAL OUTLET
V2	WALL LIGHT - TYPE 2
V3	WALL LIGHT - TYPE 3
W4	WIRELESS ACCESS POINT
WAP	WALL PANCELLING - TYPE A

230185/A1831

C2



This detailed floor plan shows the layout of the first floor. The overall dimensions are 1200 units wide by 1180 units deep. The plan includes a large living area on the left with a fireplace (A1846) and a large window (500H x 2). A central hallway (500H x 3) leads to a bedroom (500H x 2) and a bathroom (500H x 2). A large circular area (C5) is located in the center. A large circular feature (1550 TURN CIRCLE) is on the right. A porch (1000H x 2) is at the bottom left, and a large porch (1000H x 2) is at the bottom right. A staircase (1000H x 2) is located near the bottom right. The plan also shows a kitchen area (1000H x 2) and a dining area (1000H x 2). The overall layout is designed to be functional and aesthetically pleasing.

3 RACF PREMIUM ROOM TYPE A
Scale 1:50

NOTE: REFER SIMILAR ELEVATIONS TO PREMIUM BEDROOM TYPE D;
UNLESS NOTED OTHERWISE



NOTE: REFER SIMILAR ELEVATIONS TO **PREMIUM BEDROOM TYPE D**;
UNLESS NOTED OTHERWISE



2 RACF PREMIUM ROOM TYPE D
Scale 1 : 50



NOTE: REFER SIMILAR ELEVATIONS TO **PREMIUM BEDROOM TYPE D**;
UNLESS NOTED OTHERWISE





NOTE: REFER SIMILAR ELEVATIONS TO **PREMIUM BEDROOM TYPE D**;
UNLESS NOTED OTHERWISE

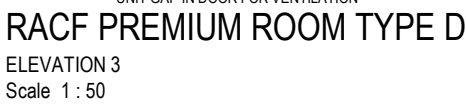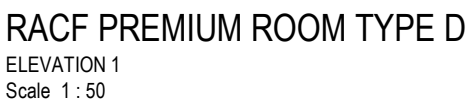

TRAC Level 2	RM203
--------------	-------

P BED (C): 4

NOTE: REFER SIMILAR ELEVATIONS TO PREMIUM BEDROOM TYPE D.
UNLESS NOTED OTHERWISE

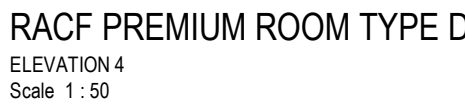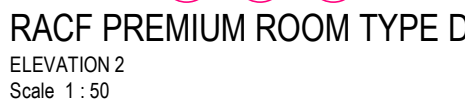

Clarke Hopkins exists

Melbourne | Wurundjeri
L9, Melbourne Connect
700 Swanston Street
Carlton VIC 3053
Telephone (03) 9419 4340
Email studio@chc.com.au
www.chc.com.au

Suite 3, Ground Floor
91 Campbell Street
Surry Hills NSW 2010
Telephone (02) 9221 9200
Email studio@chc.com.au
www.chc.com.au

Project
Summerset Oakleigh
52 Golf Road, Oakleigh South, VIC

Drawing

Internal Elevations - RACF Premium Bedrooms

Drawing No.

Legend - Internal Elevations

DRAWINGS TO BE READ IN CONJUNCTION WITH ARCHITECTURAL SPECIFICATION & MATERIALS, PRODUCTS & FINISHES SCHEDULE.

PT# PAINT FINISH TO ALL WALLS WITHIN NEW & AFFECTED ROOMS/ AREAS UNLESS OTHERWISE SHOWN

- CSE

CONCRETE SEALER
- DPR

DOOR PROTECTION
- GD

GRAPHIC FILM
- LM

LAMINATE
- MI

MIRROR
- PBD

PINBOARD
- PT

PAINT FINISH
- REN

RENDER FINISH
- SB

SPLASHBACK
- ST

STONE
- WB

WHITEBOARD
- WP

WALL PROTECTION
- WT

WALL TILE
- WV

WALL VINYL
- UPH

UPHOLSTERY

NOTES:
1. LAMINATE CARCASS FOR ALL VISIBLE OPEN SHELVING, UNLESS OTHERWISE NOTED
2. MELAMINE TO ALL INTERNAL CARCASS OF JOINERY, UNLESS OTHERWISE NOTED.

--- PROVIDE NOGGINGS FOR FUTURE USE

Legend - Floor Finishes

- C

CARPET
- CO

CONCRETE
- E

EPOXY FINISH
- L

LINOLEUM
- M

MATTING
- PU

PAVING UNIT - TBC WITH LANDSCAPE
- R

RUBBER FLOORING
- T

TILING
- TF

TIMBER FLOORING
- V

VINYL
- LVT

LUXURY VINYL TILE PLANK

--- PROTECTION RAILS OR CRASH RAILS - REFER TO MATERIAL SCHEDULE FOR DETAILS

--- WL1- REFER TO MATERIAL SCHEDULE FOR DETAILS

--- WL2 - REFER TO MATERIAL SCHEDULE FOR DETAILS

NOTE:
FALLS TO ALL FLOOR WASTES IN ACCORDANCE WITH AS 3740.

Keynote Legend

- 2VMB

TV WALL MOUNTED BRACKET - GROUP 2
- 3TV(M)

TELEVISION SCREEN 55 INCH - GROUP 3
- ACC

AIR CONDITIONING CONTROL
- ACU

AIR CONDITIONING UNIT
- B

BENCH - STANDARD
- BH-J

BULKHEAD - JOINERY TYPE
- CBD

CUPBOARD
- DATA

DATA OUTLET
- DR

DRAWER
- DST

DOOR STOP
- FA01

SHEER CURTAINS
- GPO1

POWER OUTLET - SINGLE
- GPO2

POWER OUTLET - DOUBLE
- GPO2L

POWER OUTLET - DOUBLE - LARGE PLATE
- HANGING RAIL - TYPE 2

HANGING RAIL - TYPE 2
- HR02

LIGHT FITTING - REFER TO ELECTRICAL ENGINEER SPECIFICATION
- LS

LIGHT SWITCH
- LS-L

LIGHT SWITCH - LARGE PLATE
- MD

MOTION DETECTOR
- M1

MIRROR - TYPE 1
- NC

NURSE CALL
- PLH

PATIENT LIFTING HOIST
- PRL

PROTECTION RAIL
- SH

SHELF
- SK

SKIRTING
- SMD

SMOKE DETECTOR
- SPR

SPRINKLER
- TV


TELEVISION COAXIAL OUTLET
- V1

WALL LIGHT - TYPE 1
- V3

WALL LIGHT - TYPE 3
- WAP

WIRELESS ACCESS POINT
- WL4


WALL PANELLING - TYPE 4

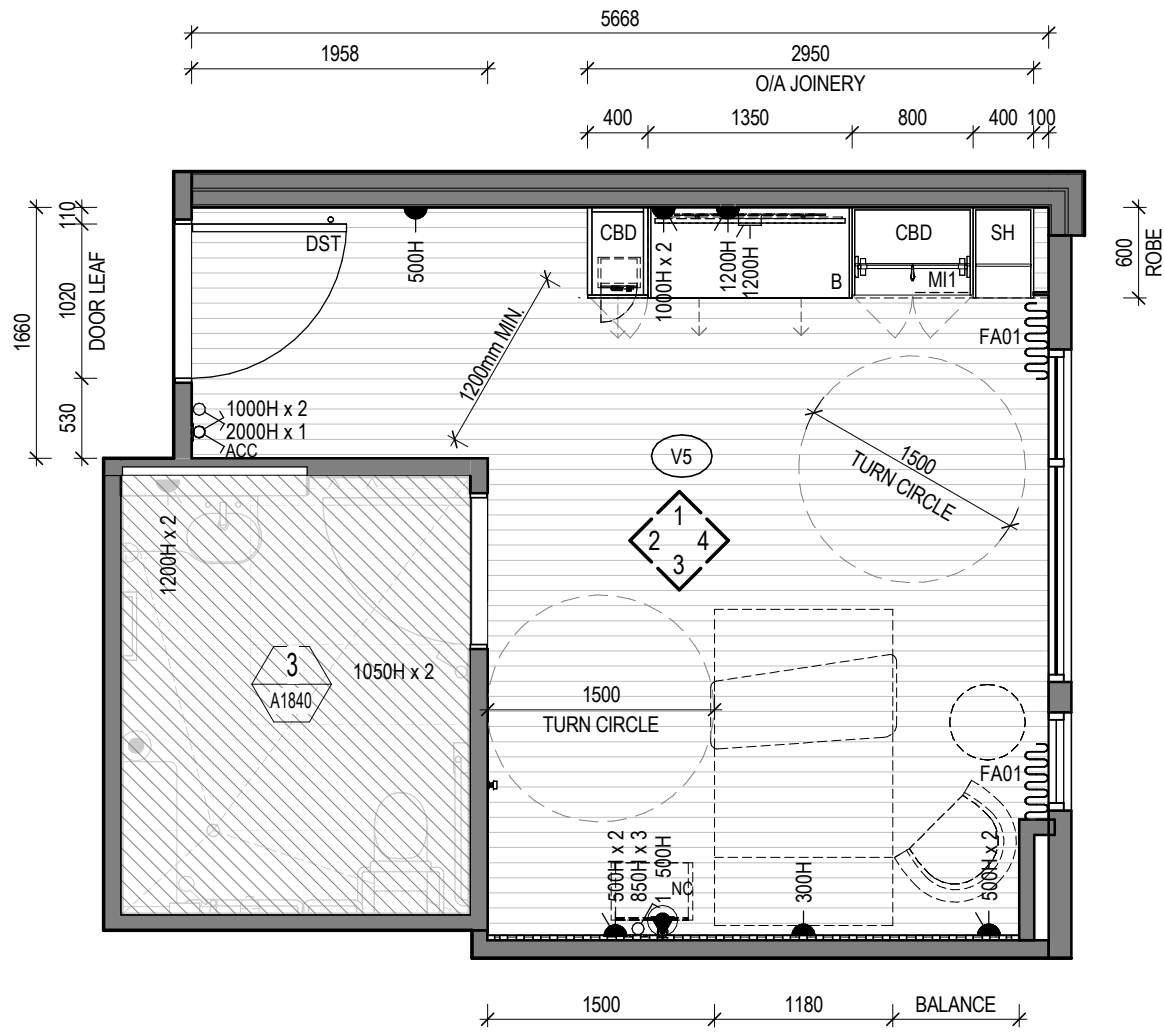

1 RACF ACCESSIBLE BEDROOM


Scale 1 : 50

Accessible Room Type Count	
Level	Room Number
RACF Level 2	RM 229
ACC BED (LHS): 1	
RACF Level 1	RM 129
ACC BED (RHS): 1	

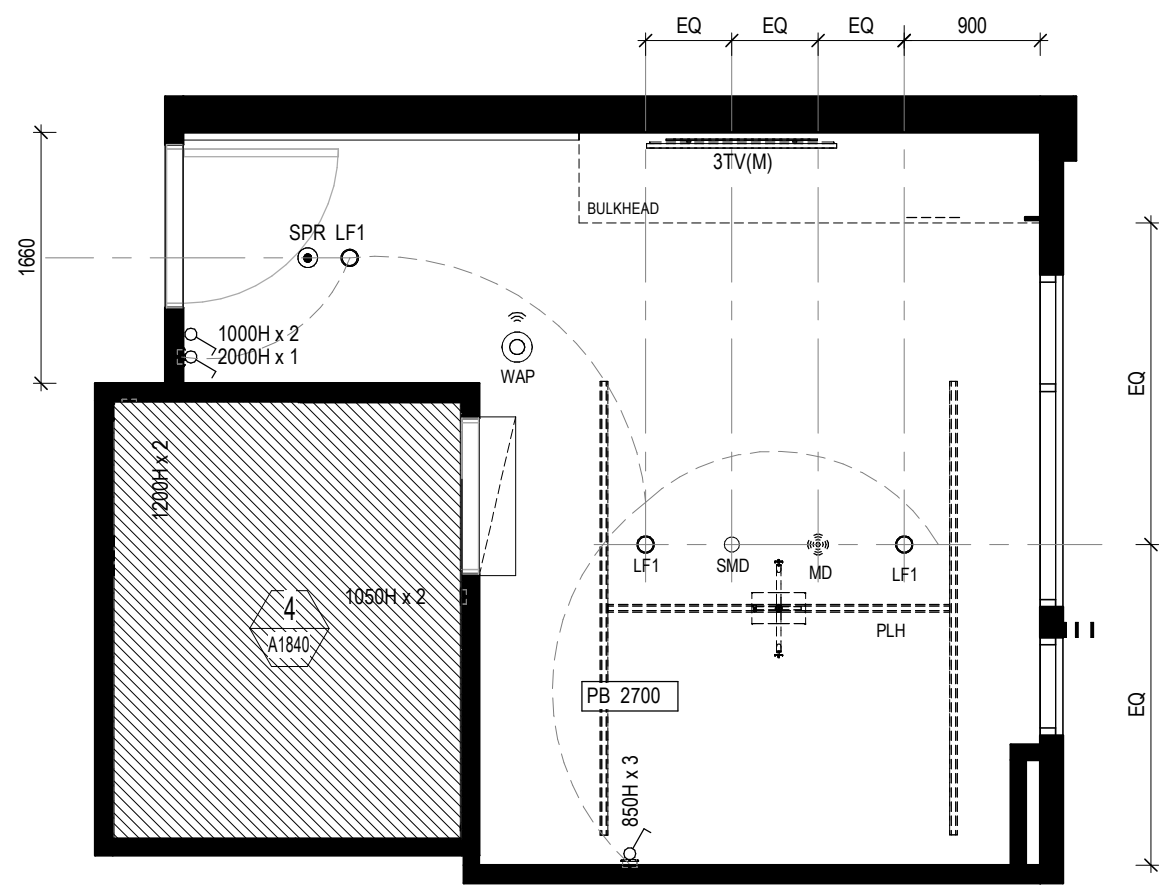

2 RCP - ACCESSIBLE BEDROOM


Scale 1 : 50

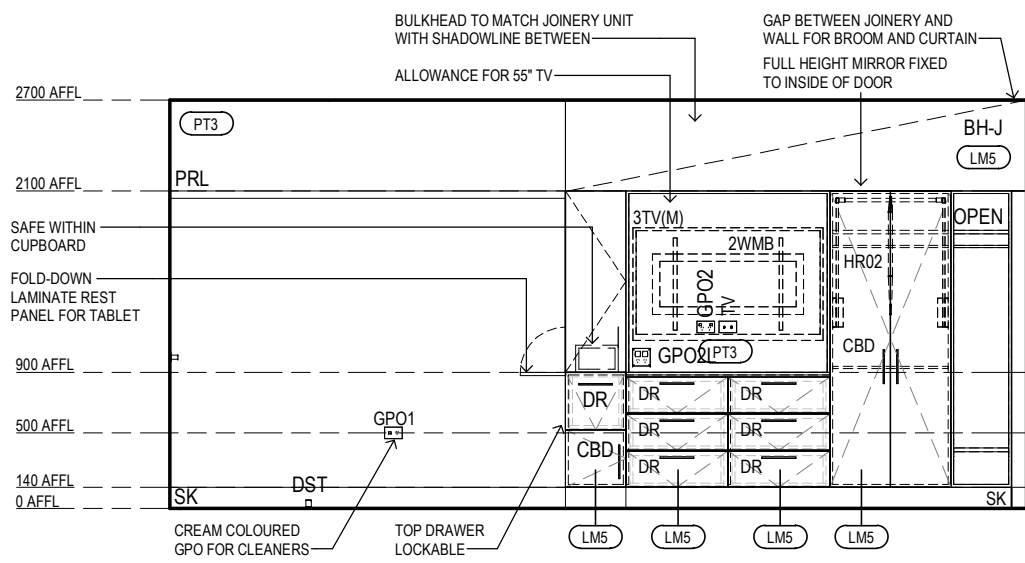

RACF - ACCESSIBLE BEDROOM

ELEVATION 1


Scale 1 : 50

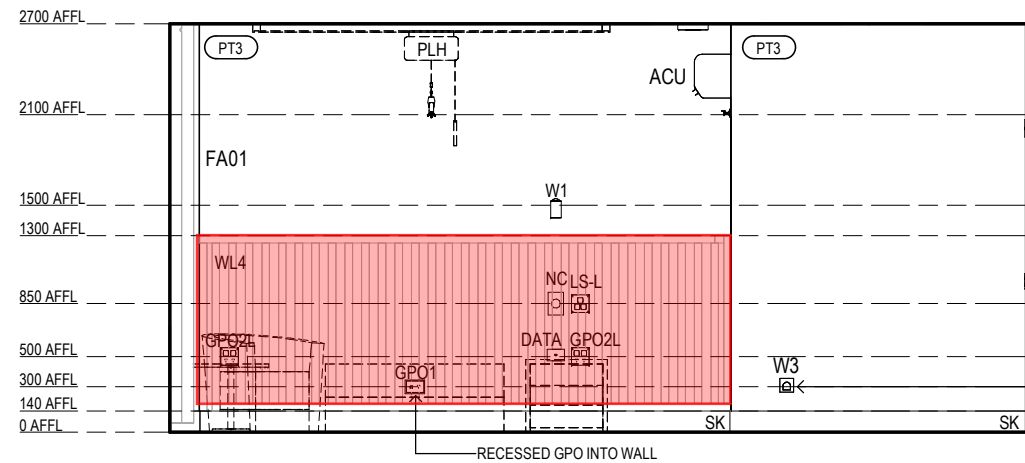

RACF - ACCESSIBLE BEDROOM

ELEVATION 3


Scale 1 : 50

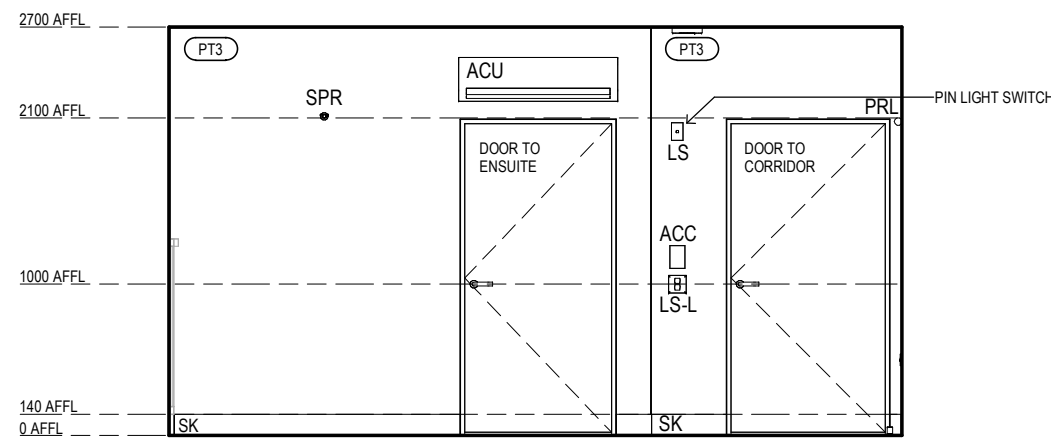

RACF - ACCESSIBLE BEDROOM

ELEVATION 2

Scale 1 : 50

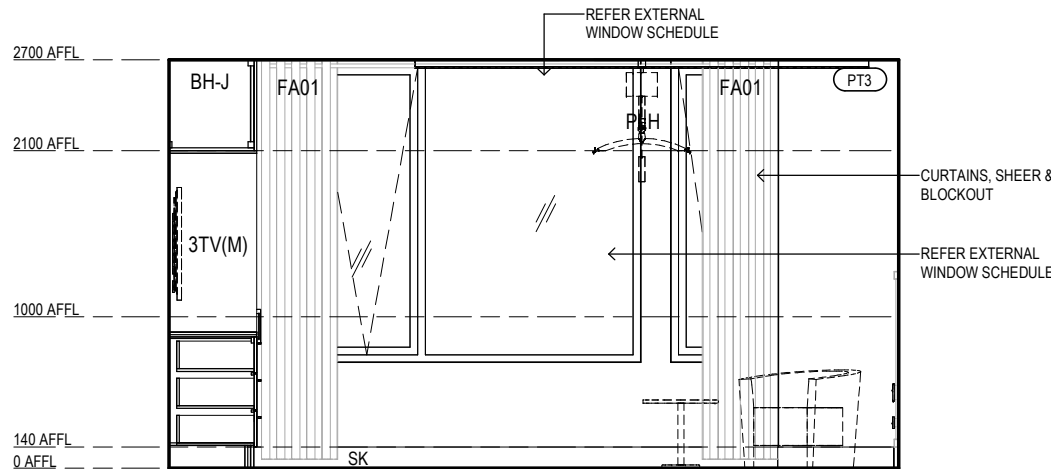

RACF - ACCESSIBLE BEDROOM

ELEVATION 4

Scale 1 : 50